



0023 - 061

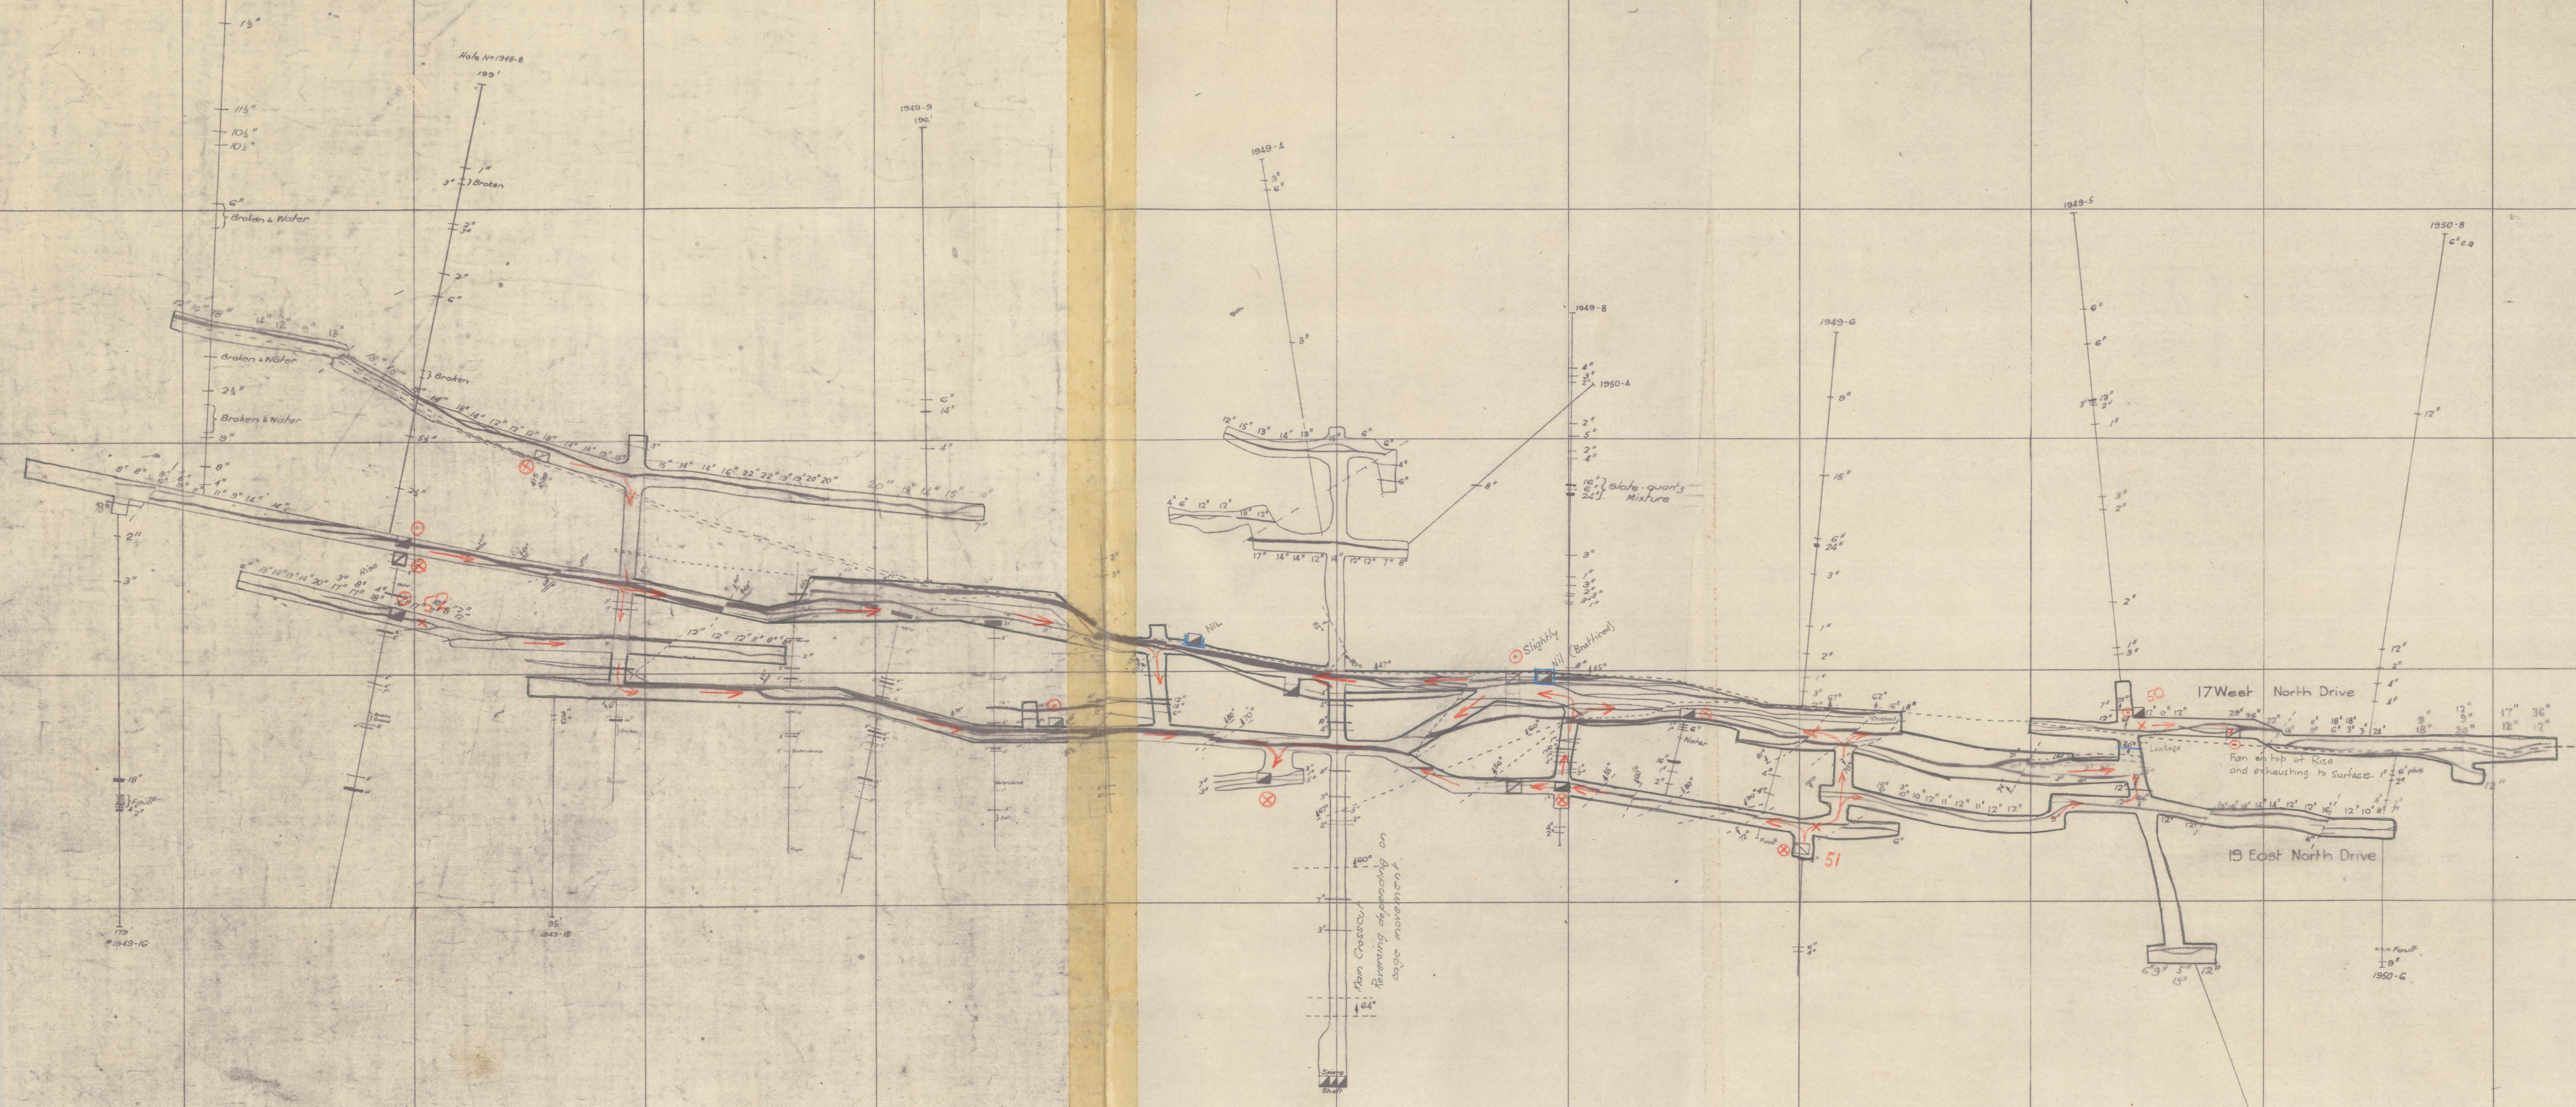

- ☐ Rise to level above
- ☐ Rise from level below
- ⊕ UPCAST
- ⊗ DOWNCAST
- Stopping
- X 51. Station

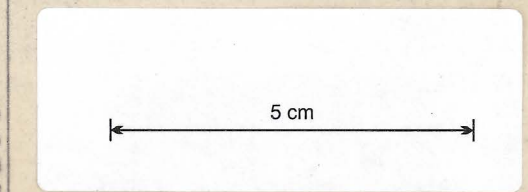

ABERFOYLE TIN N.L.	
No. 5 LEVEL	
DRAWN D. Lello	SCALE 1" = 30'
TRACED D. Lello	PLAN No.
DATE	