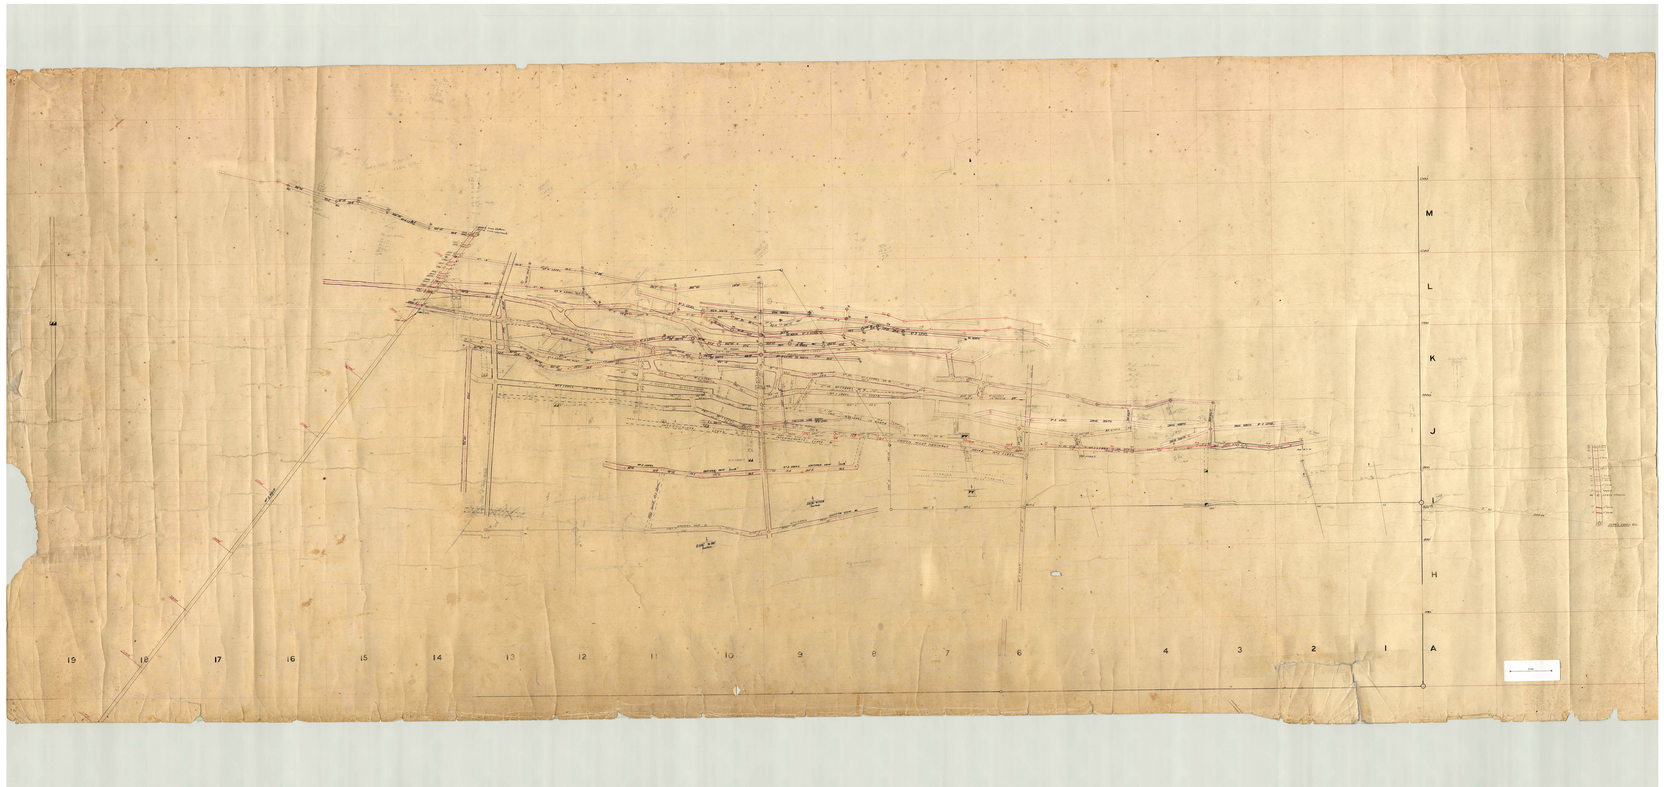
M
L
K
J
H
A
15
18
17
16
15
14
13
12
11
10
9
8
7
6
5
4
3
2
1