


5 cm

NIKE M. CO. N.L.

SCALE — 40 FEET TO ONE INCH —

Showing Extensions to 31st Dec. 1920

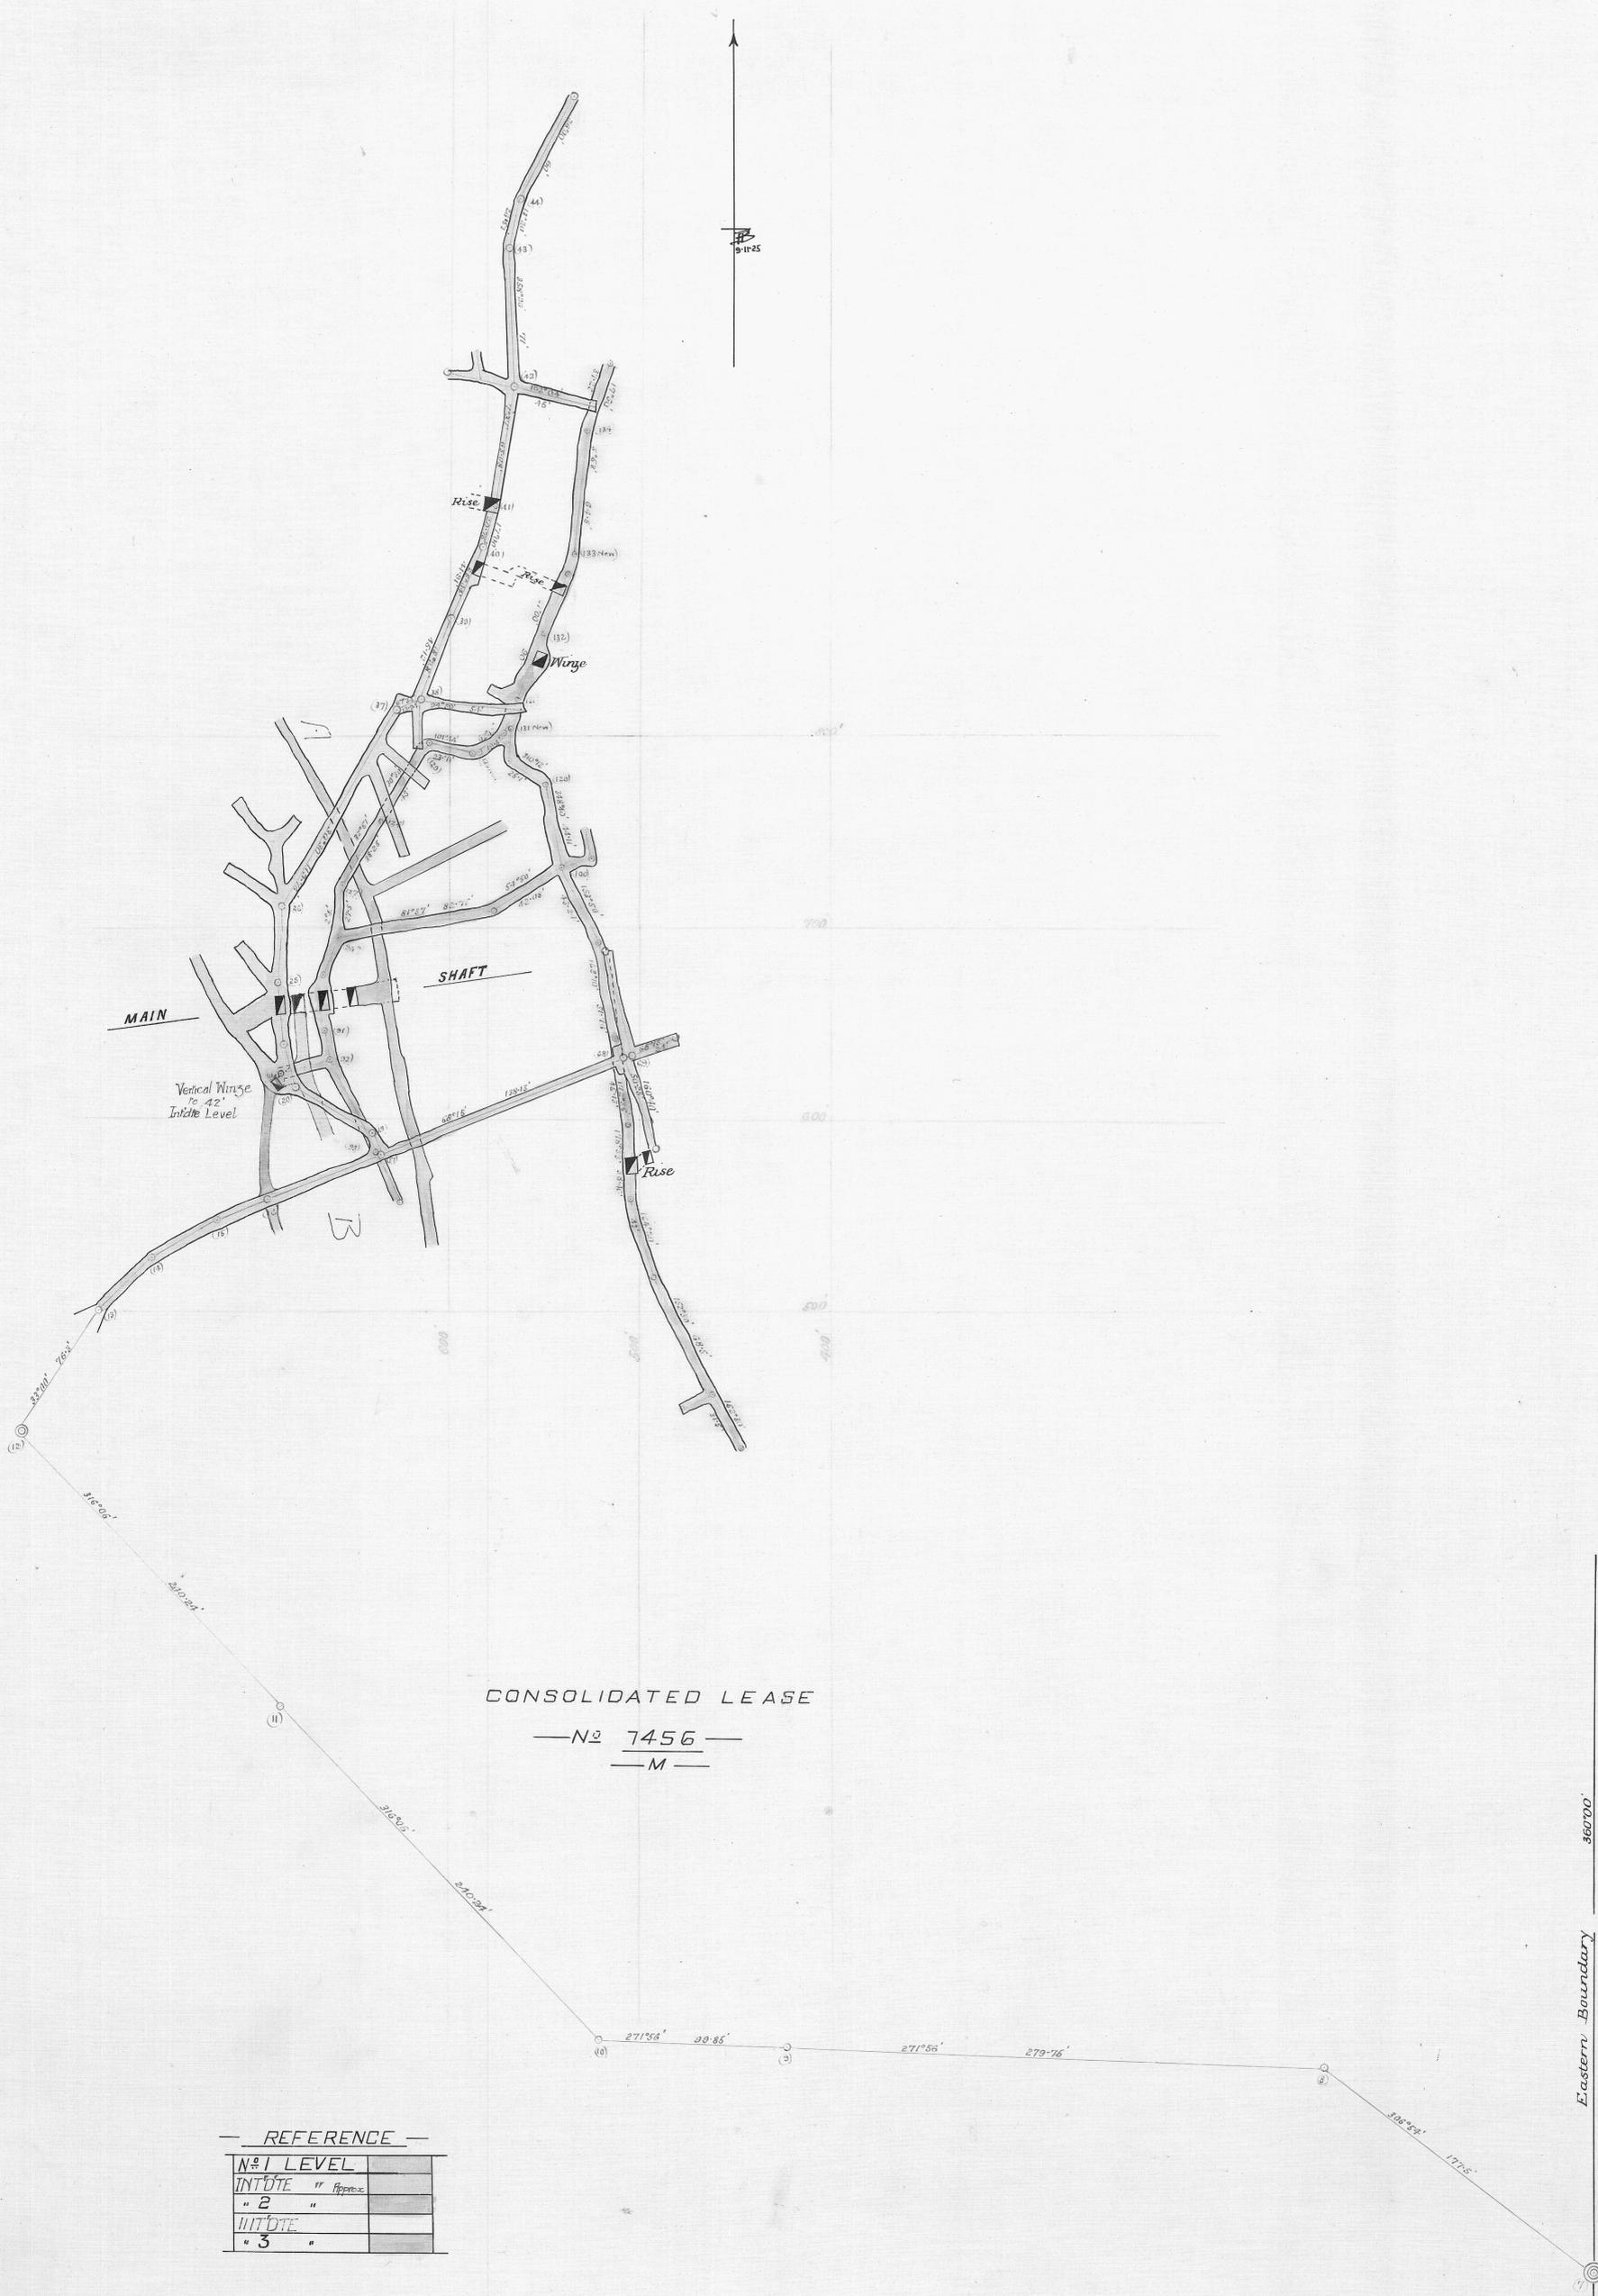

CONSOLIDATED LEASE

Nº 7456
M

REFERENCE

Nº 1 LEVEL	
INT'DE " 1"	Approx.
" 2 "	
INT'DE " 3 "	

Eastern Boundary 3600'