0027_007

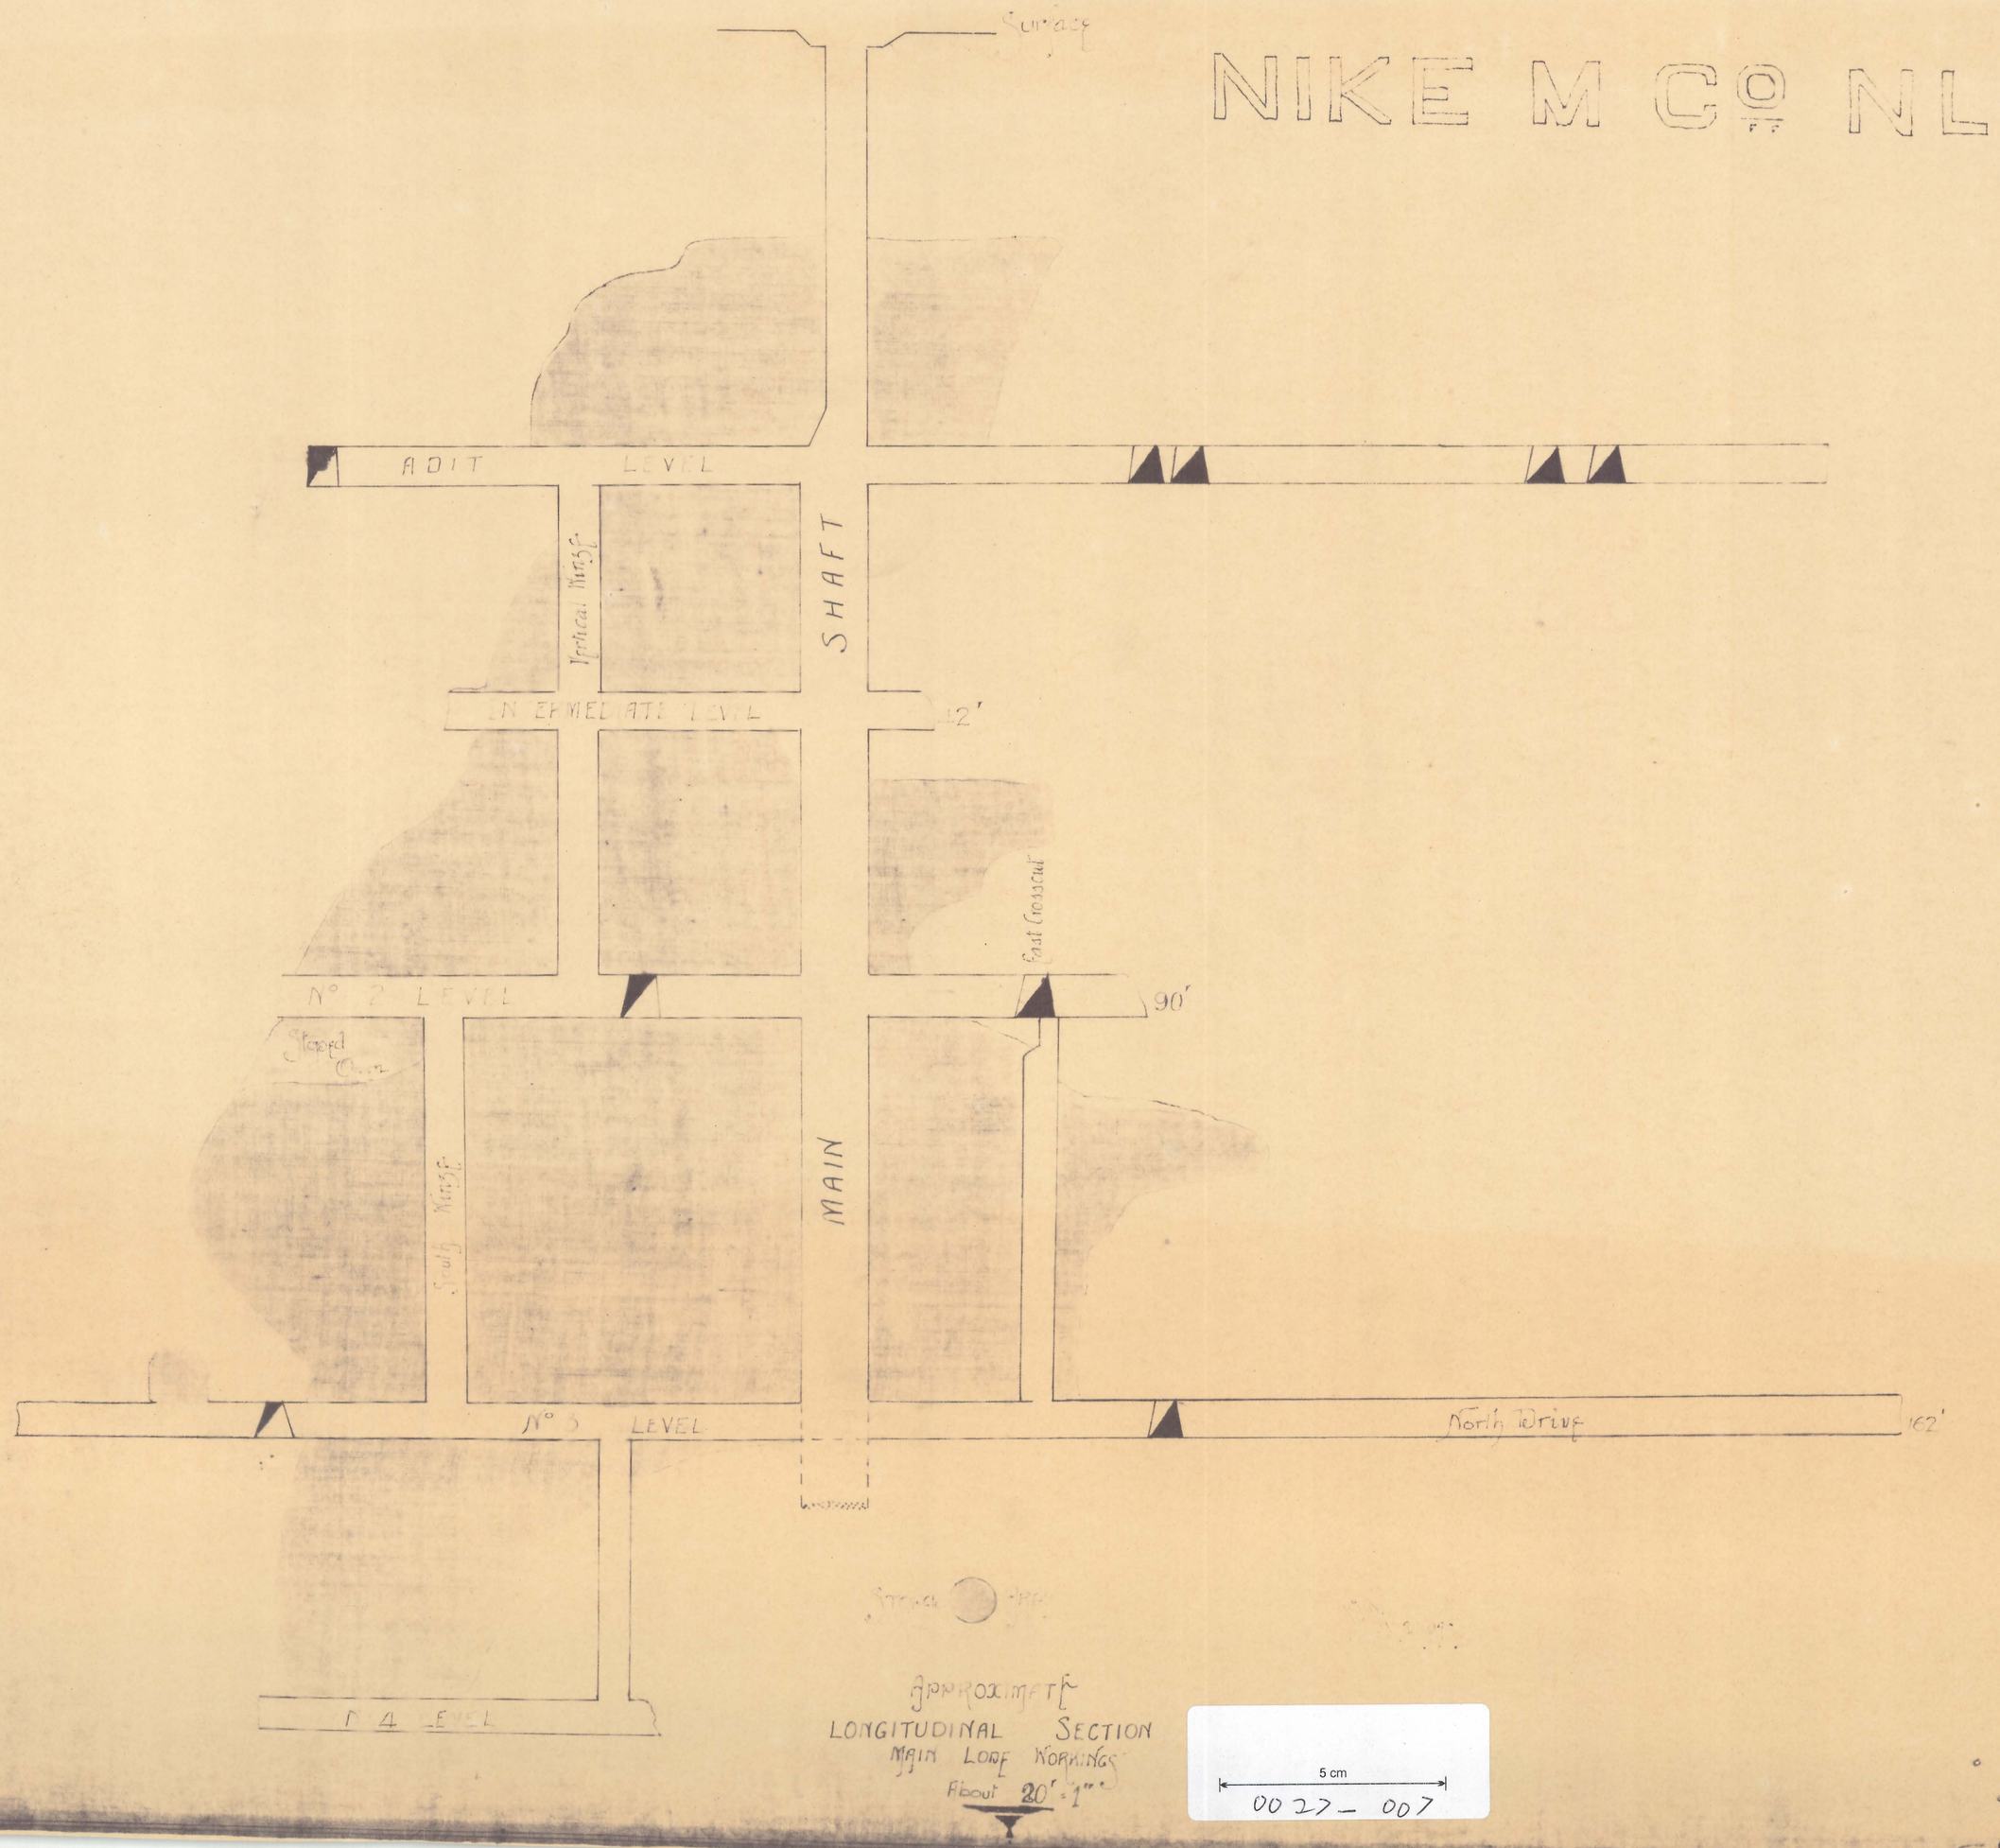

APPROXIMATE
LONGITUDINAL SECTION
MAIN LODE WORKINGS
About 20' = 1"

5 cm
0027_007