28-03

5 cm

PLAN OF S.E. CORNER OF
COPPER REWARD CLAIM
Mt BALFOUR

Scale 1" to 40'

Instrument Used 5" Y Theodolite

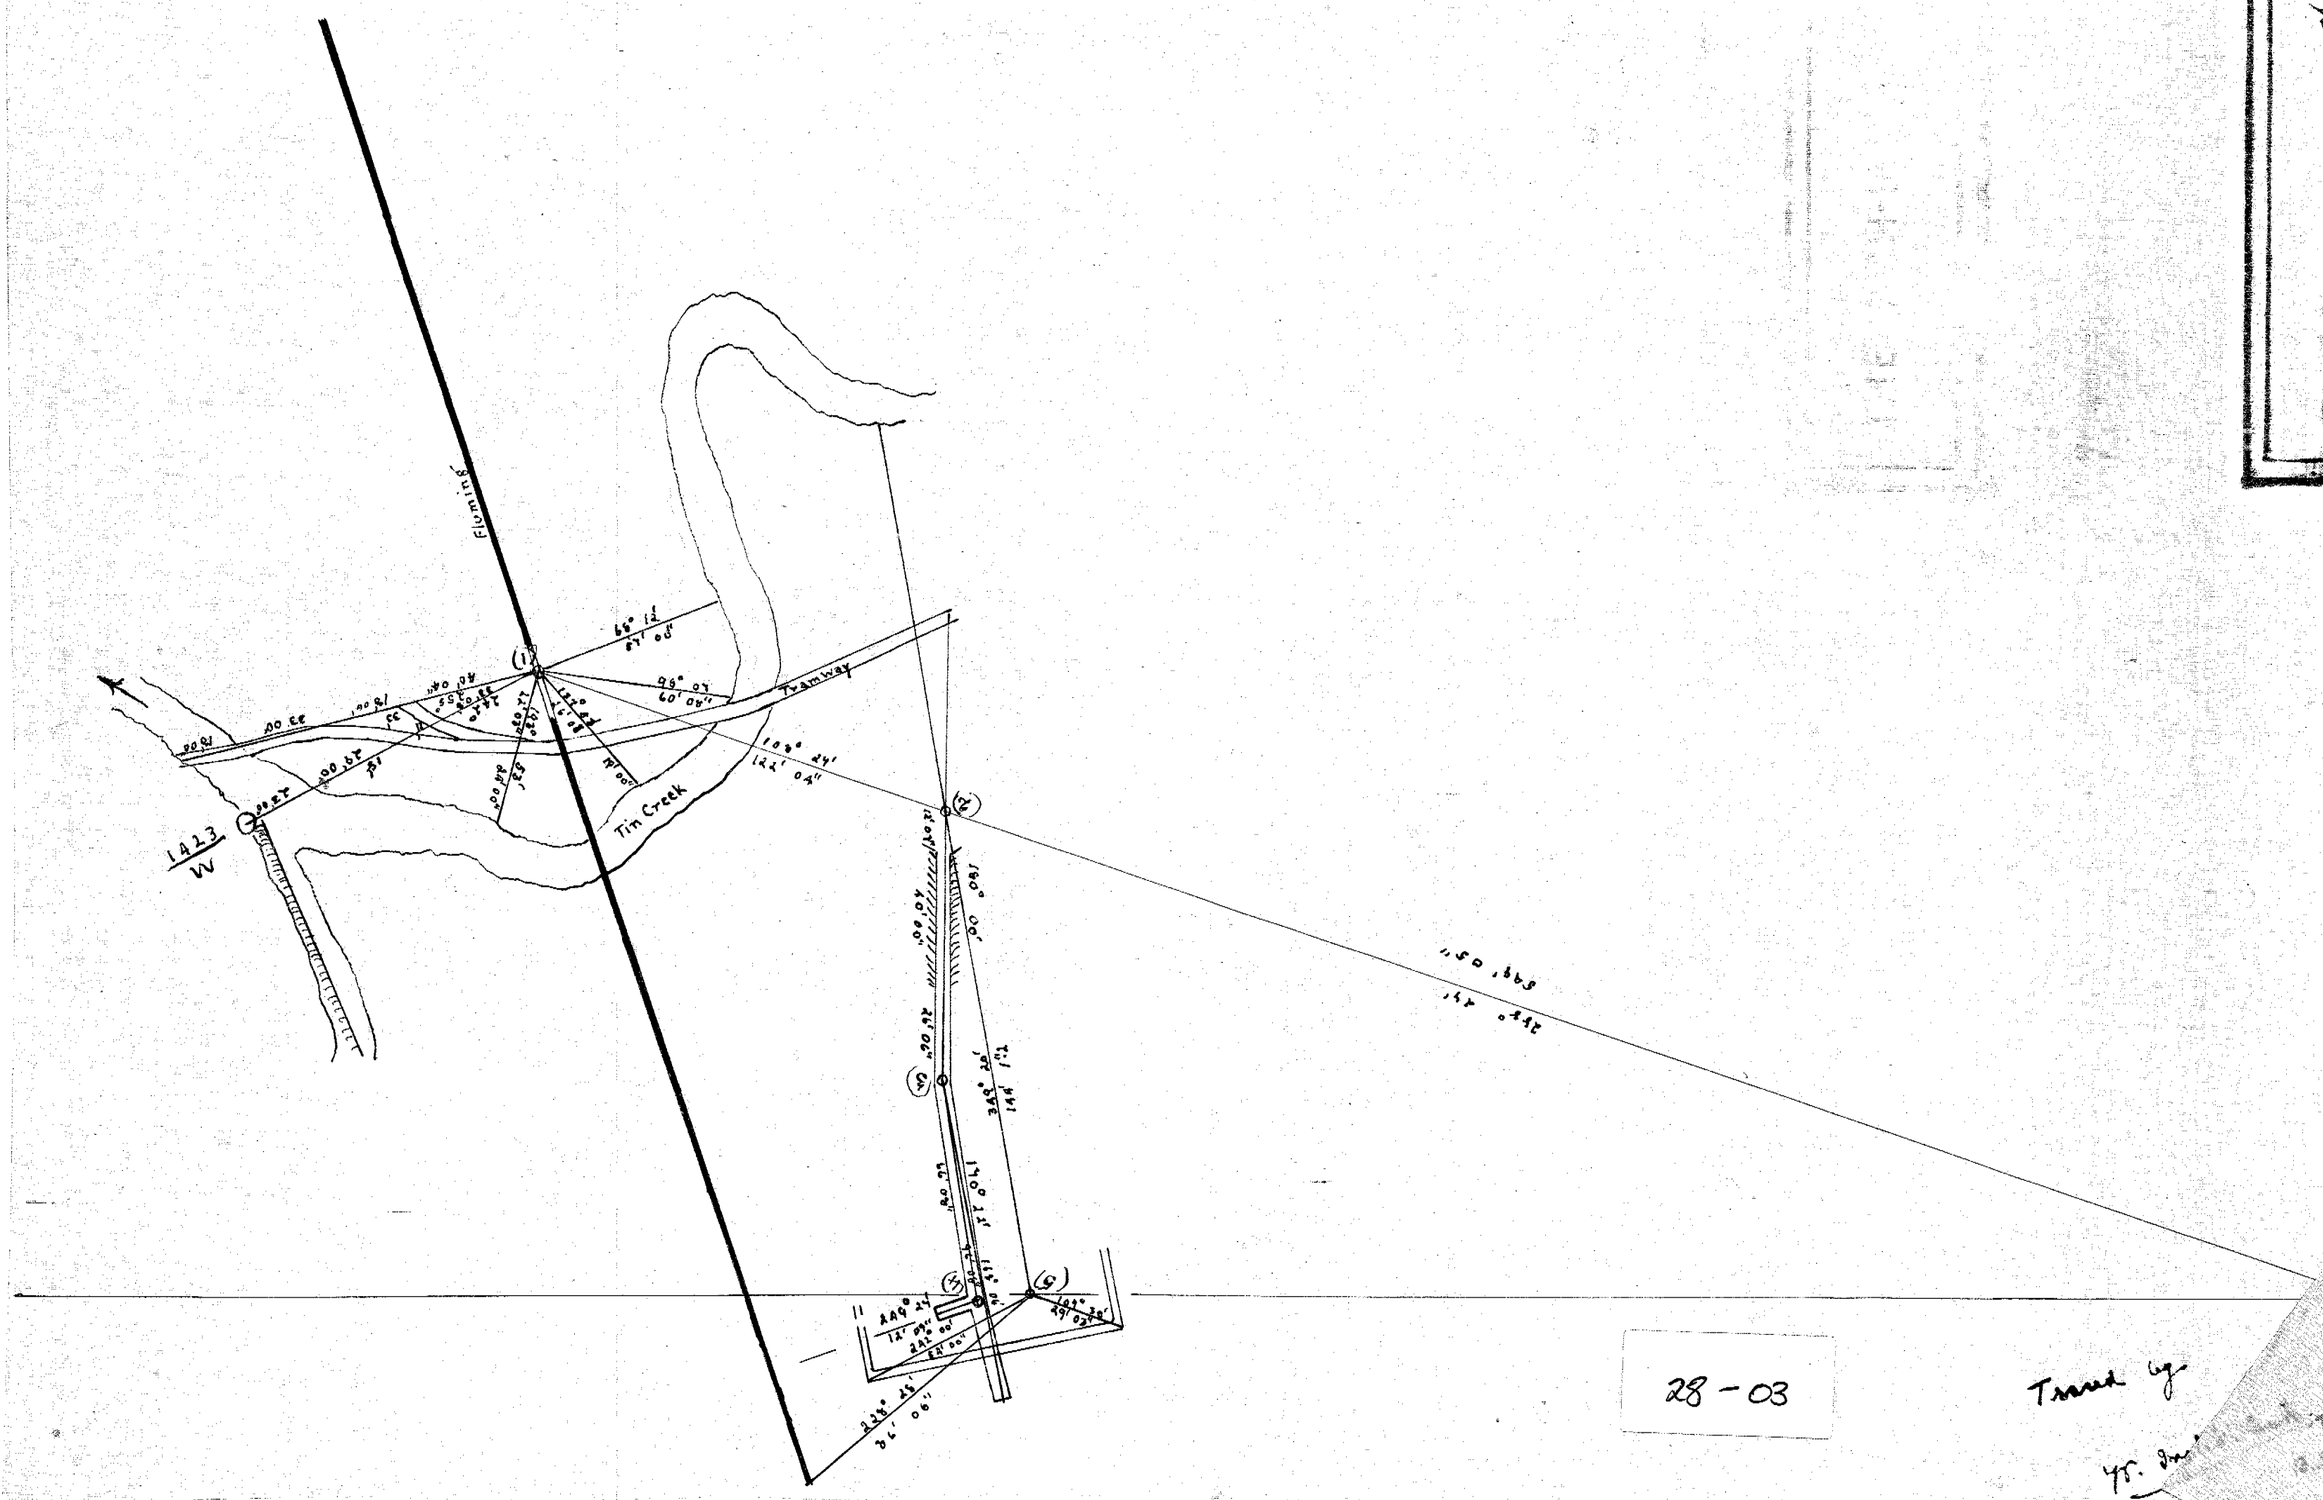

28 - 03

Traced by

THE "KOH-I-NOOR" TRACING CLOTH
8 7 1901