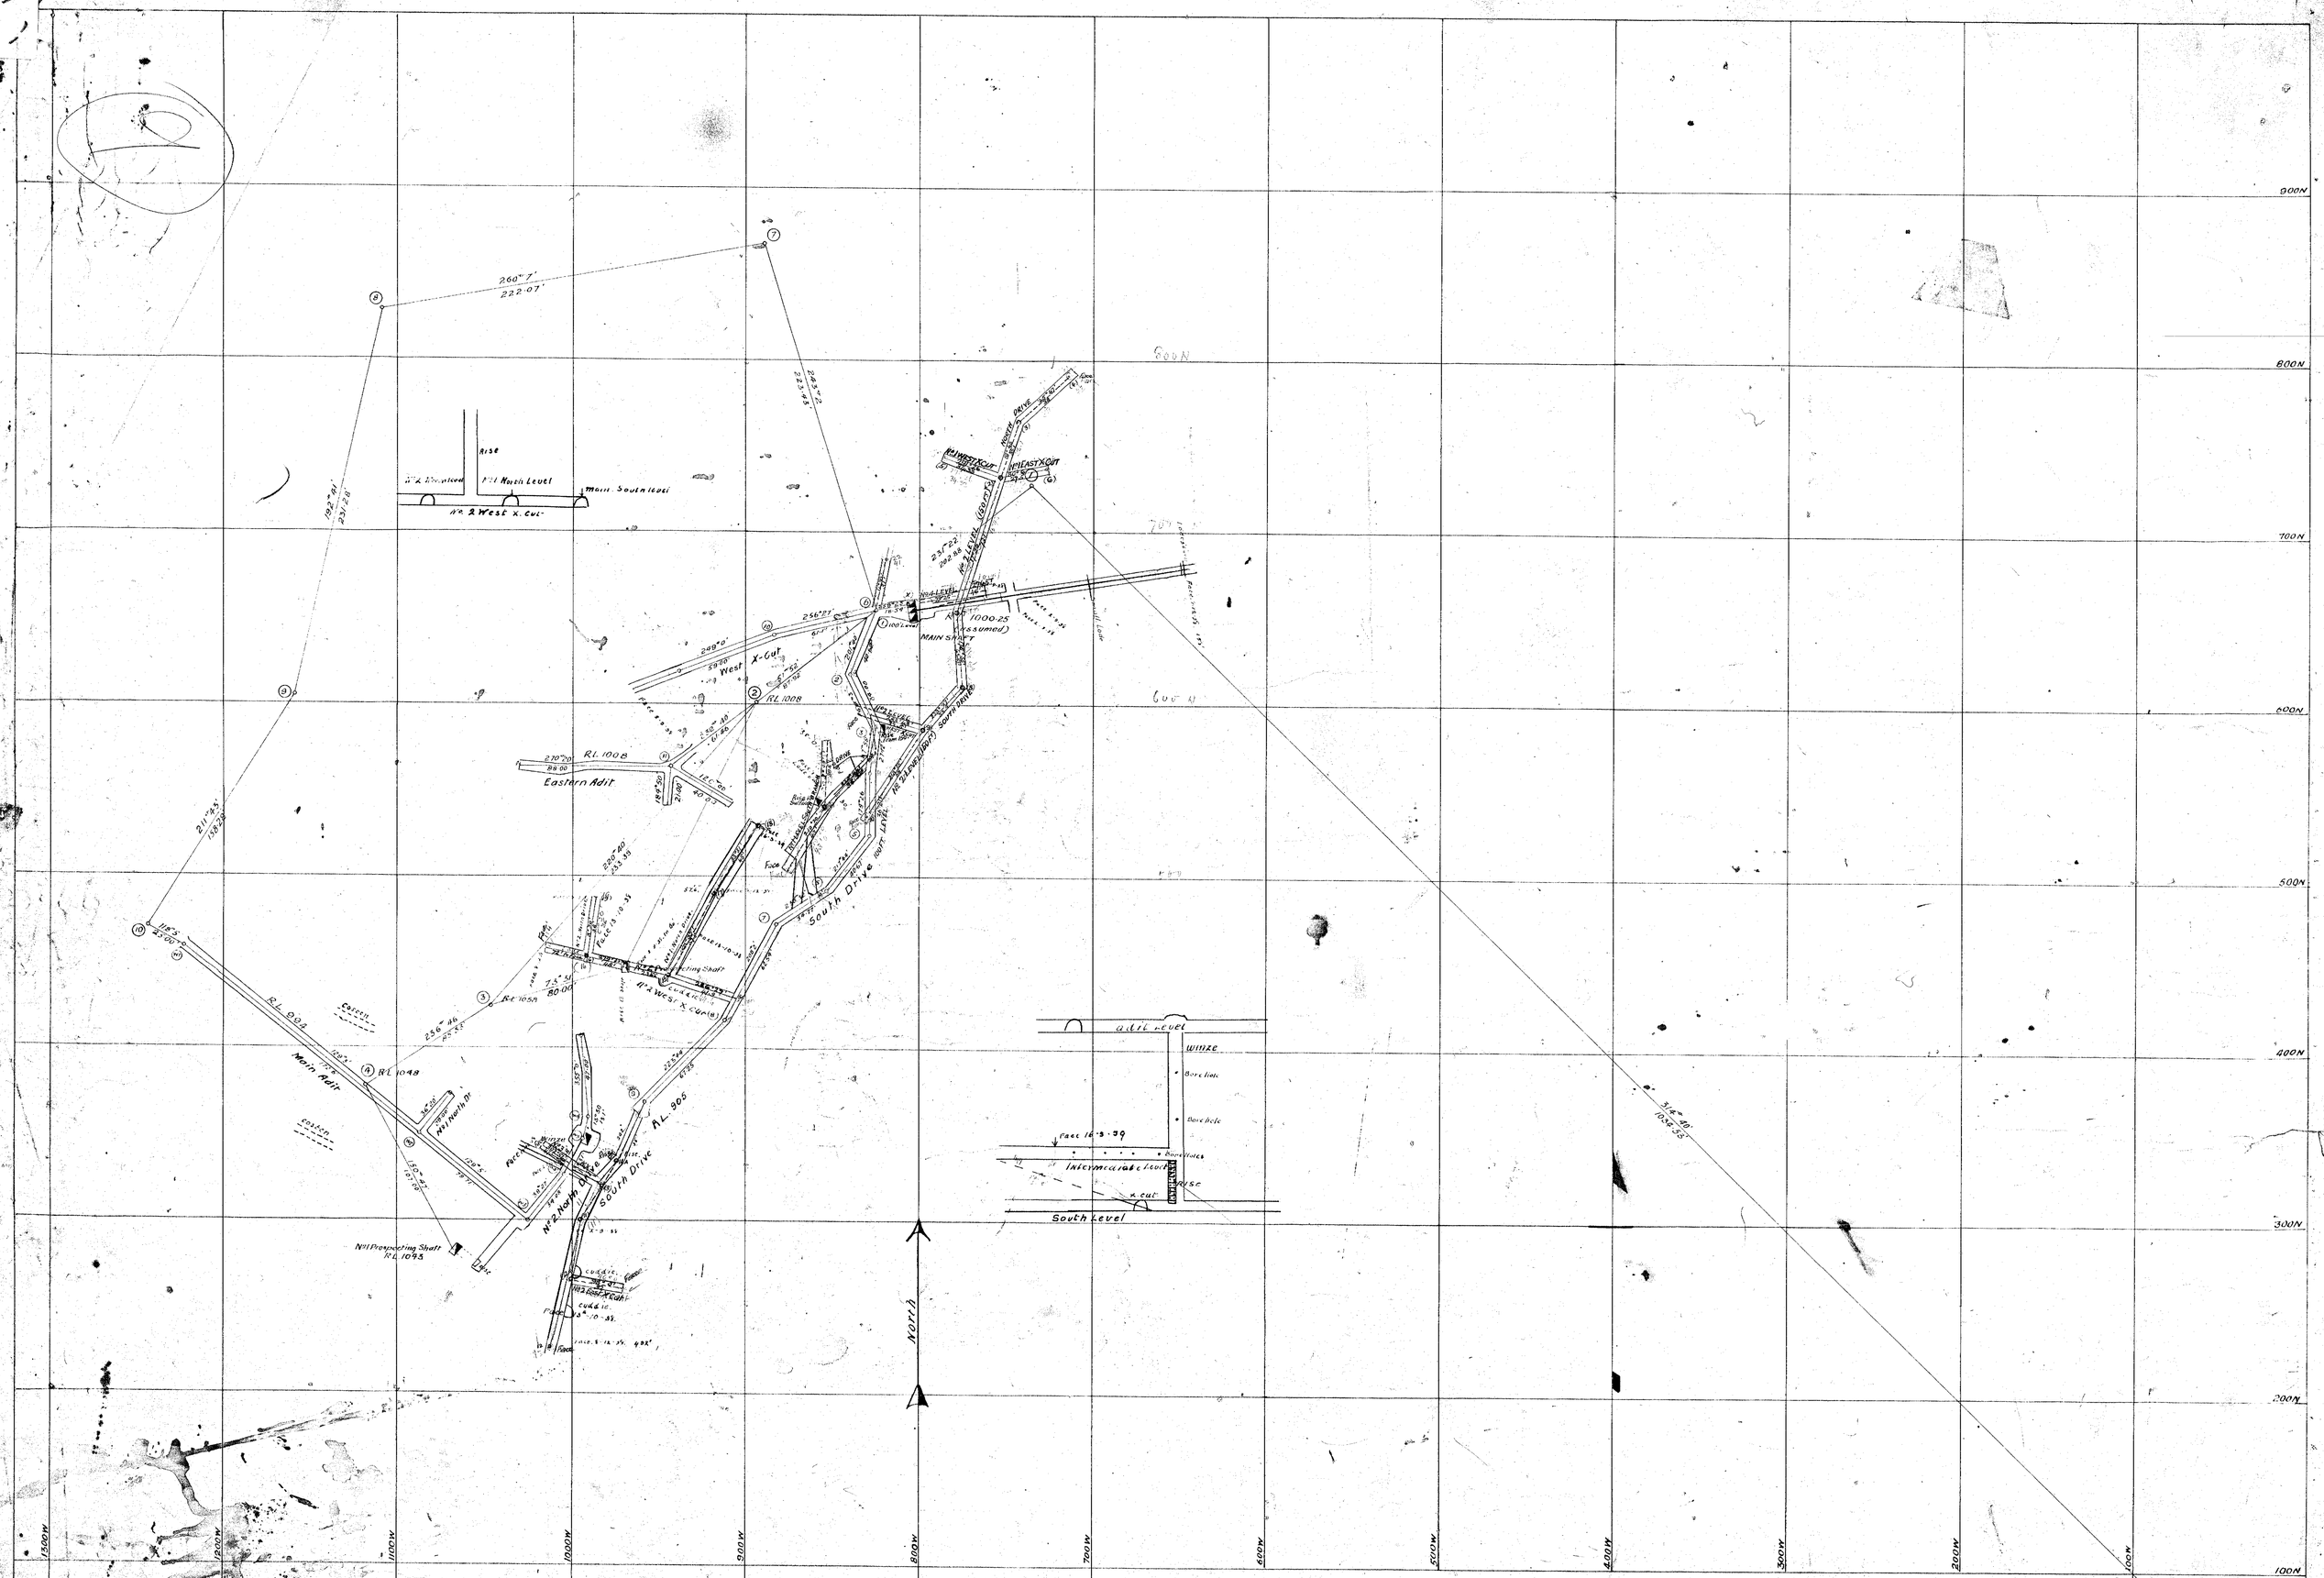
MONTANA SILVER LEAD
Underground Workings 1938
Scale = 1 Inch = 40'.
Work from 1-7-38 to 23-1-41, Shown in Blue
Instrument used 5" Theodolite
29-01
Surveyor
Date
North
Eastern Adit
Main Adit
South Drive
West X-Cut
MAIN SHAFT
1000.25 (assumed)
No 2 West X Cut
No 2 North Dr
No 1 Prospecting Shaft
R.L. 1008
R.L. 1048
R.L. 906
R.L. 1093
Rise
No 1 North Level
Main South level
No 2 West X. Cut
adit level
winze
Bore hole
Intermediate level
South Level
Face 16-3-39
900N
800N
700N
600N
500N
400N
300N
200N
100N
1300W
1200W
1100W
1000W
900W
800W
700W
600W
500W
400W
300W
200W
100W