30-04

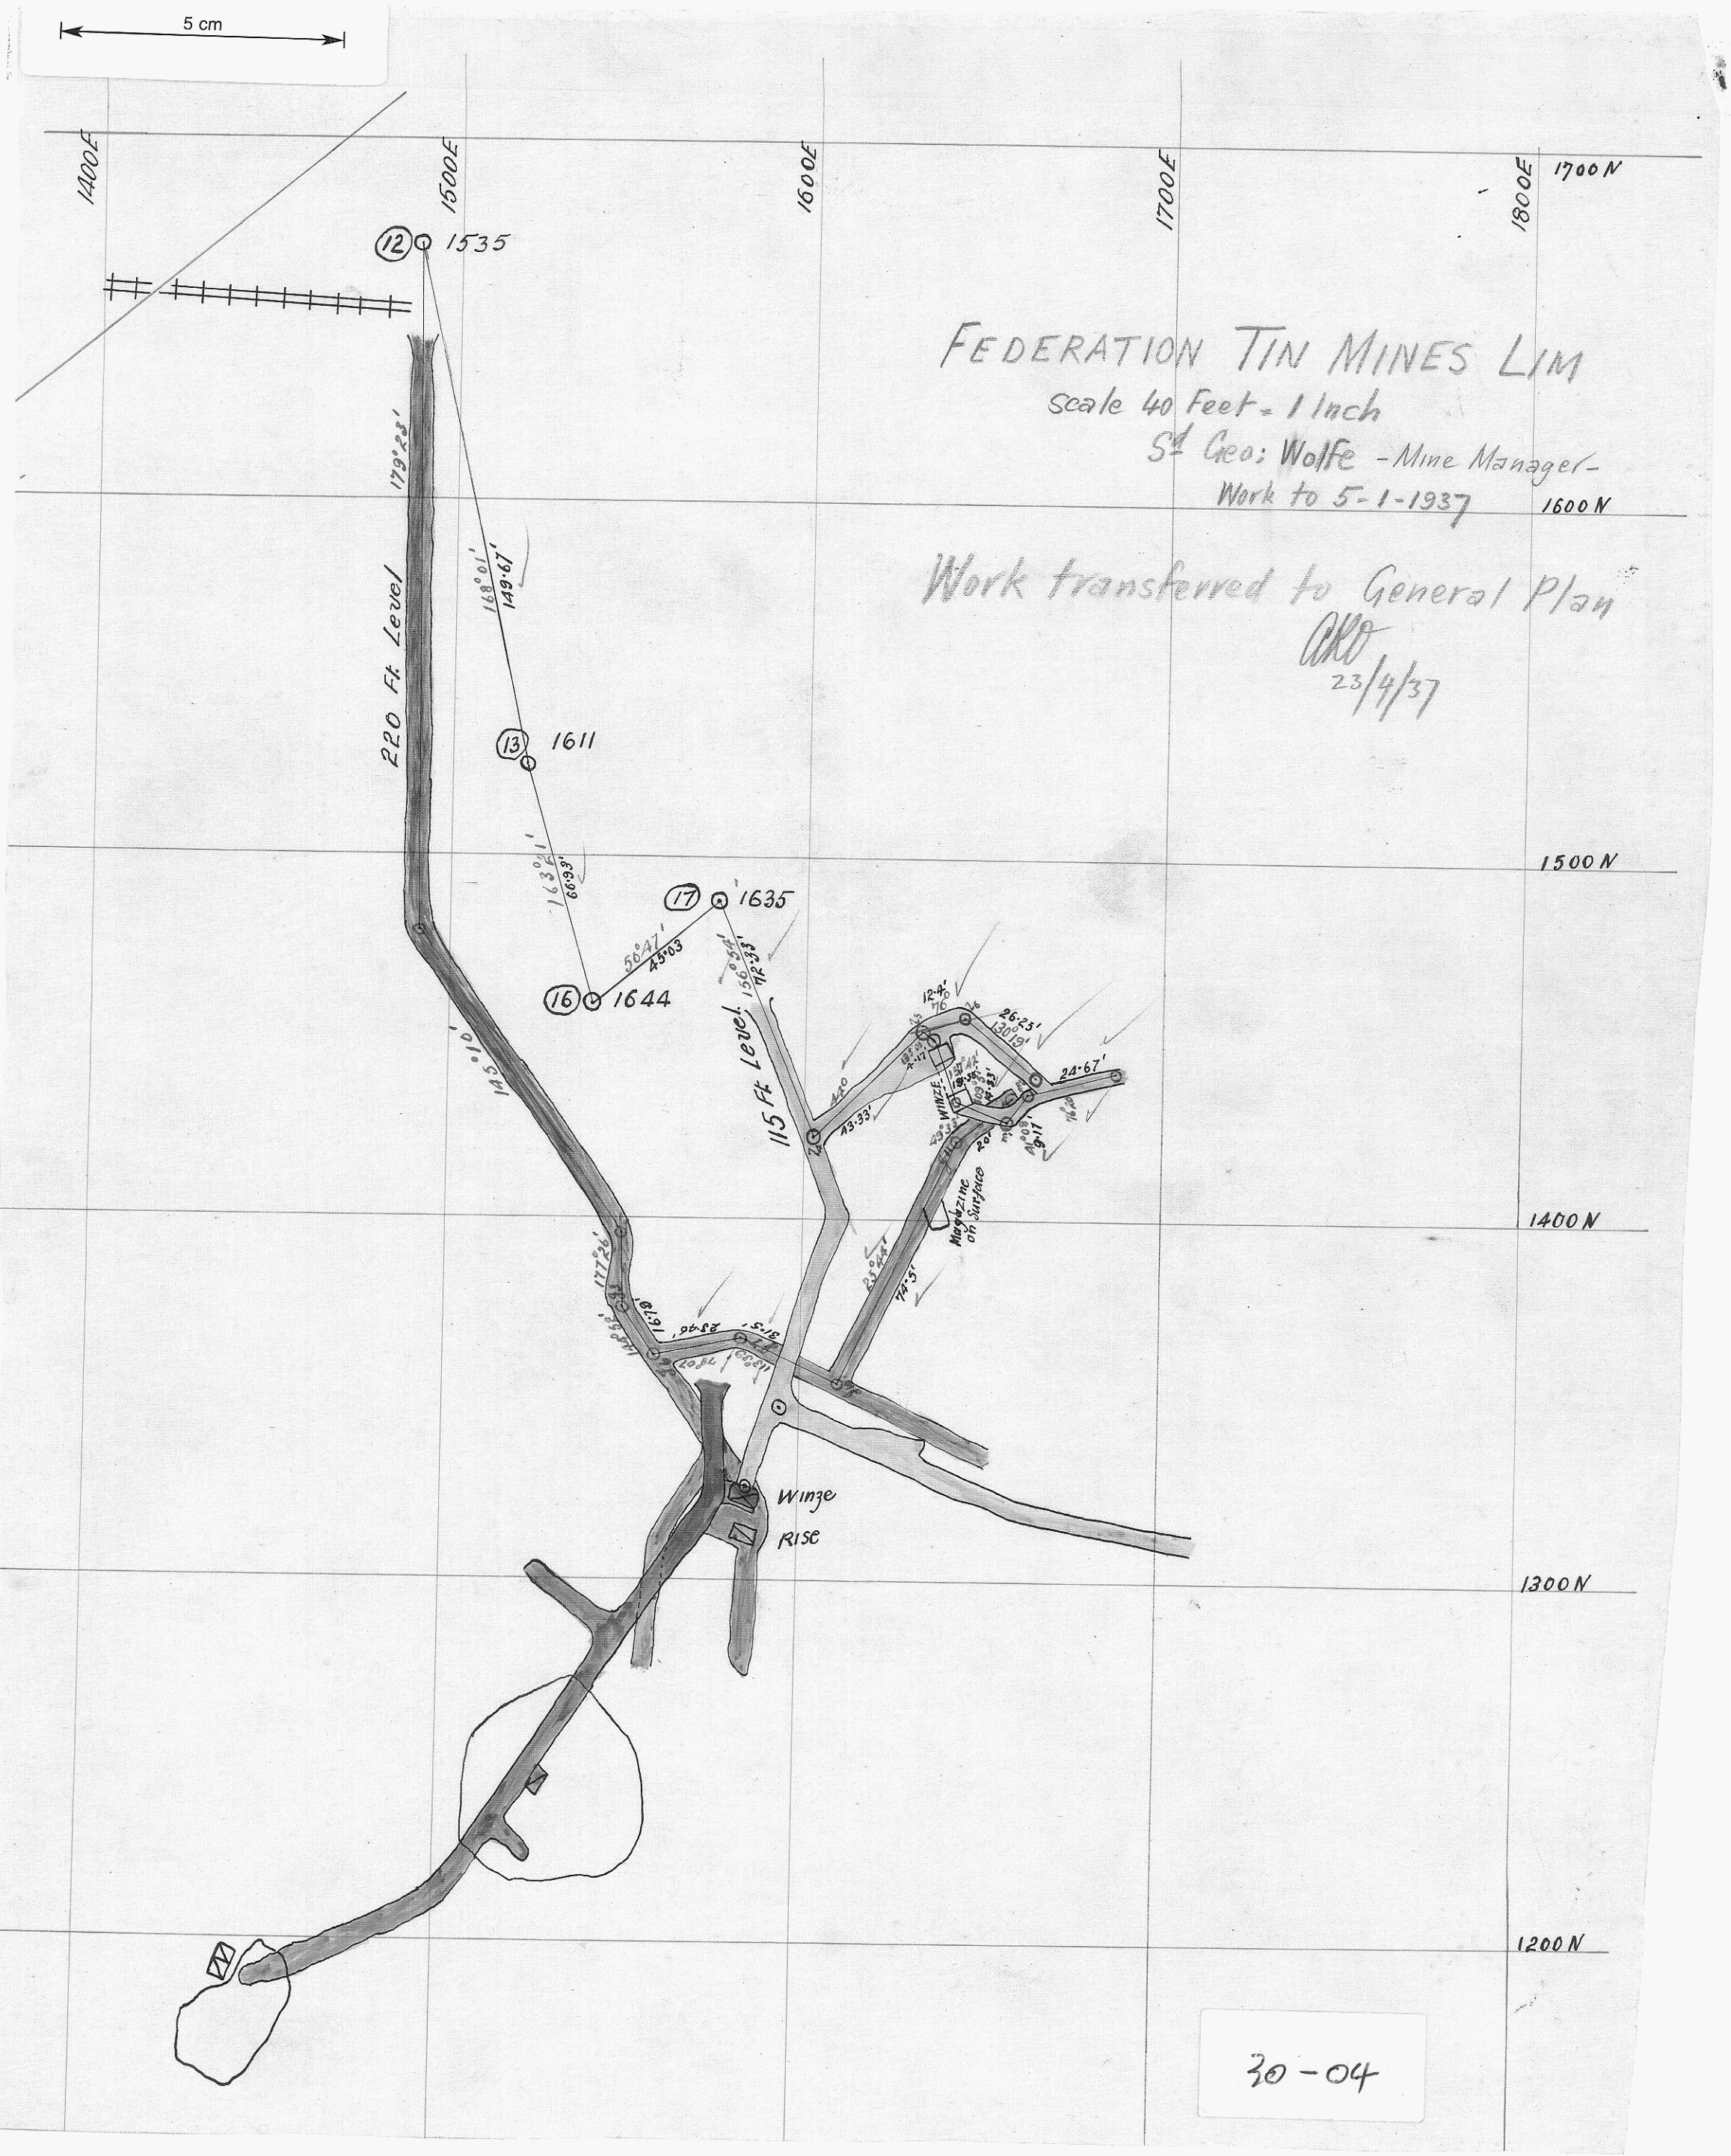
5 cm
1400E
1500E
1600E
1700E
1800E
1700N
1600N
1500N
1400N
1300N
1200N
12 1535
13 1611
16 1644
17 1635
220 Ft. Level
115 Ft. Level
179°28'
149.67'
148°01'
66.93'
163°21'
45°03
56°47'
156°54'
145°10'
177°26'
43.33'
24.67'
26.23'
30°19'
Magazine on Surface
Winze
Rise
FEDERATION TIN MINES LIM
Scale 40 Feet = 1 Inch
Sd Geo: Wolfe - Mine Manager -
Work to 5-1-1937
Work transferred to General Plan
23/4/37
30-04