


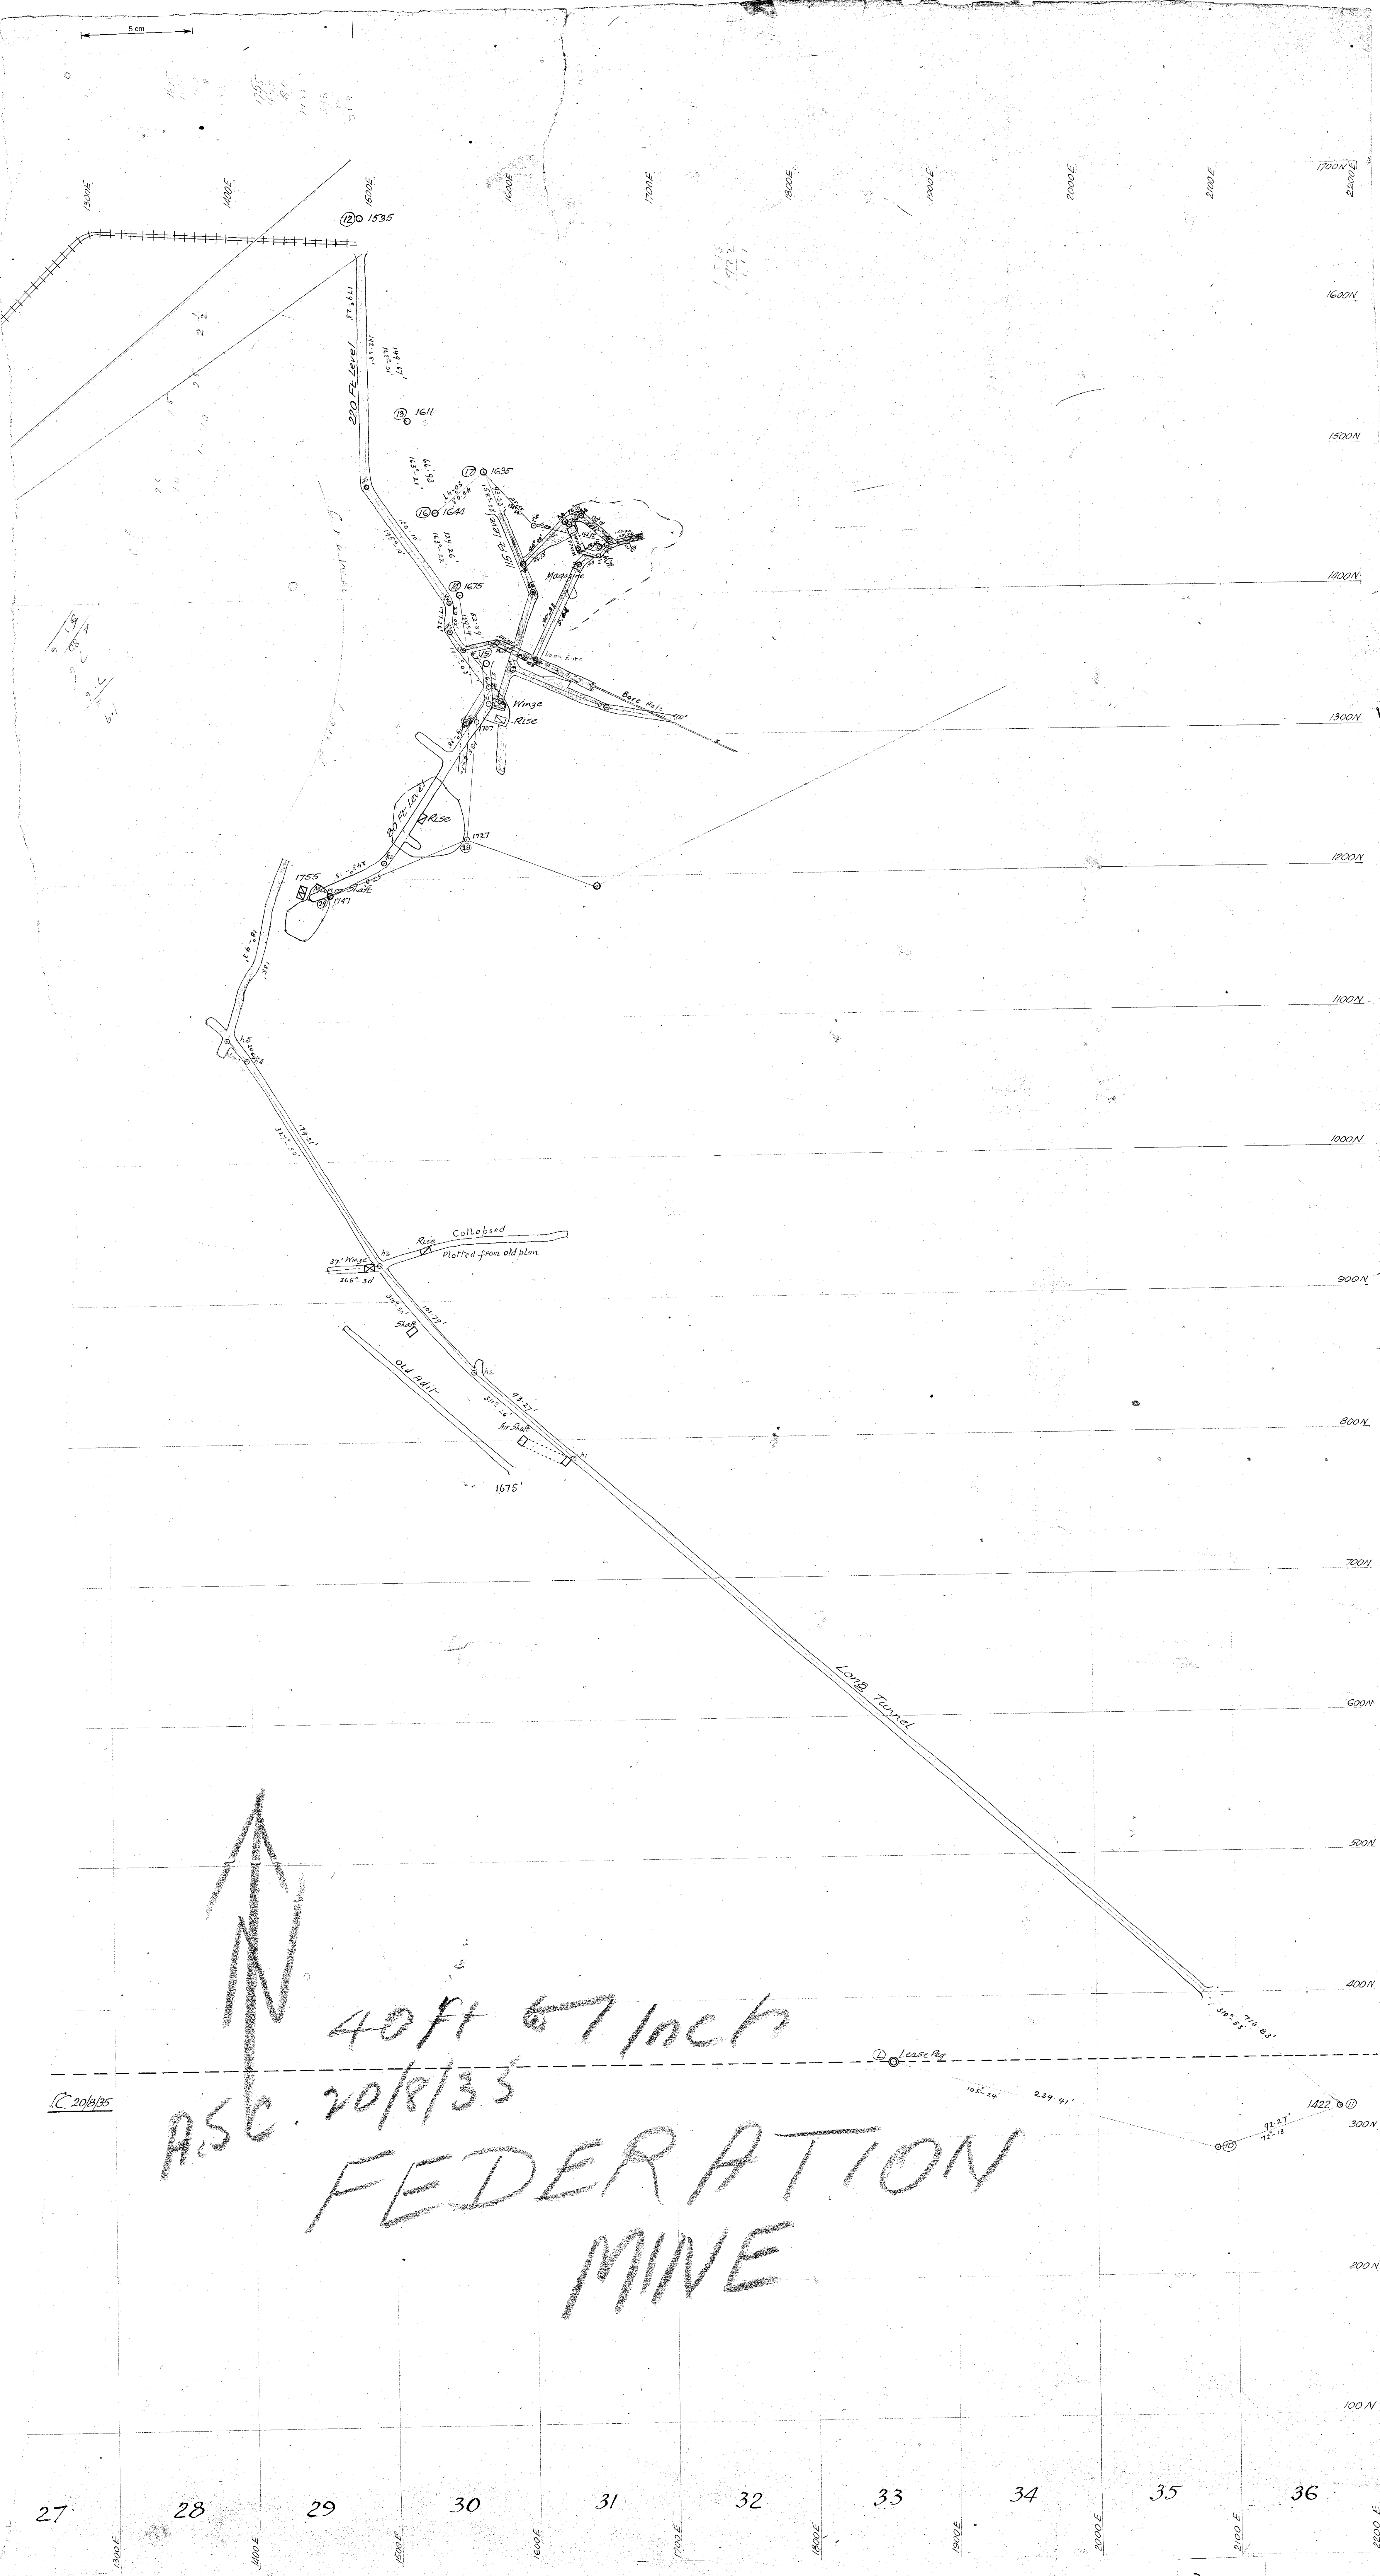

40 ft to 7 inch
ASC 20/8/35
FEDERATION
MINE