5 cm

COLEBROOK COAL MINE

40ft to an Inch

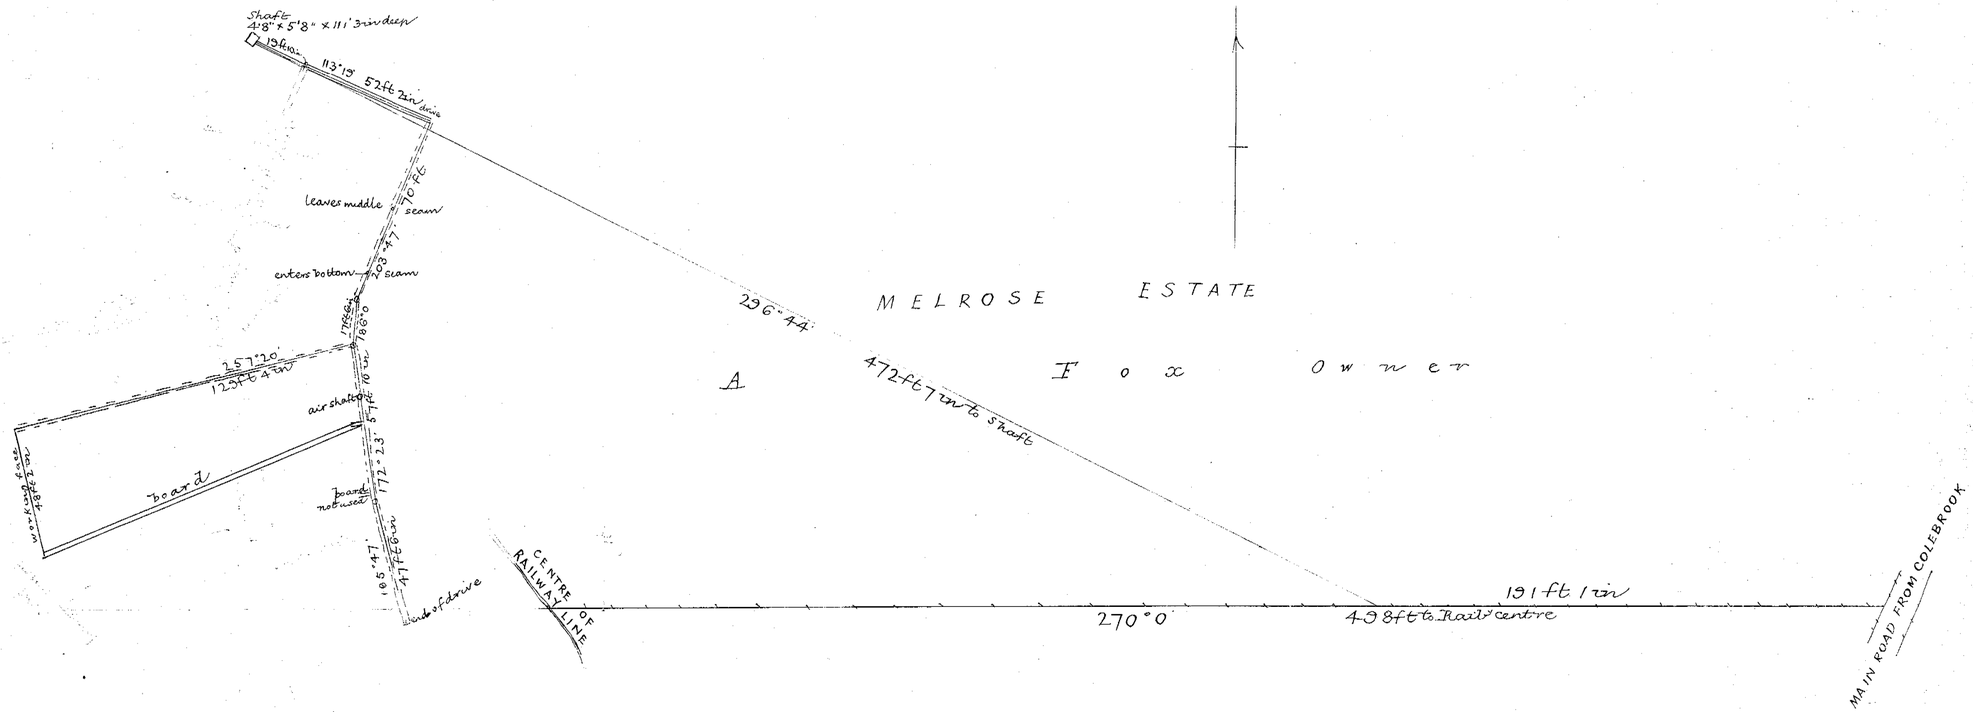

Ground worked between the long boards only.
vide letter No. 6113

31-01

C. Wood
Mining Surveyor
29/4/11