ABERDEEN COAL MINE.

SPREYTON. DEVON.

Scale 40' to 1".

Average Dip of Coal 270°.

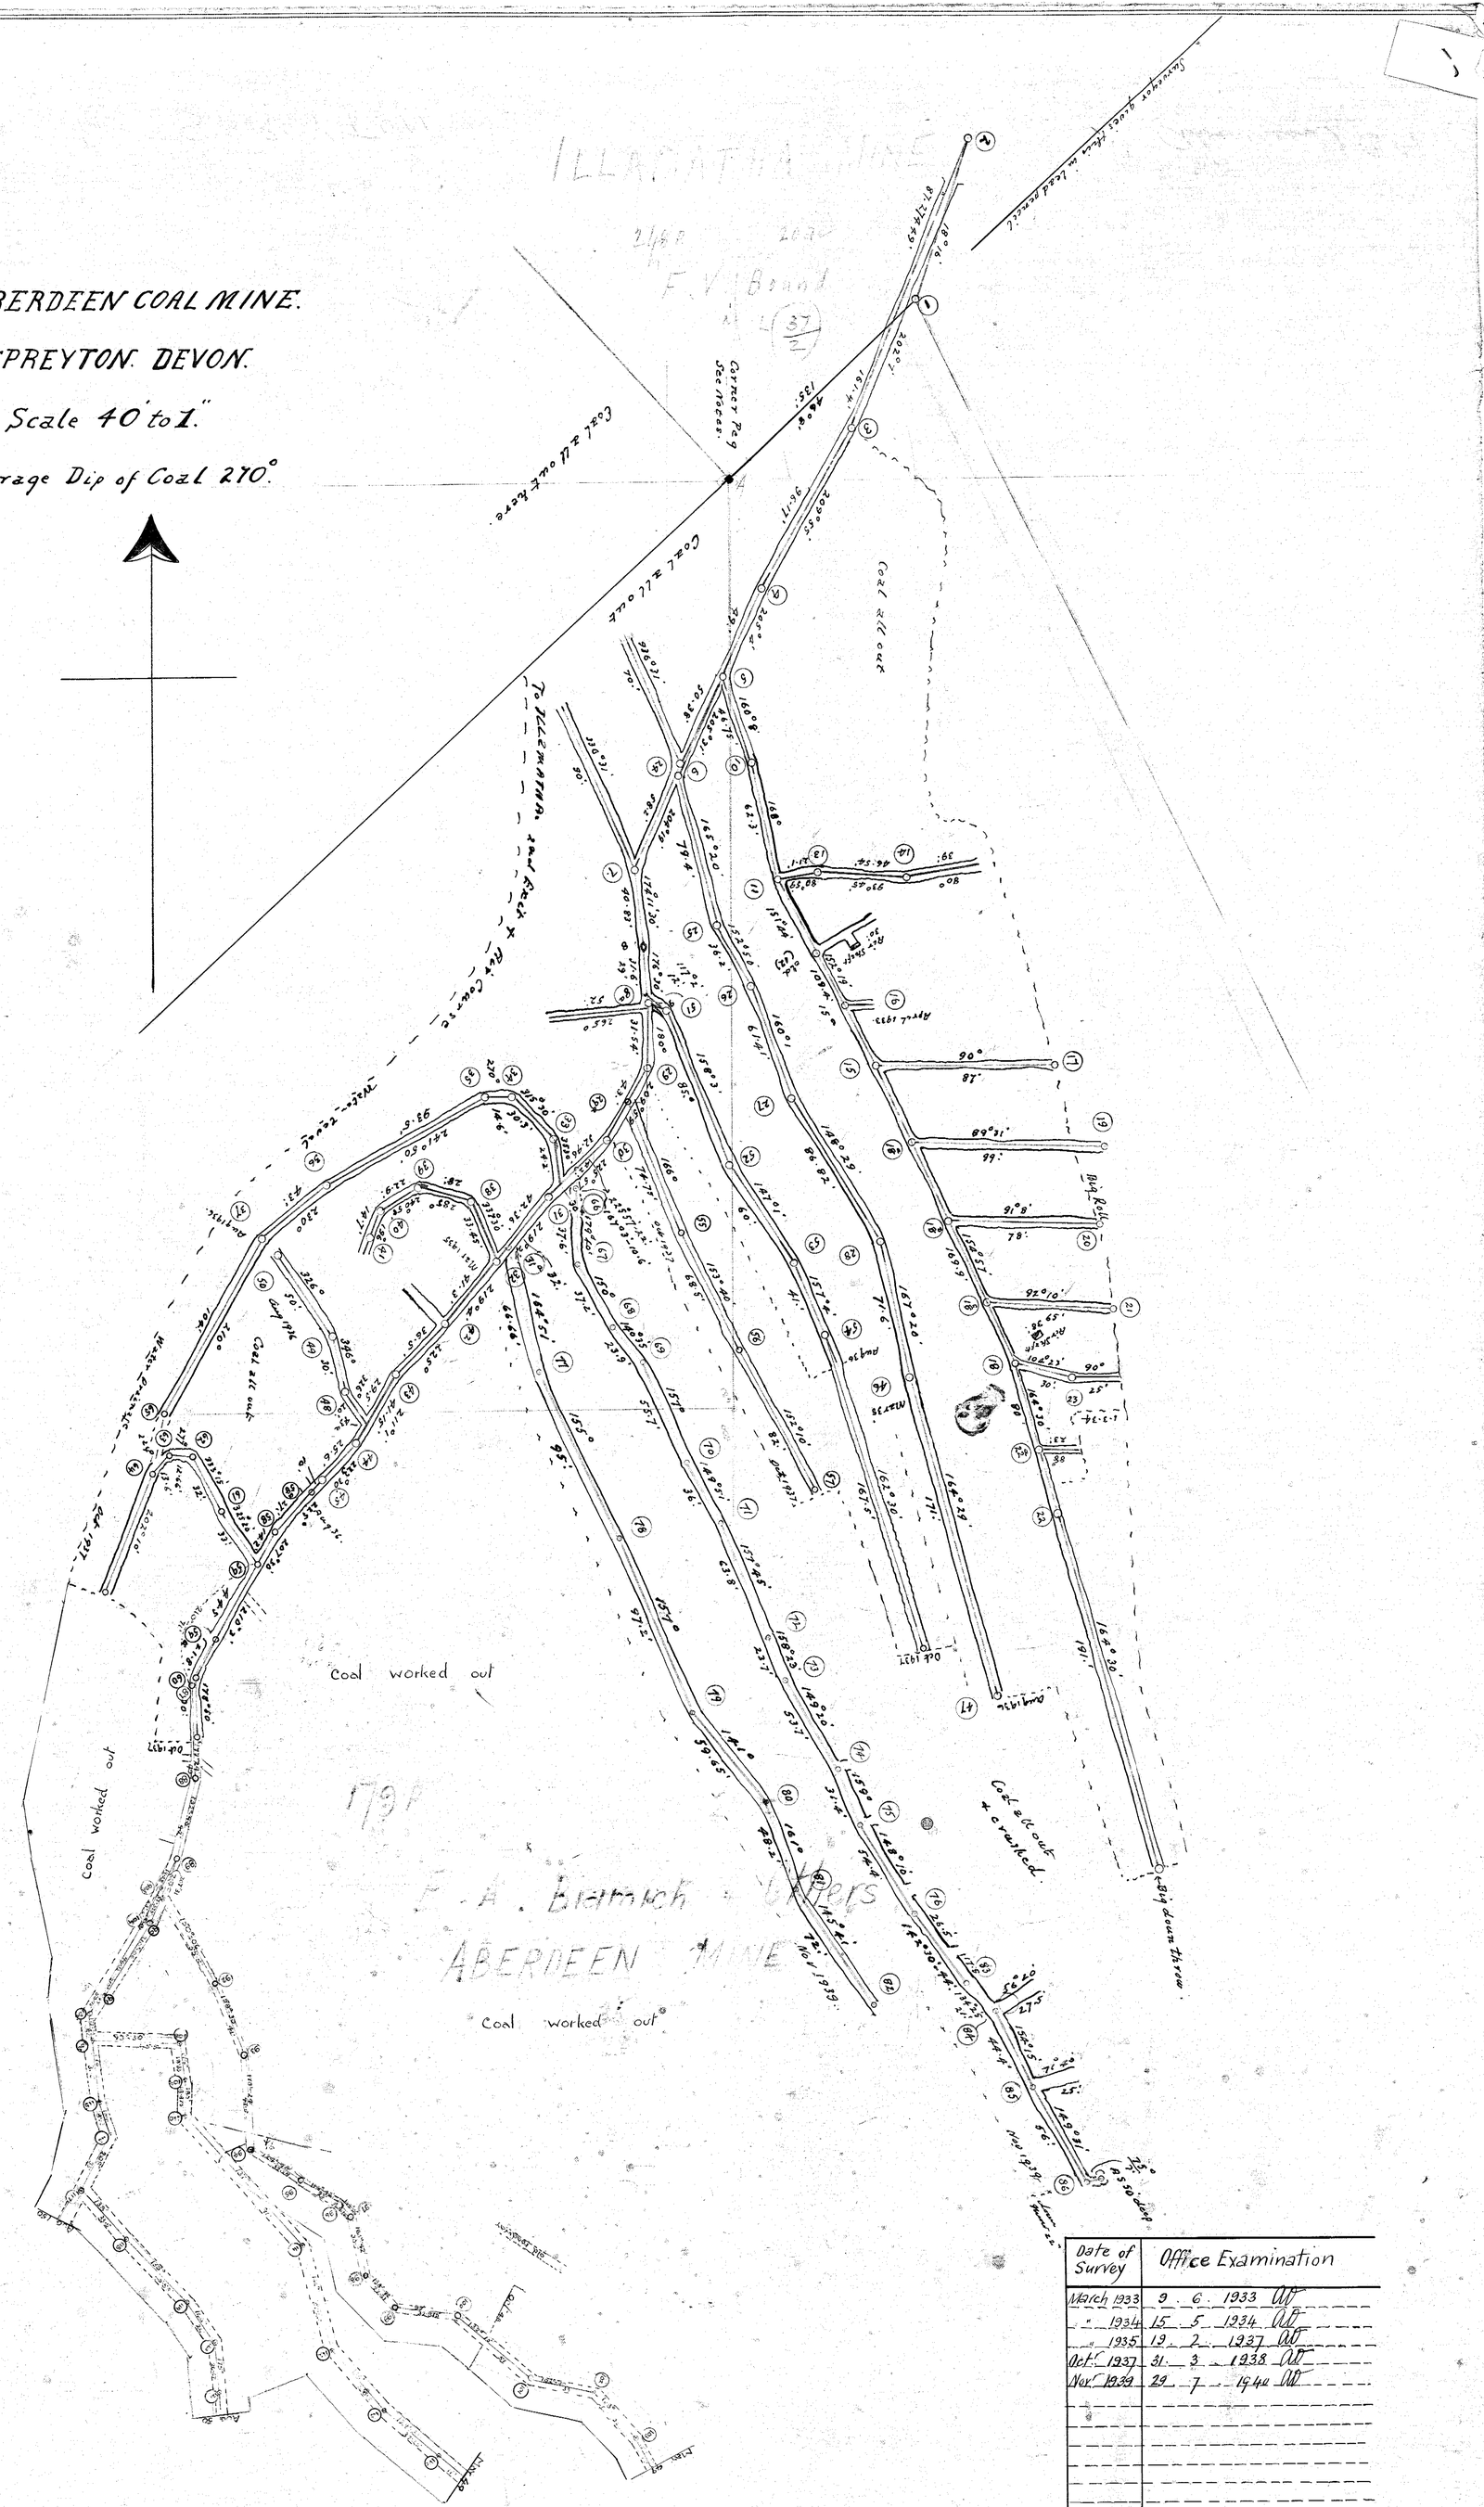

Date of Survey	Office Examination
March 1933	9 . 6 . 1933
" 1934	15 . 5 . 1934
" 1935	19 . 2 . 1937
Oct. 1937	31 . 3 . 1938
Nov. 1939	29 . 7 . 1940

33-01

Surveyed by D. Pedford. Oct. 1948

Surveyed by 9/11/Vandeau to Oct 1937 12 Nov 1937