
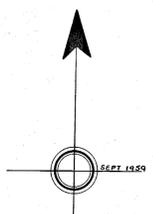


5 cm

34-04

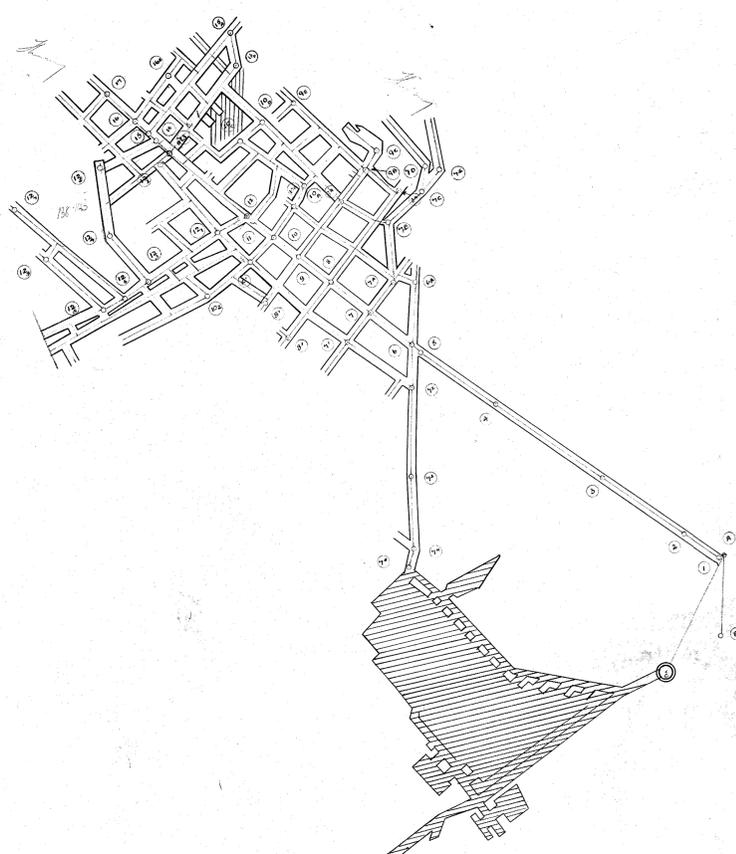

LINE	BEARING	DISTANCE
1-2	180°	237.5
2-3	208°	385.6
3-4	238°	16.9
4-5	303°2	128.8
5-6	303°6	234.9
6-7	303°6	383
7-8	303°6	267.7
8-9	304°20	32
9-10	0°36	126.1
10-11	306°20	148.7
11-12	316°20	110
12-13	306°20	169.8
13-14	32°36	381.6
14-15	216°20	208.2
15-16	0°20	110
16-17	36°20	206
17-18	206°16	163
18-19	306°20	110
19-20	32°32	110
20-21	212°10	100
21-22	306°20	80
22-23	306°20	80
23-24	132°48	284
24-25	173°38	262.6
25-26	172°02	211.7
26-27	134°23	80

SEYMOUR

Scale 2 Chains to an Inch

L. B. Batty
Surveyor
Com. Sec. of the State

TO DATE AUGUST 1962
 MAY 1964

34-04