




TASMANIAN SHALE & OIL CO. NO LIABILITY.  
PLAN OF OPERATIONS ON LEASE "4164M."

Scale 2 Chains to an Inch

*Survey made with  
5 1/2" Transit*  
D.M. Clarke  
Surveyor General  
August 16 to 1911

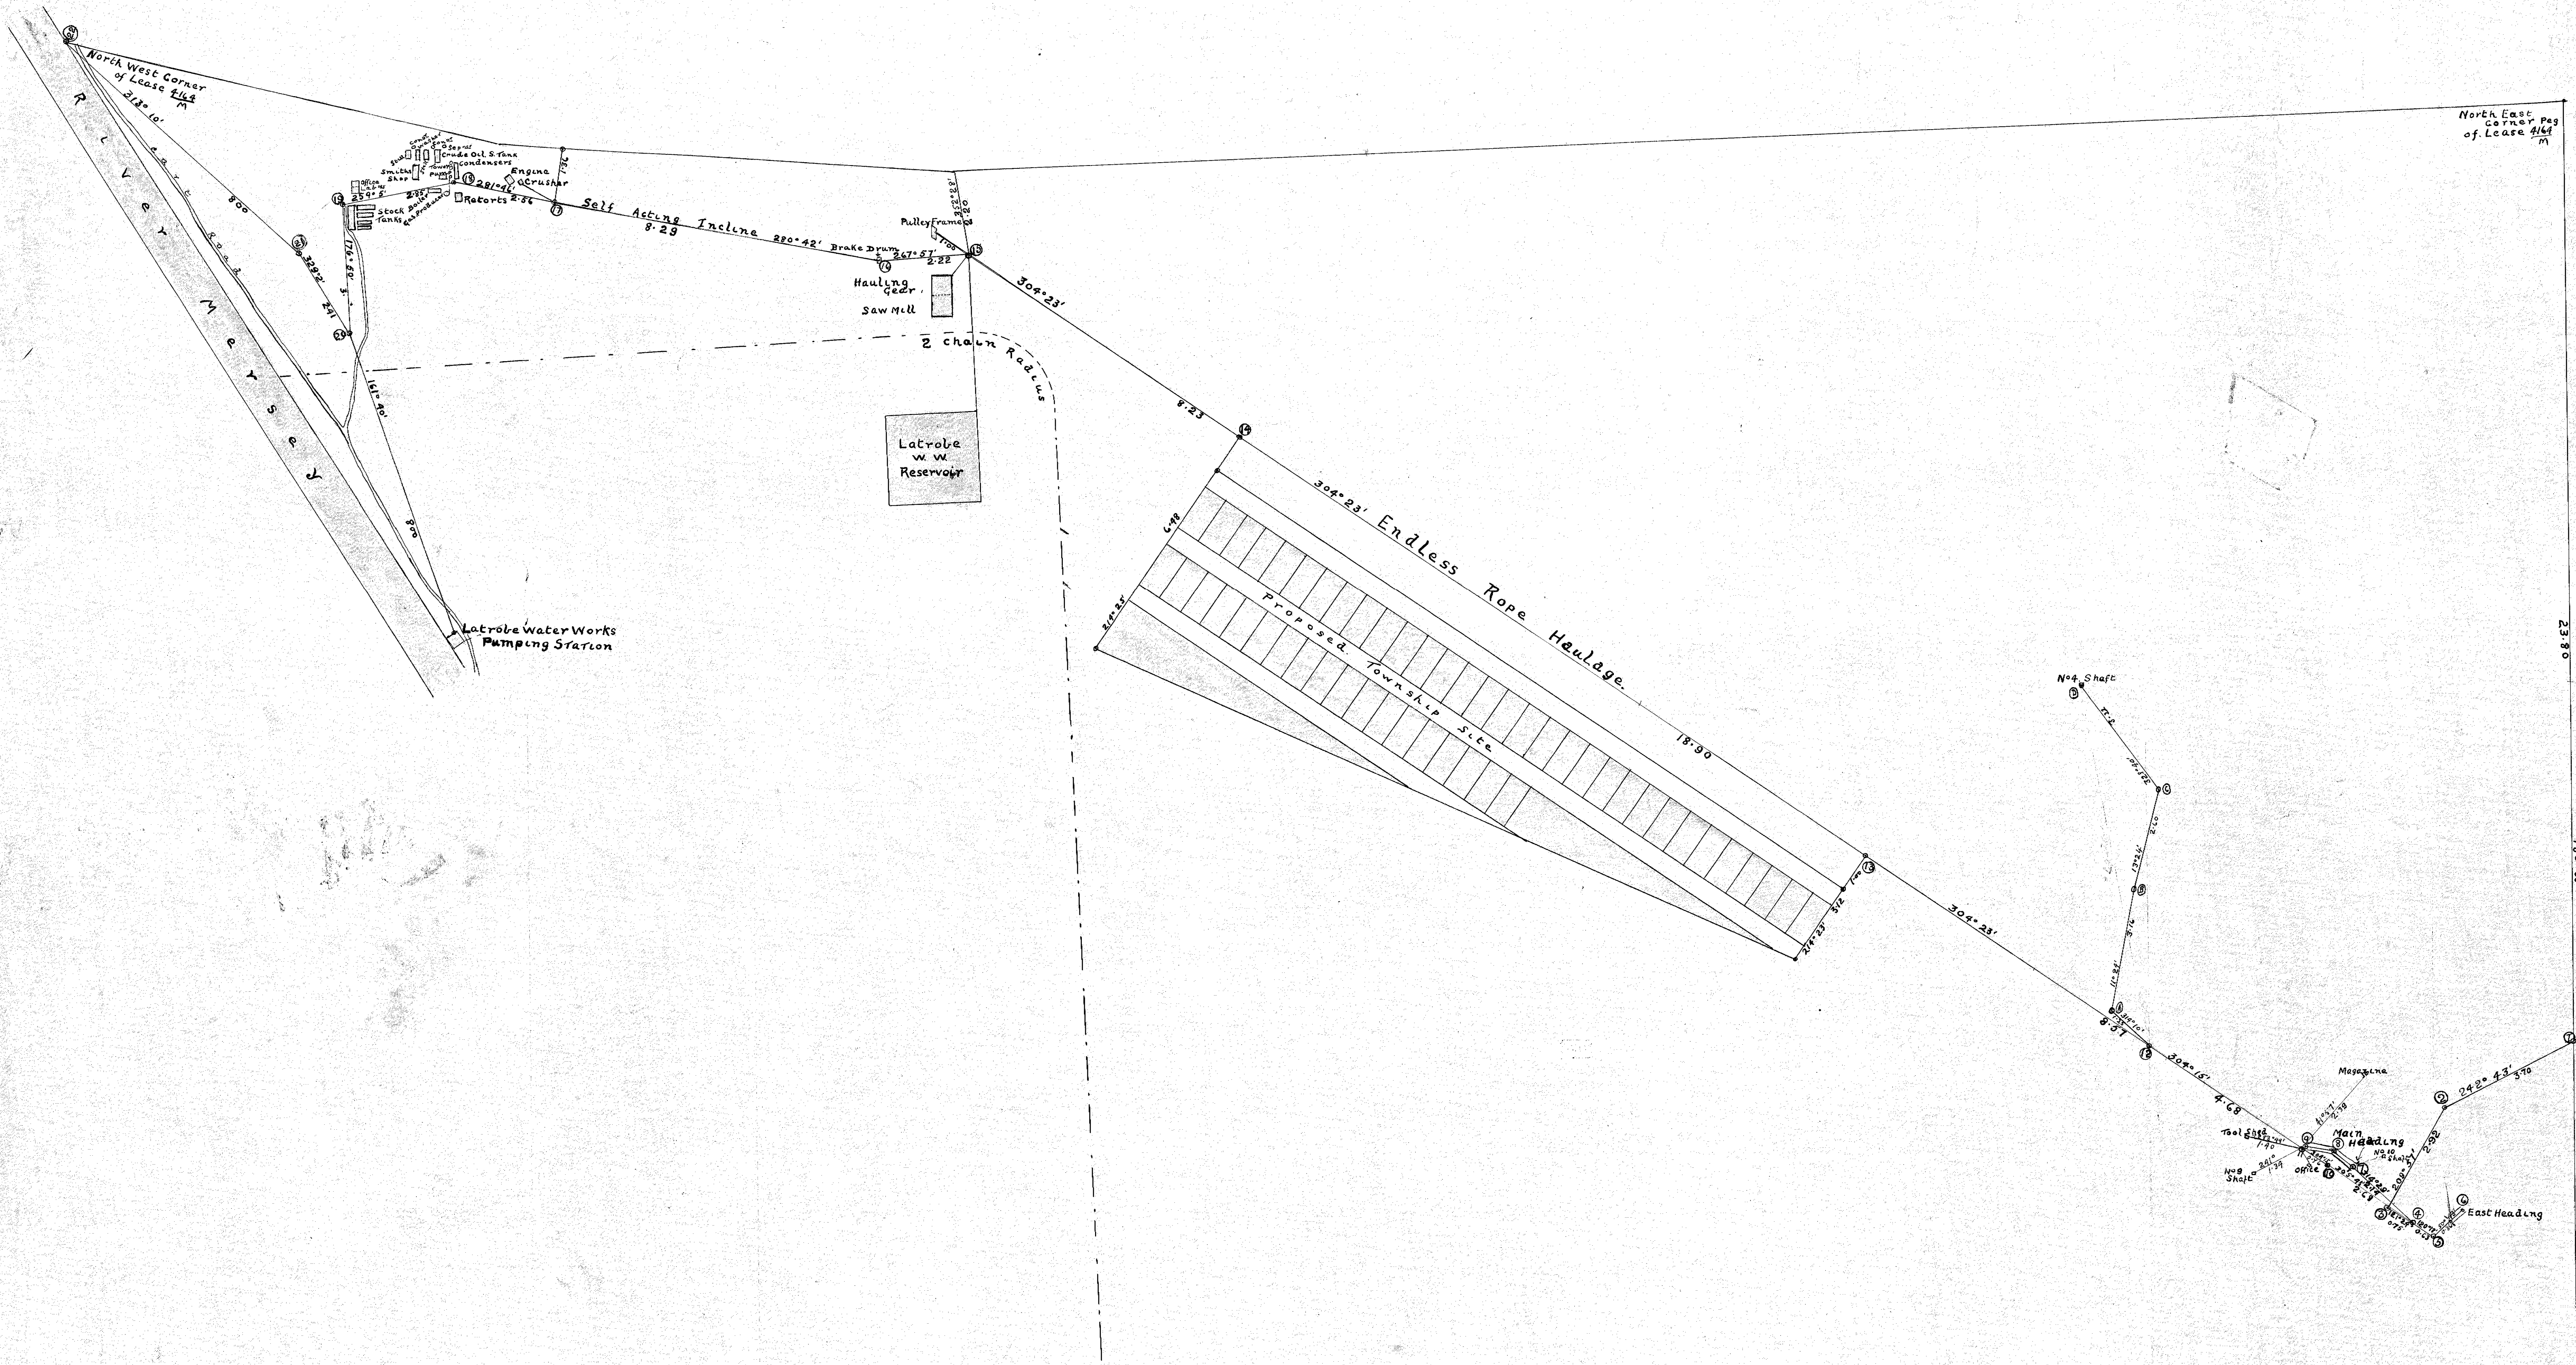