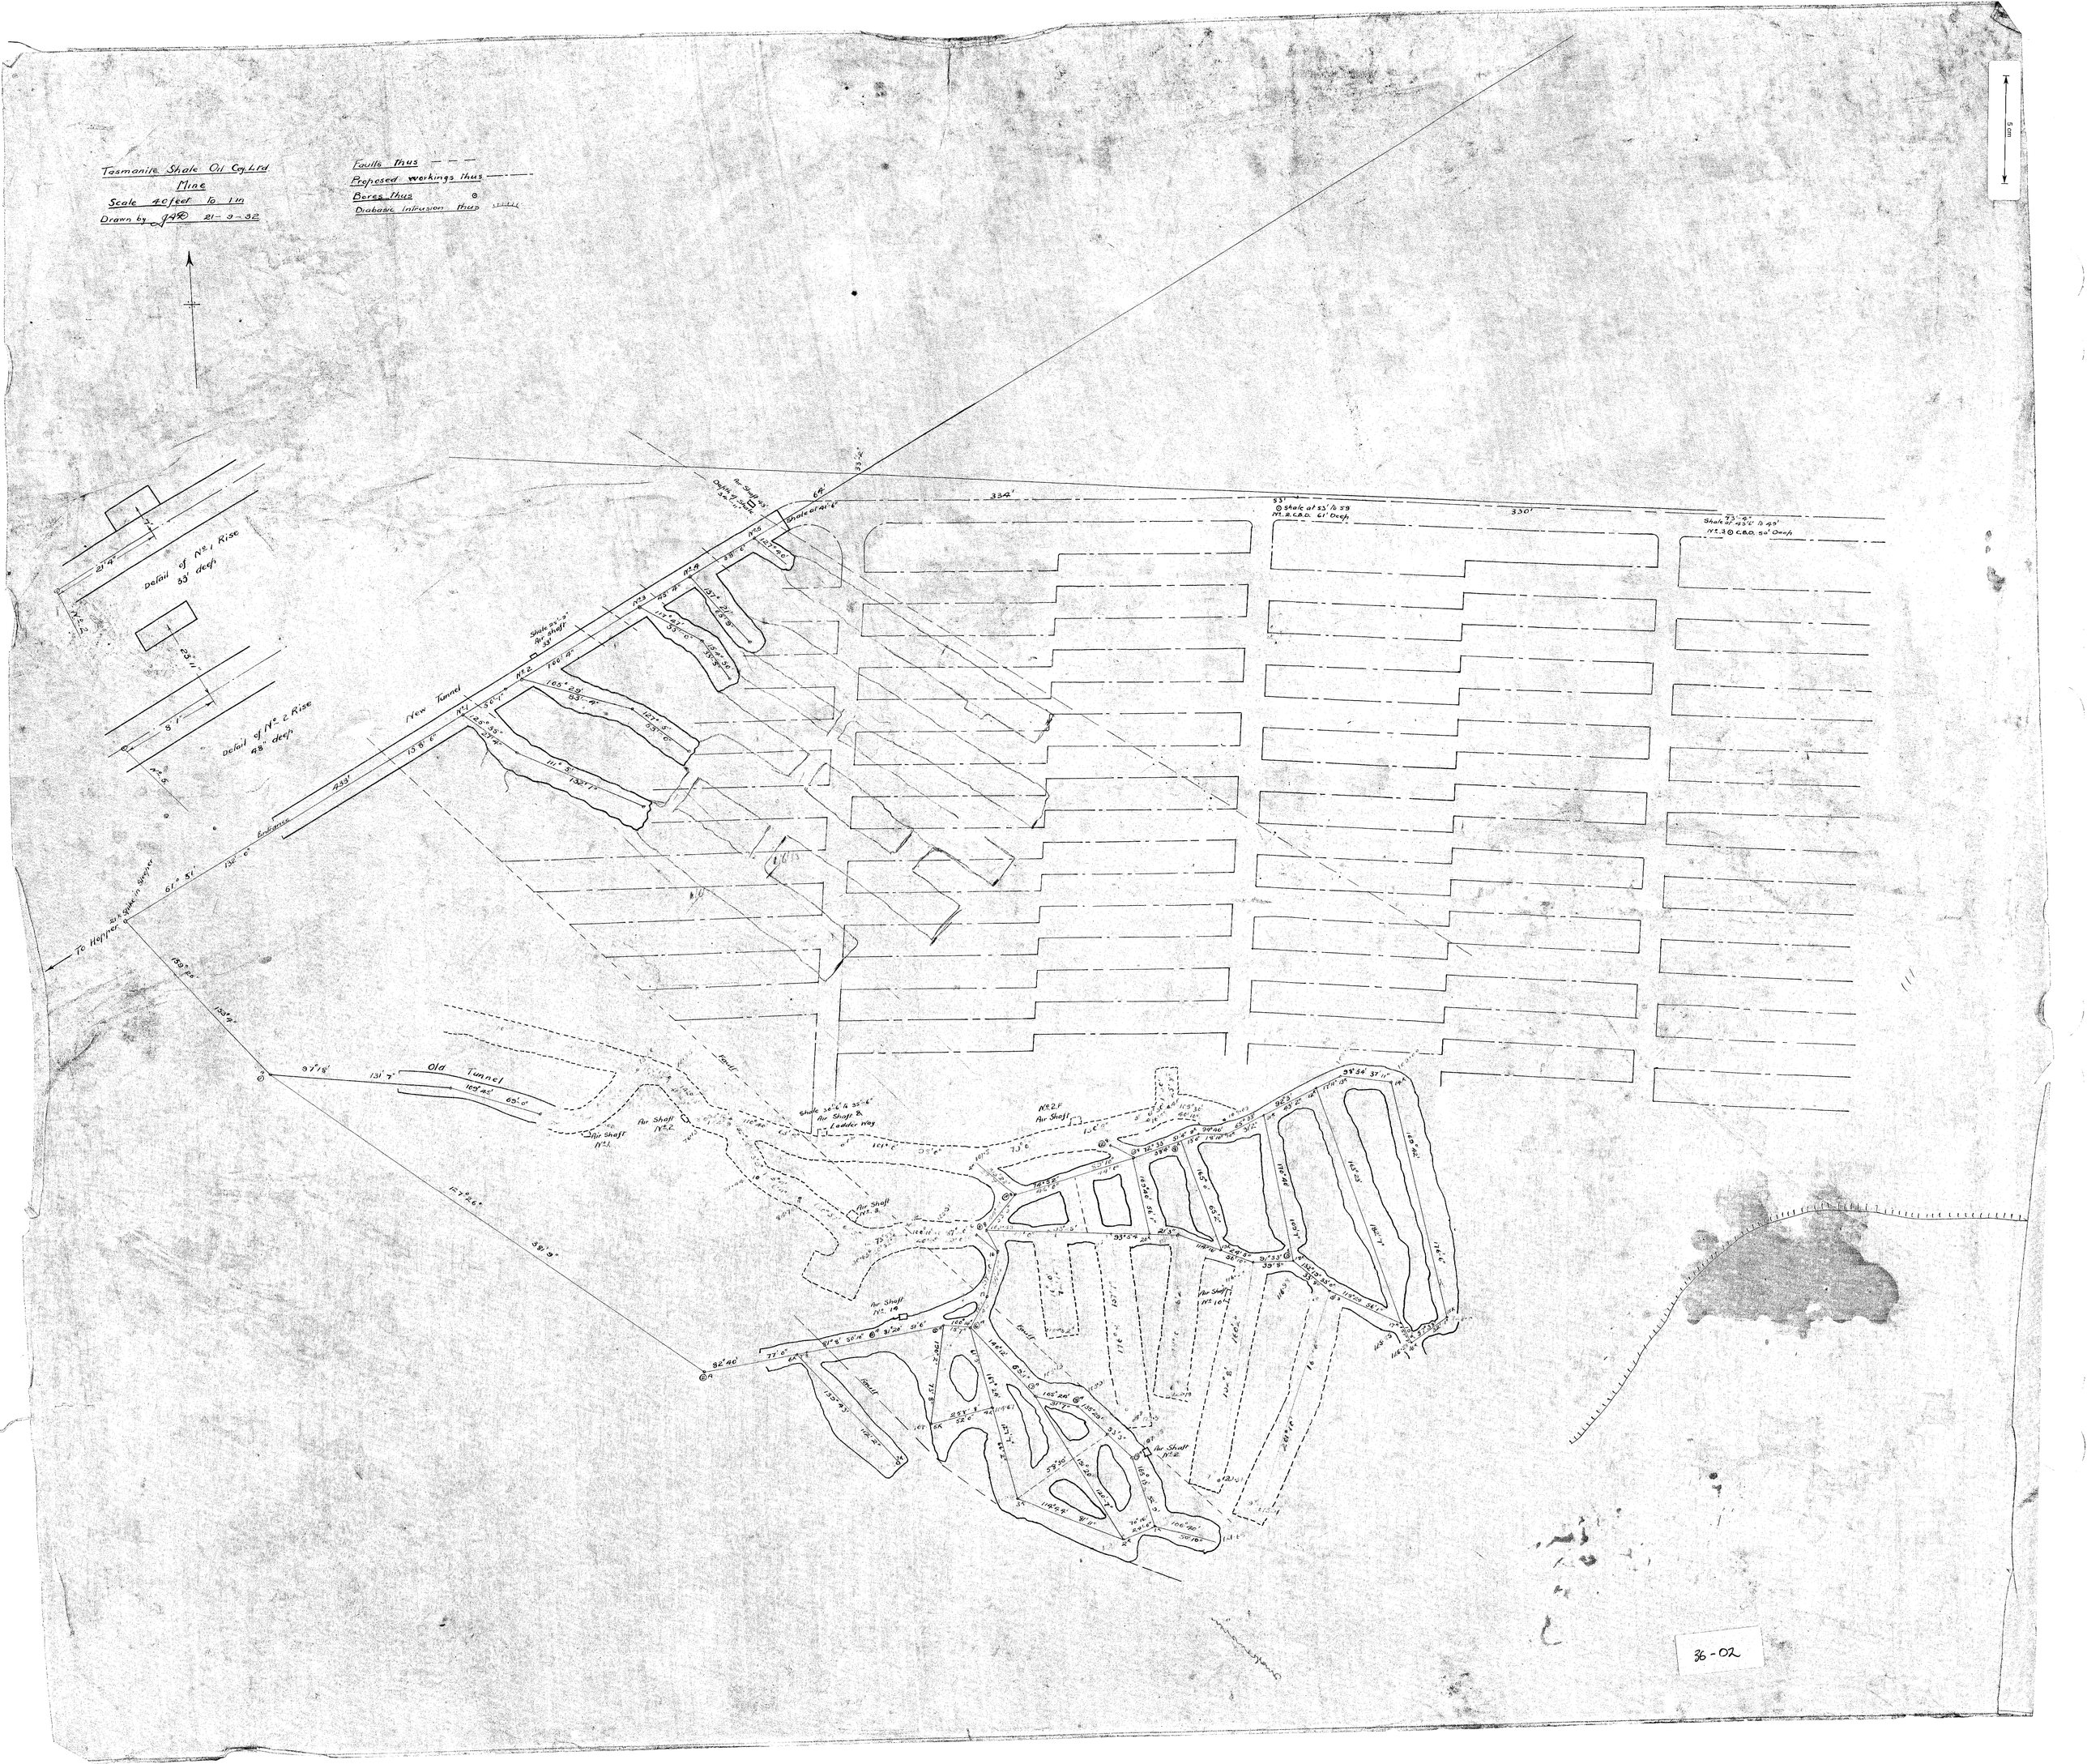
Tasmanite Shale Oil Coy Ltd
Mine
Scale 40 feet to 1 in
Drawn by J.A.R. 21-9-32
Faults thus
Proposed workings thus
Bores thus
Diabasic intrusion thus
5 cm
Detail of No 1 Rise
33' deep
Detail of No 2 Rise
49' deep
New Tunnel
Old Tunnel
Entrance
To Hopper
Fault
Air Shaft No 1
Air Shaft No 2
Air Shaft No 3
Air Shaft No 10
Air Shaft No 12
Air Shaft No 19
Shale at 43'6" to 45'
No 3 C.B.D. 50' Deep
Shale at 53' to 59'
No 2 C.B.D. 61' Deep
Shale 33'6" to 35'6"
Air Shaft & Ladder Way
No 2 F
Air Shaft
332'
330'
433'
36-02