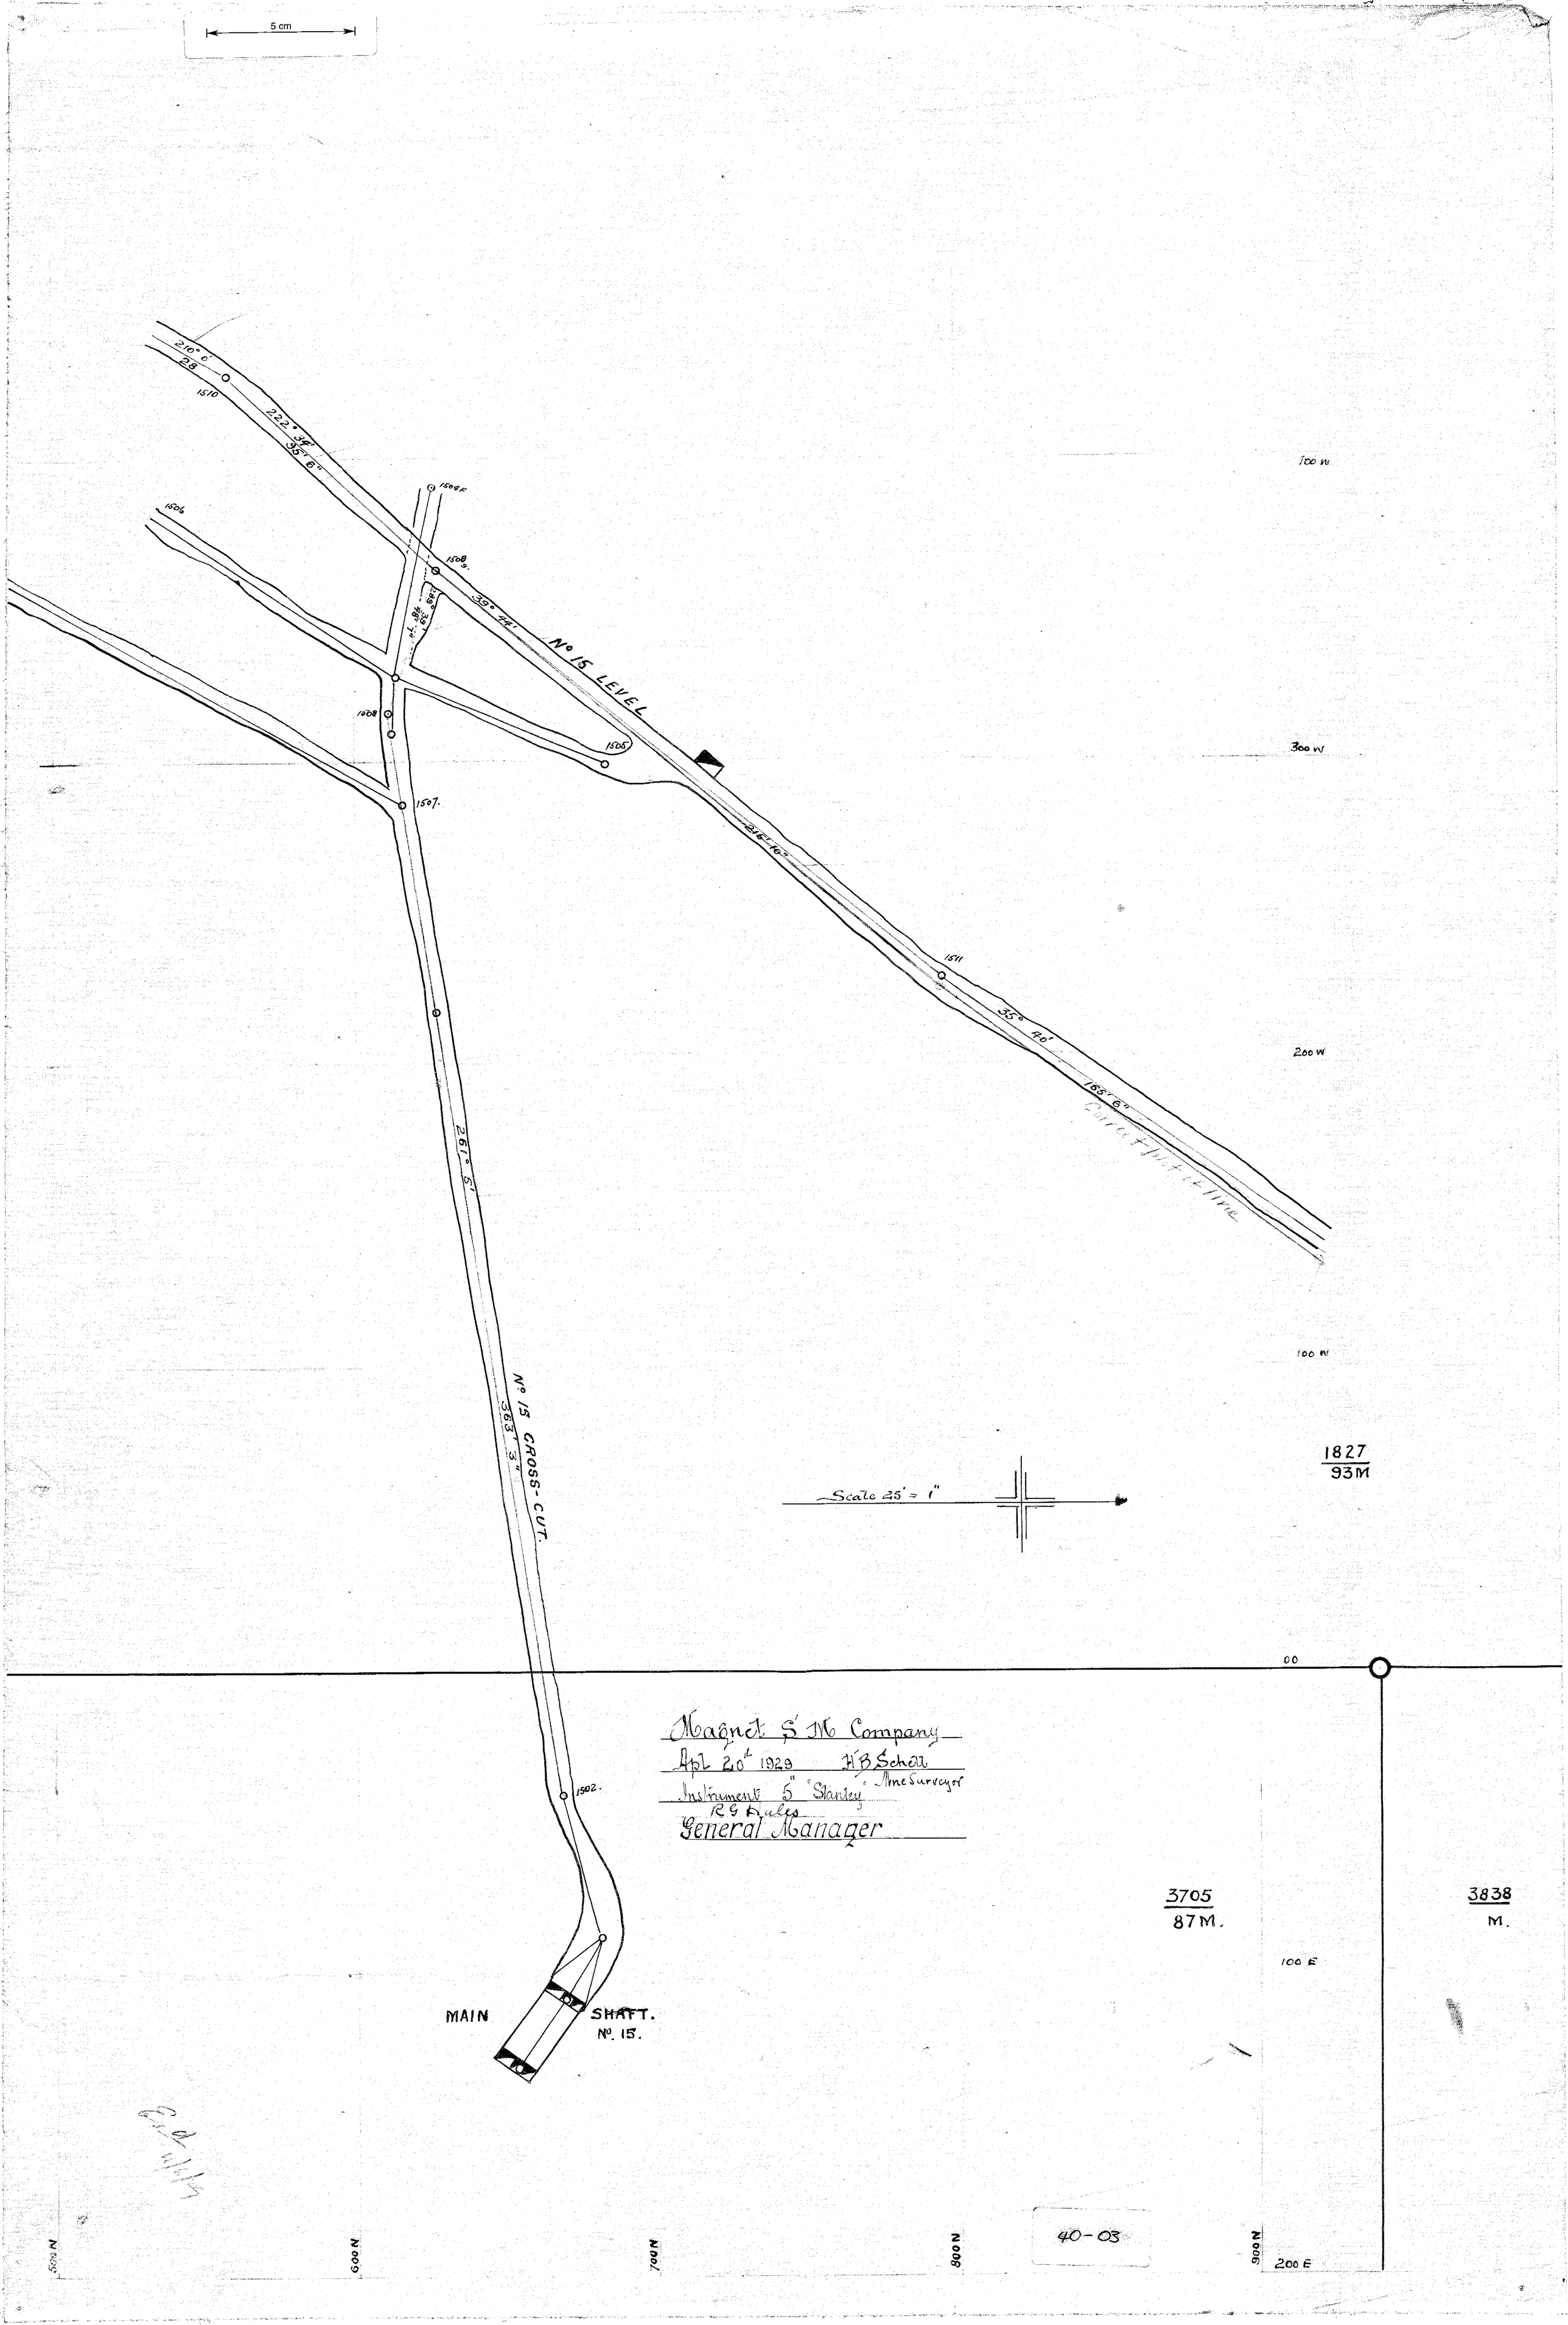

Magnet S M Company
Apl 20th 1929 H B Scholl
Mine Surveyor
Instrument 5" "Stanley"
R G Hulls
General Manager