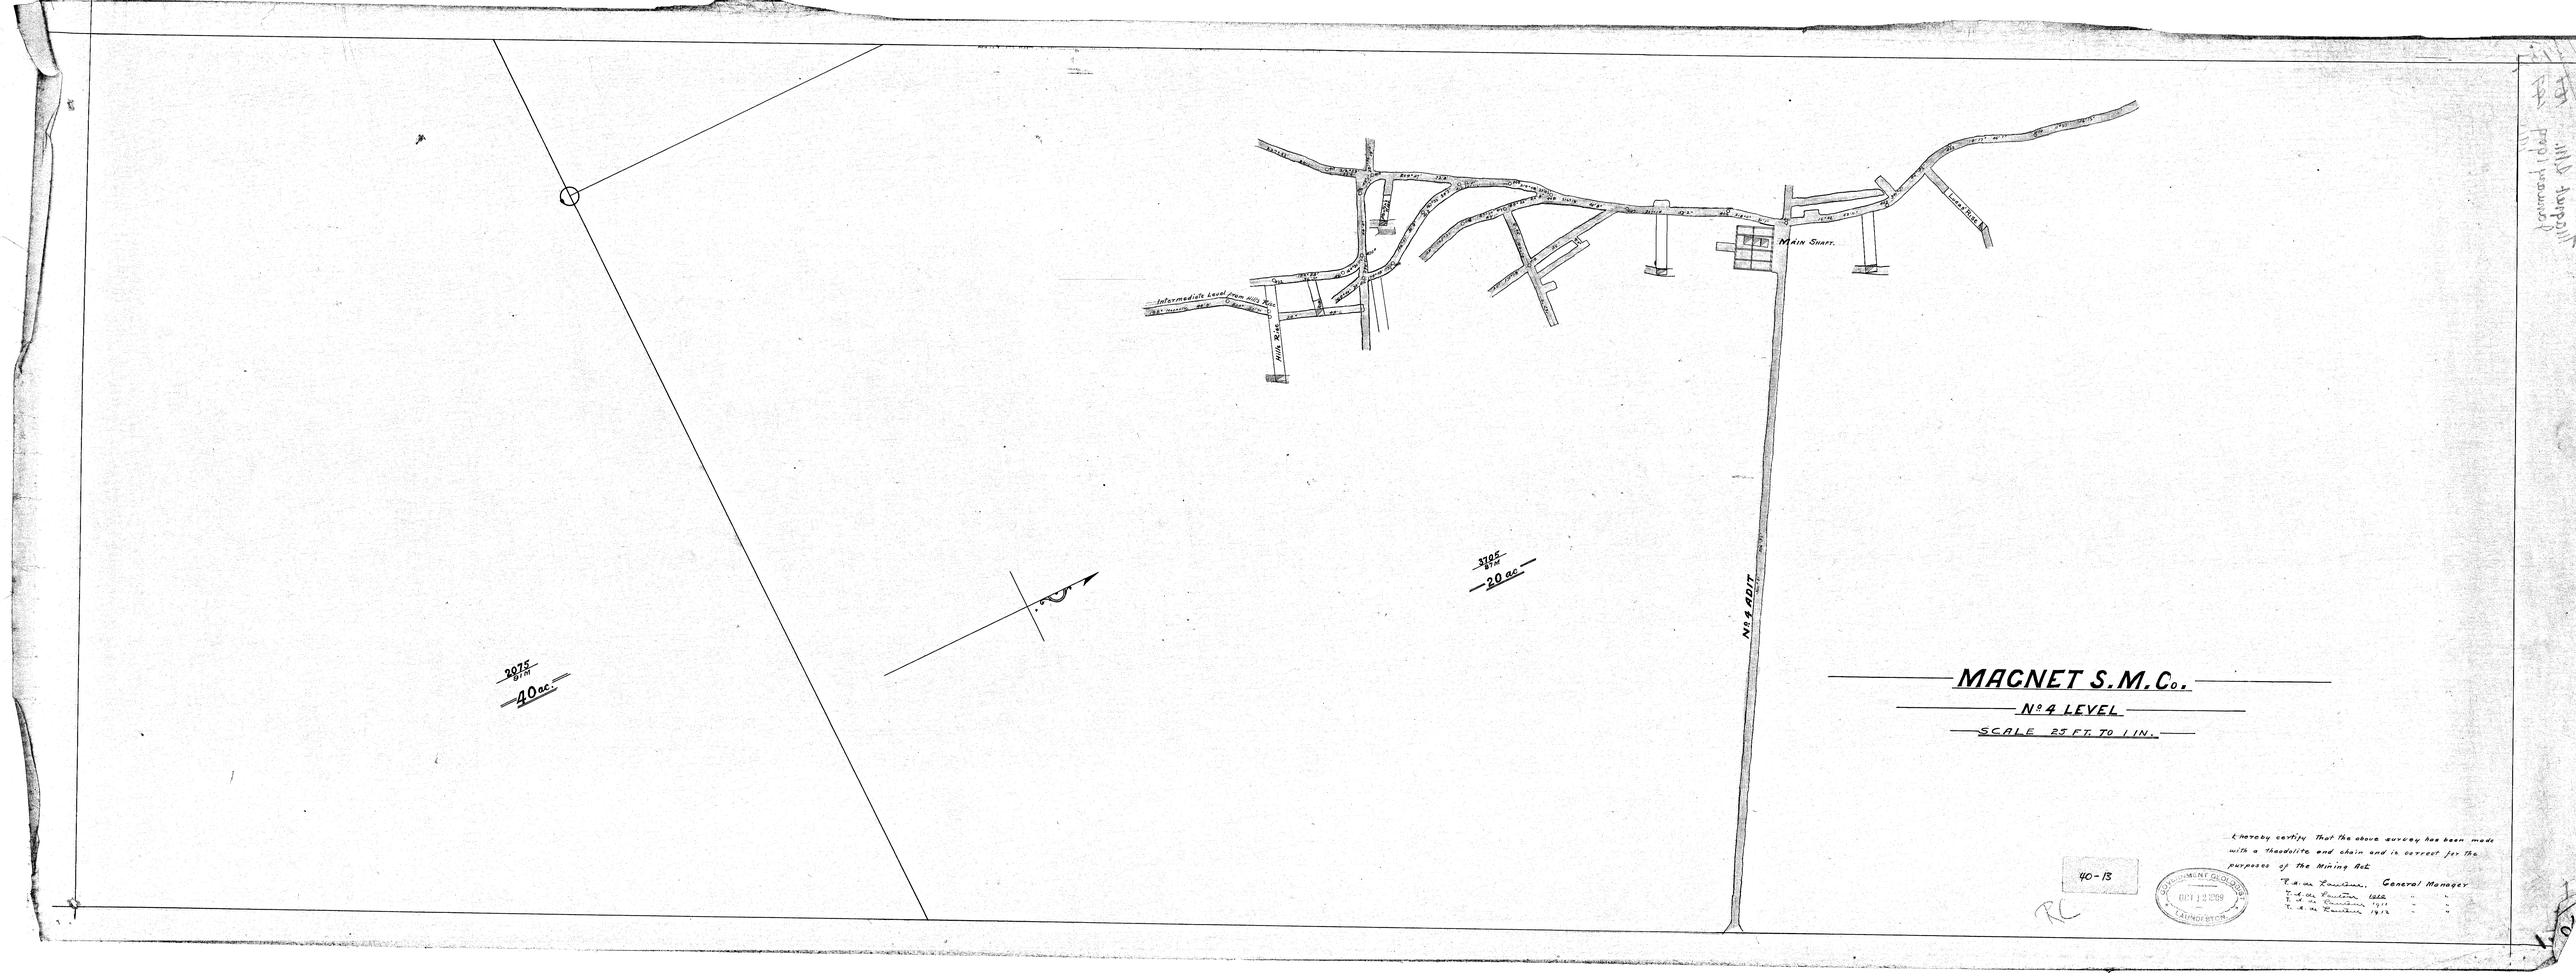
Main Shaft.
No. 4 Adit
2075 B.H.
40 ac.
3705 B.H.
20 ac.
MAGNET S.M.Co.
No. 4 LEVEL
SCALE 25 FT. TO 1 IN.
I hereby certify That the above survey has been made with a Theodolite and chain and is correct for the purposes of the Mining Act.
T. A. M. Lowthian. General Manager
T. A. M. Lowthian 1911 " "
T. A. M. Lowthian 1912 " "
T. A. M. Lowthian 1913 " "
40-13
OCT 12 1909
LAUNCESTON