MAGNET SILVER MINING Co^Y N.L.

PLAN OF UNDERGROUND WORKINGS

—Scale 40 Feet to 1 Inch—

FOR YEAR ENDING DECEMBER 1926.

—GENERAL MANAGER— —MINE SURVEYOR—
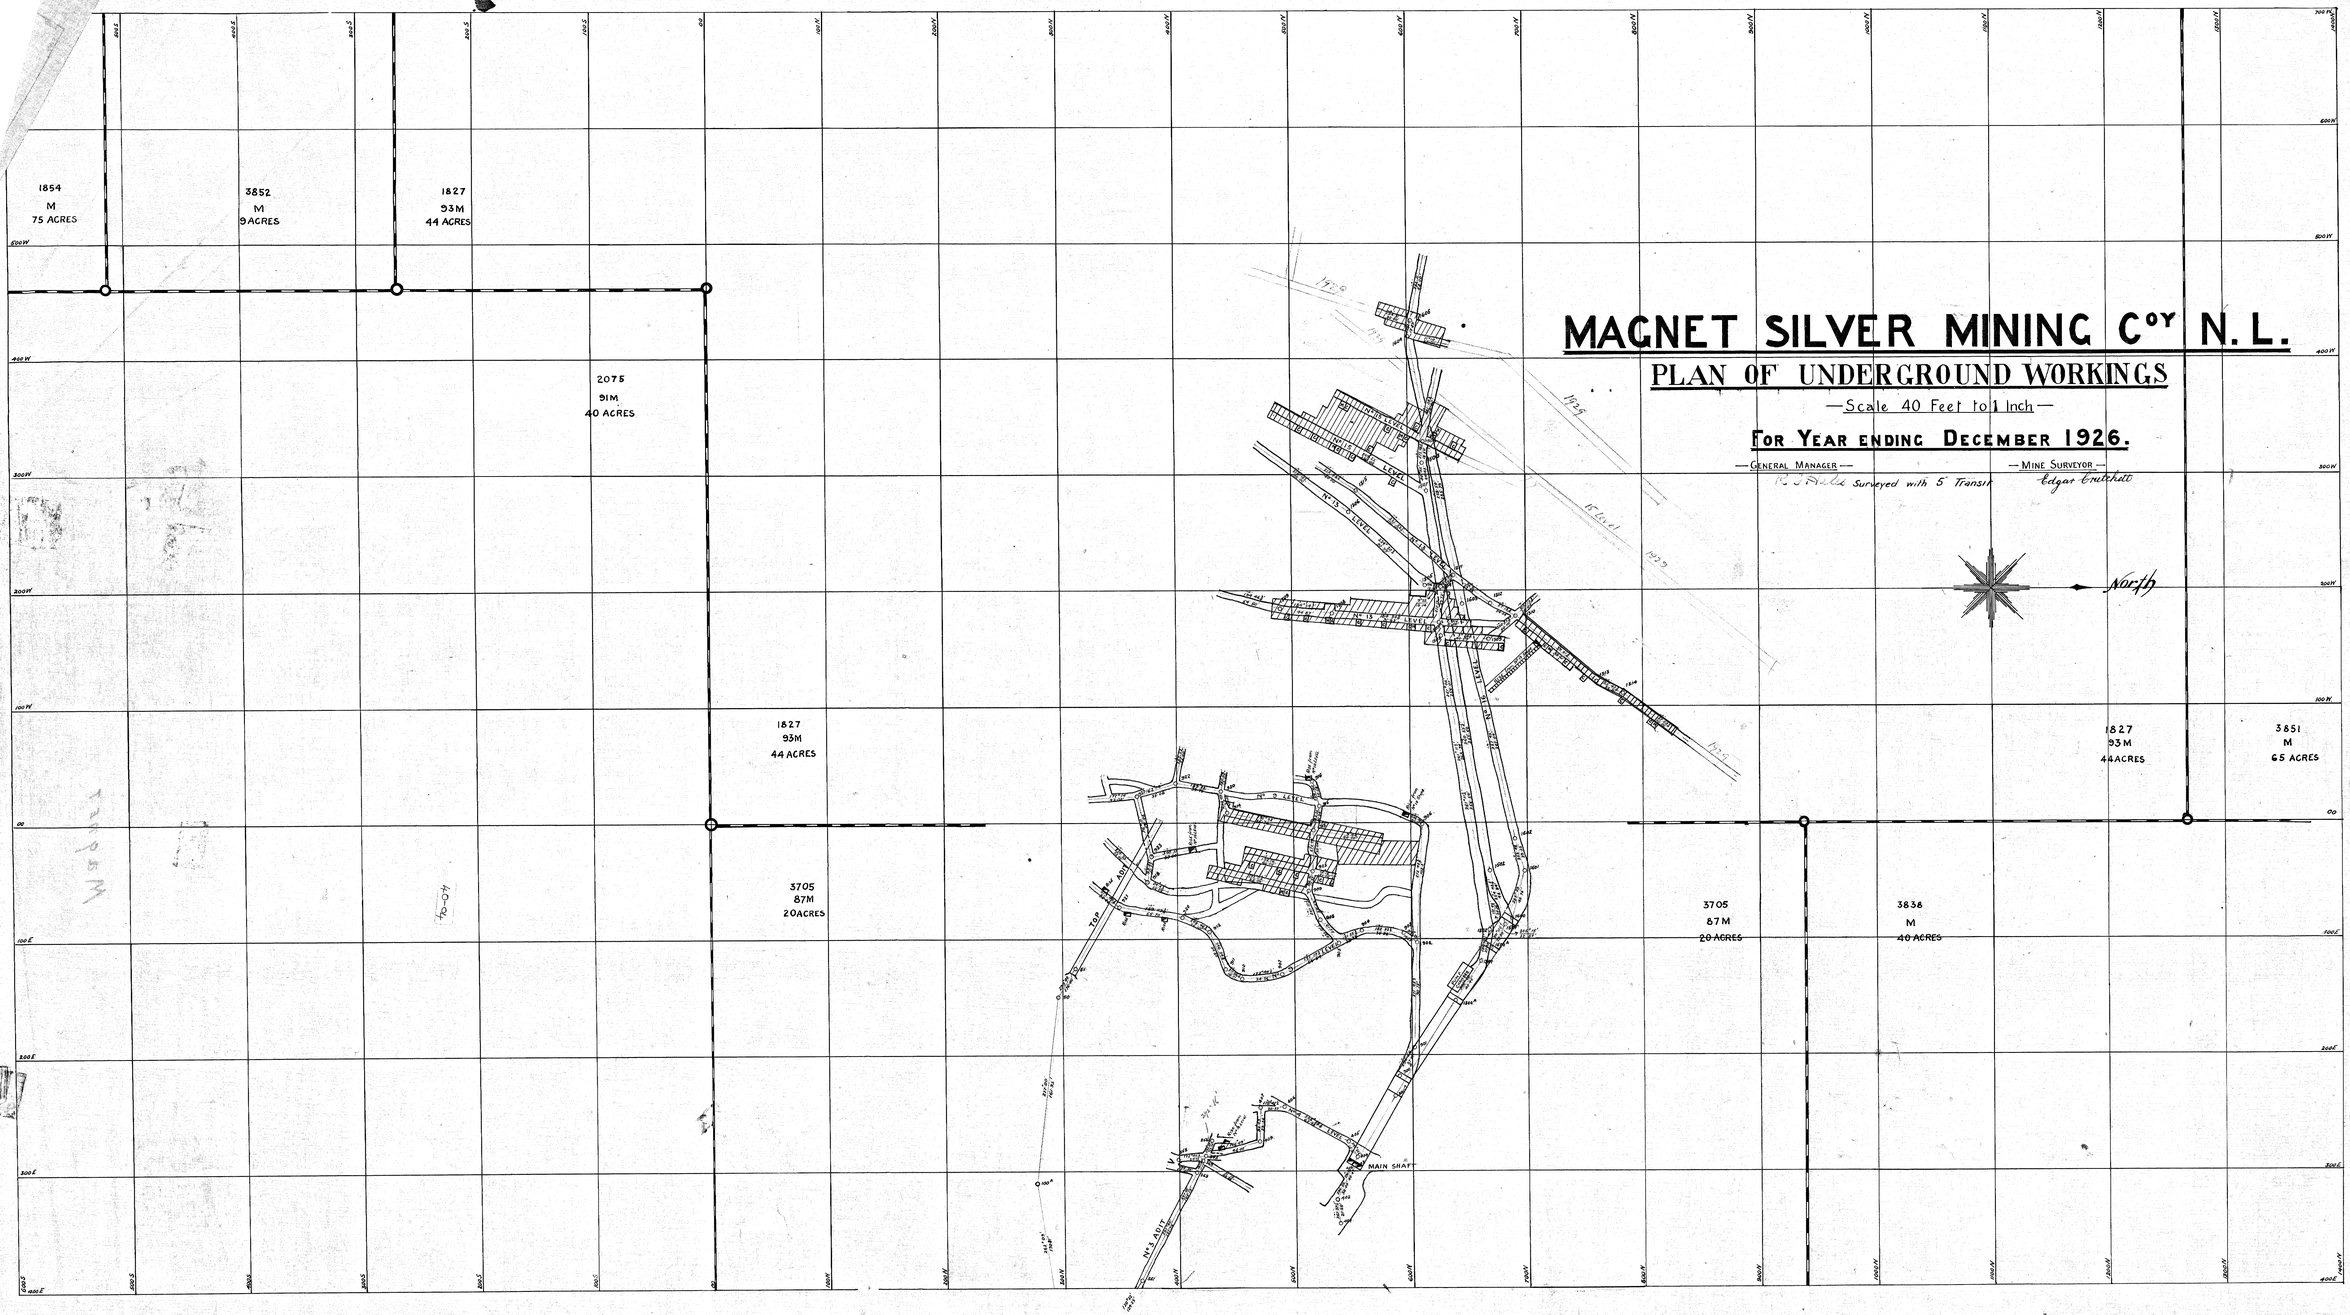
R. J. Kelly Surveyed with 5" Transit Edgar Crutchett