


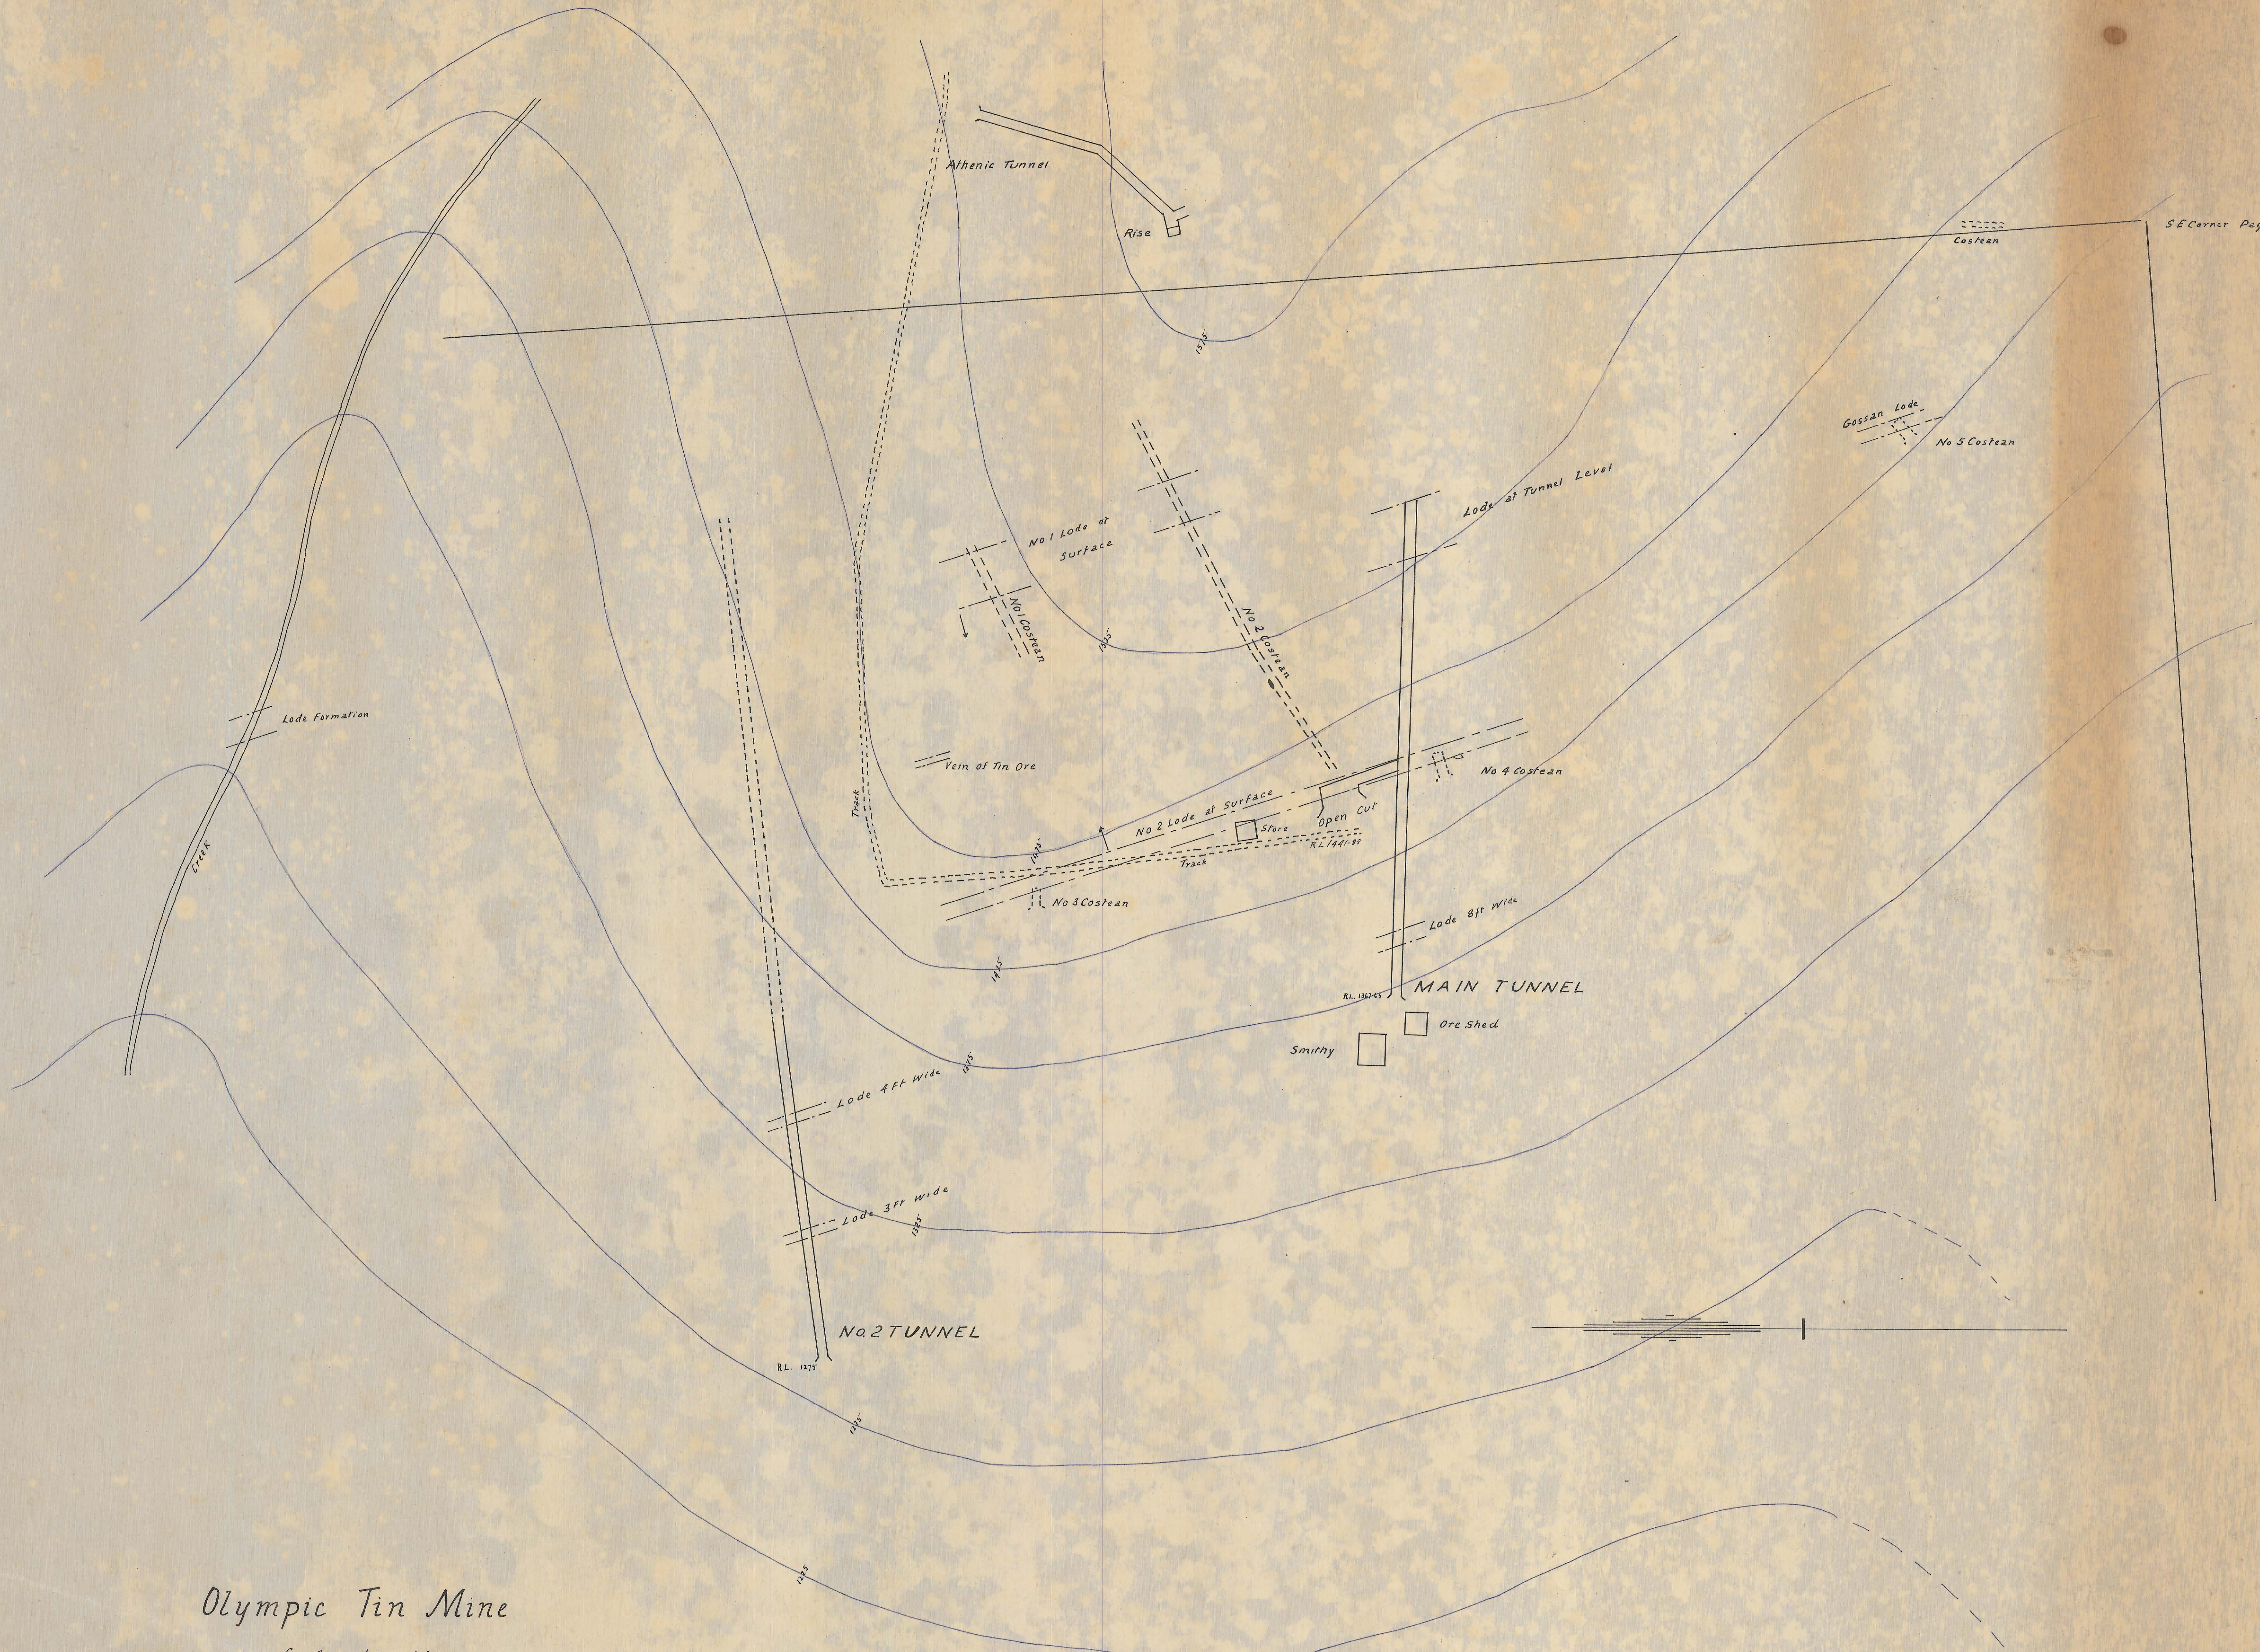

Olympic Tin Mine

Scale 1 in = 40 ft



7-3-13 (887)

0043-001