


N.T. SECTION

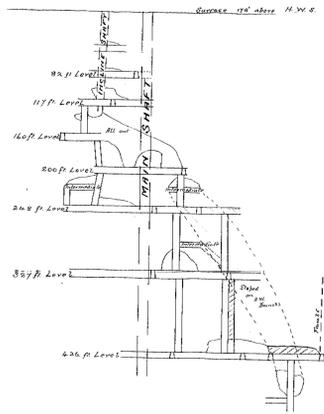

45-02