ROYAL GEORGE T.M.

Scale 40 ft to Inch

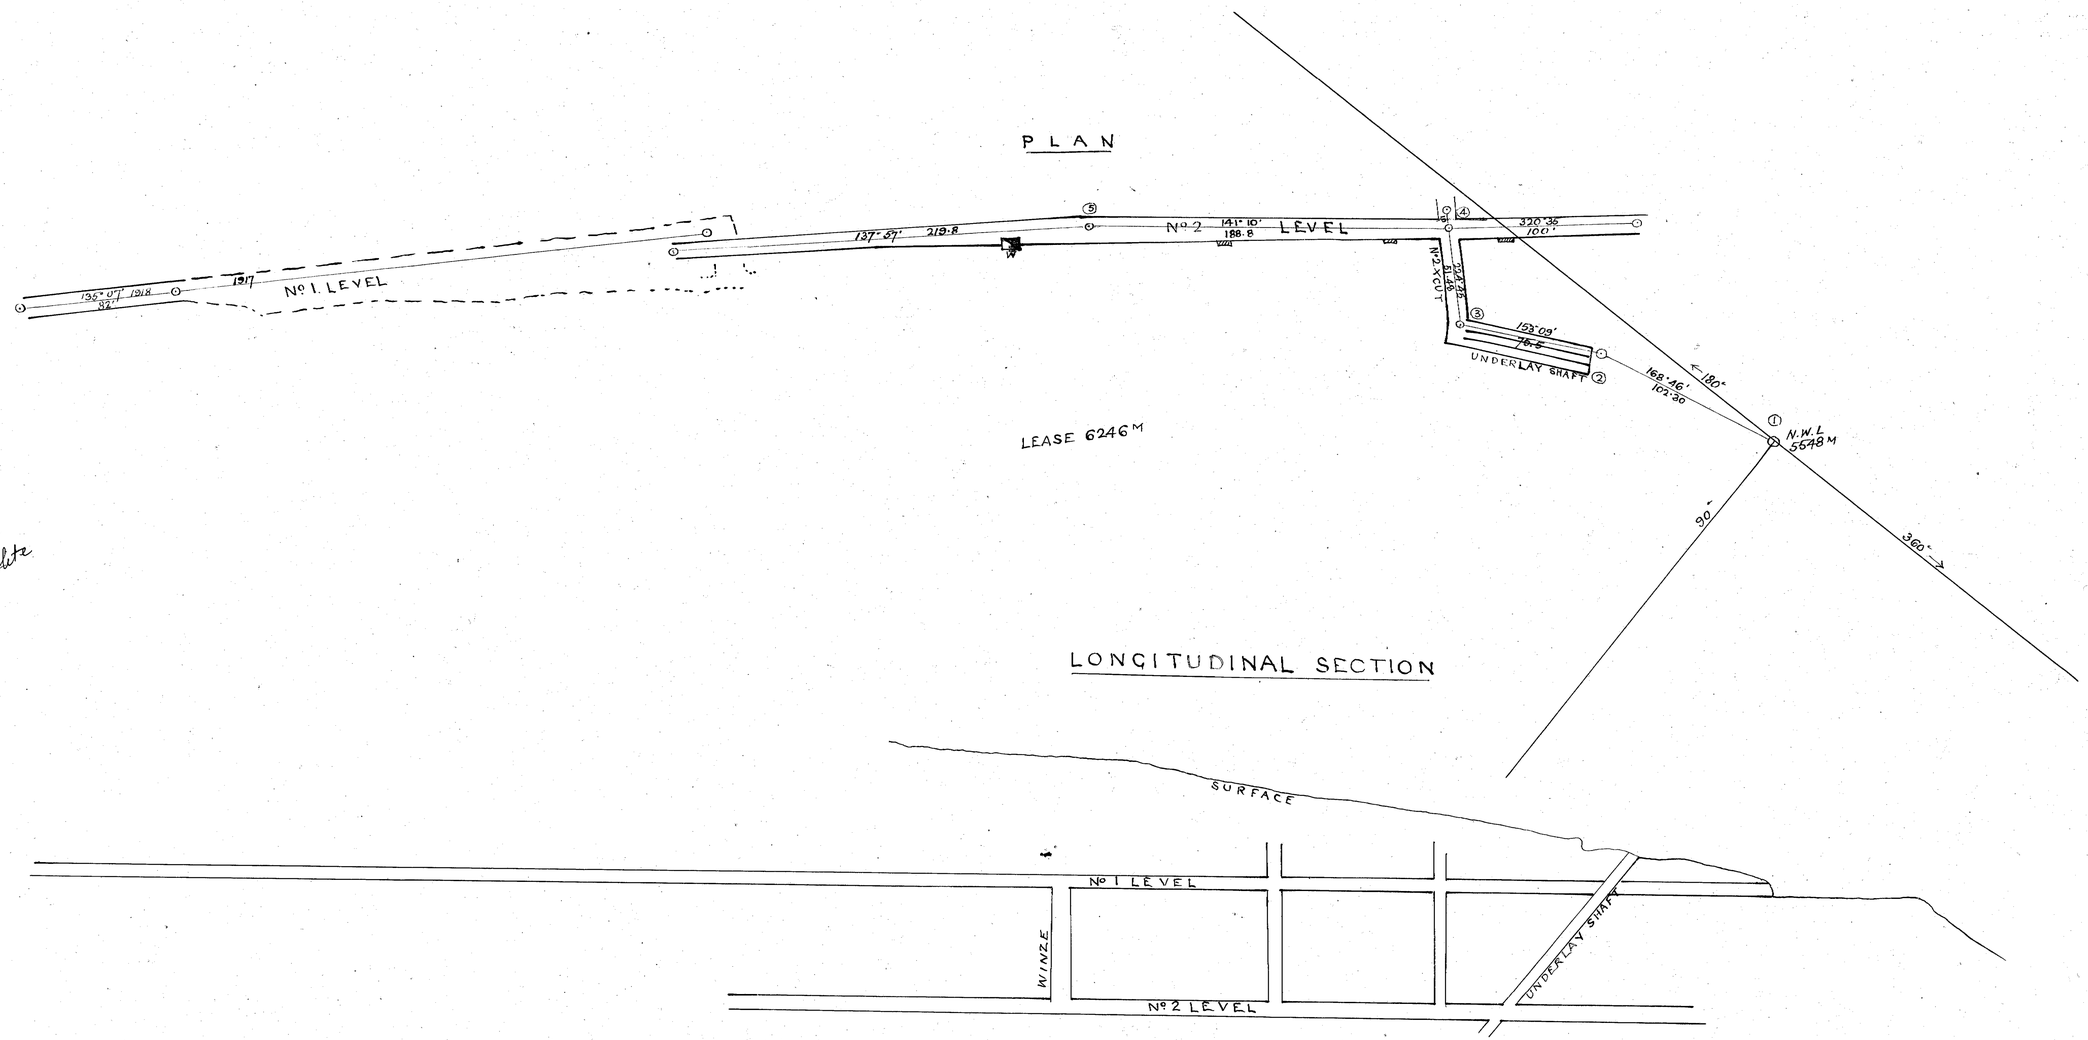

I hereby certify this is a correct copy of plan of work to Sept 1918
(Sd) C Bingley Watchorn
Auth Surveyor
Surveyed with Theodolite

45-04