


N.T. SECTION

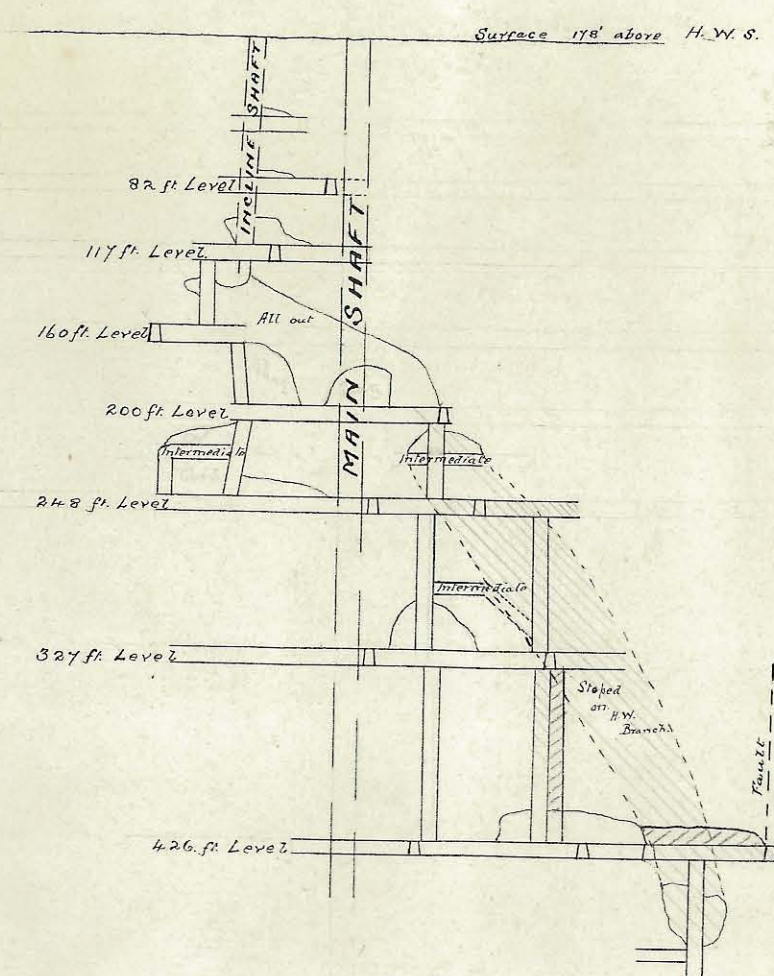

45-02

P 34

46-03