GODKIN S. M. COY.

UNDERGROUND WORKINGS

FOR YEAR 1922

SCALE 50 FT TO 1 INCH

H. Somerville
Mining Surveyor
20-4-23.

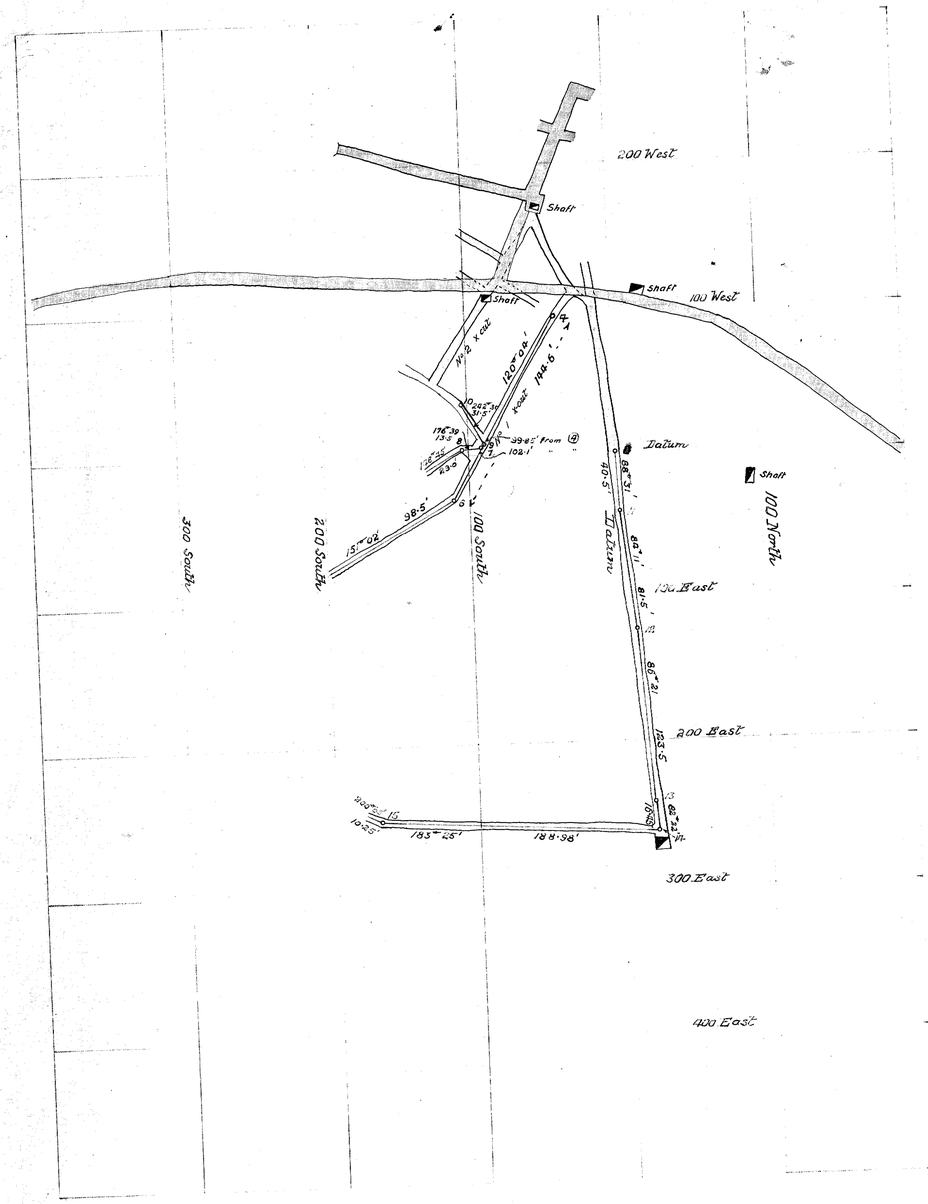

PLAN

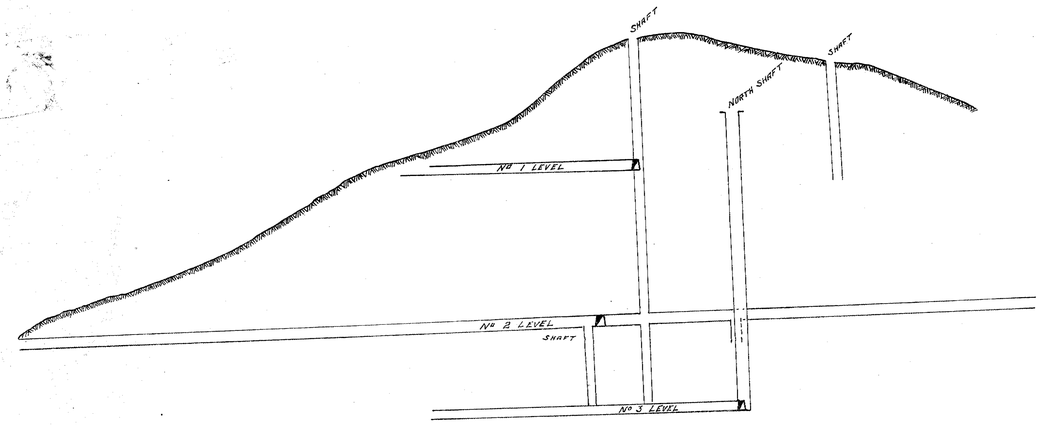

LONGITUDINAL SECTION

Projected on Plane bearing North-South

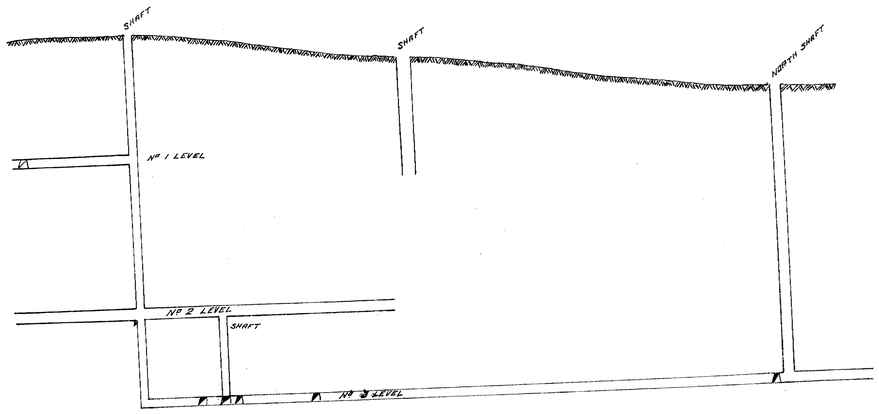

TRANSVERSE SECTION

Projected on Plane bearing East-West

47-02