GODKIN S. M. COY.

UNDERGROUND WORKINGS

FOR YEAR 1921

SCALE 50 FT TO 1 INCH

H Somerville
Mine Surveyor
29-4-22.

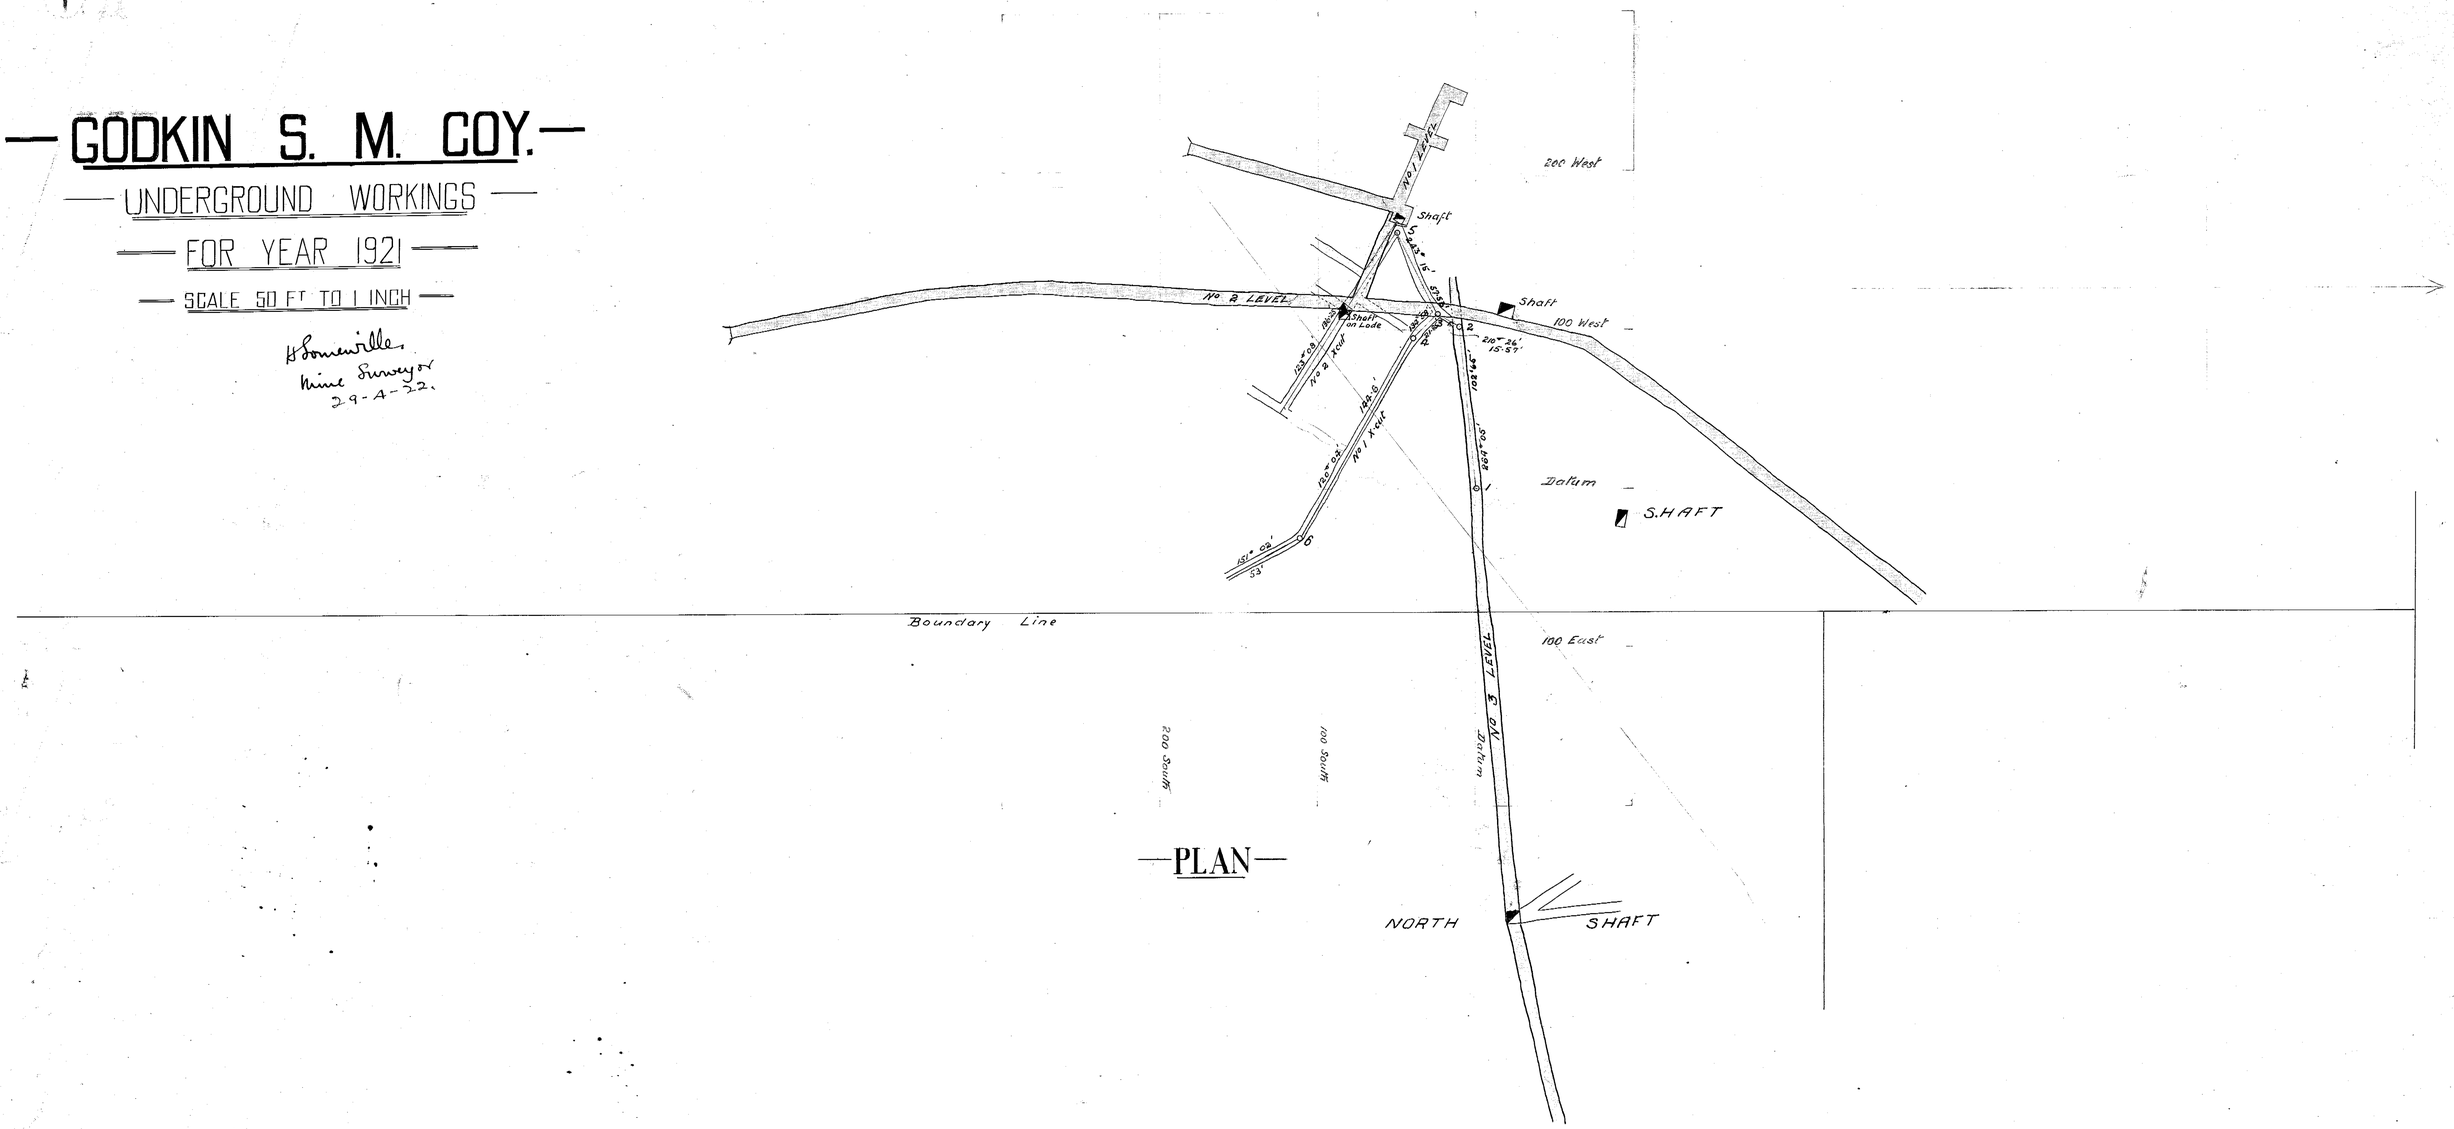

—PLAN—

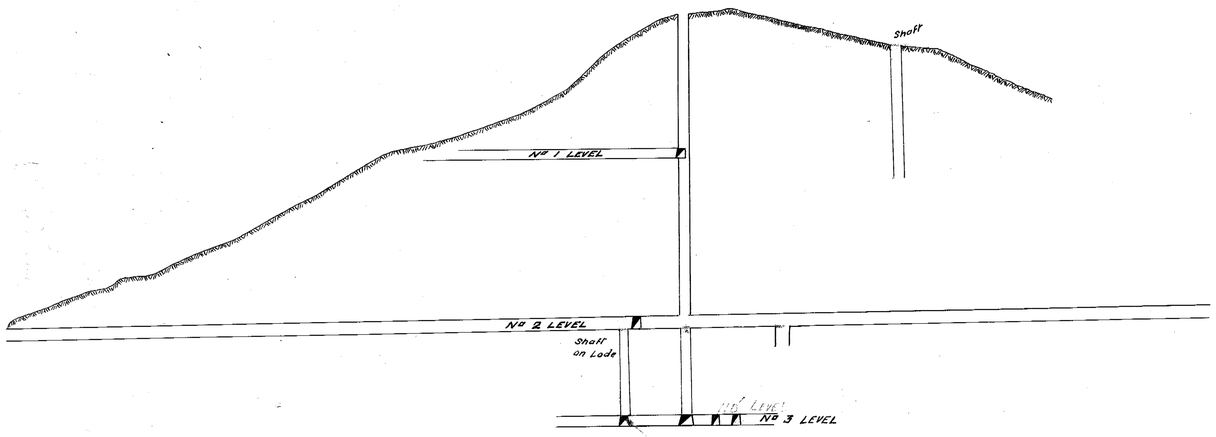

LONGITUDINAL SECTION

Projected on Plane bearing North - South

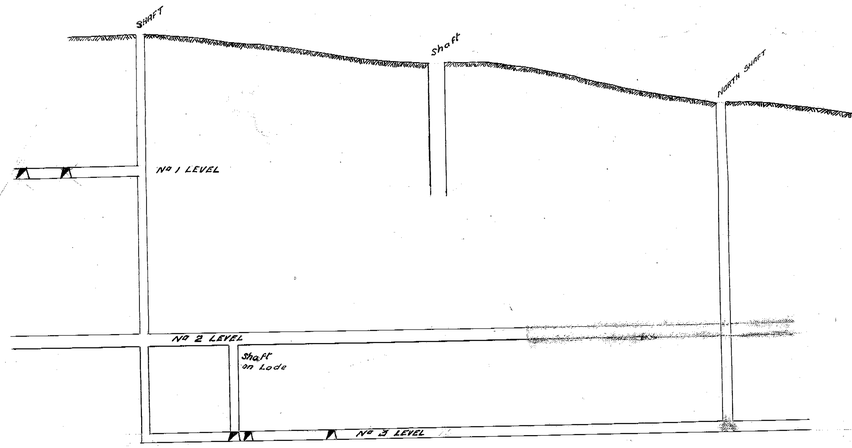

TRANSVERSE SECTION

Projected on Plane bearing East-West

47 - 03