MERRYWOOD COAL MINE

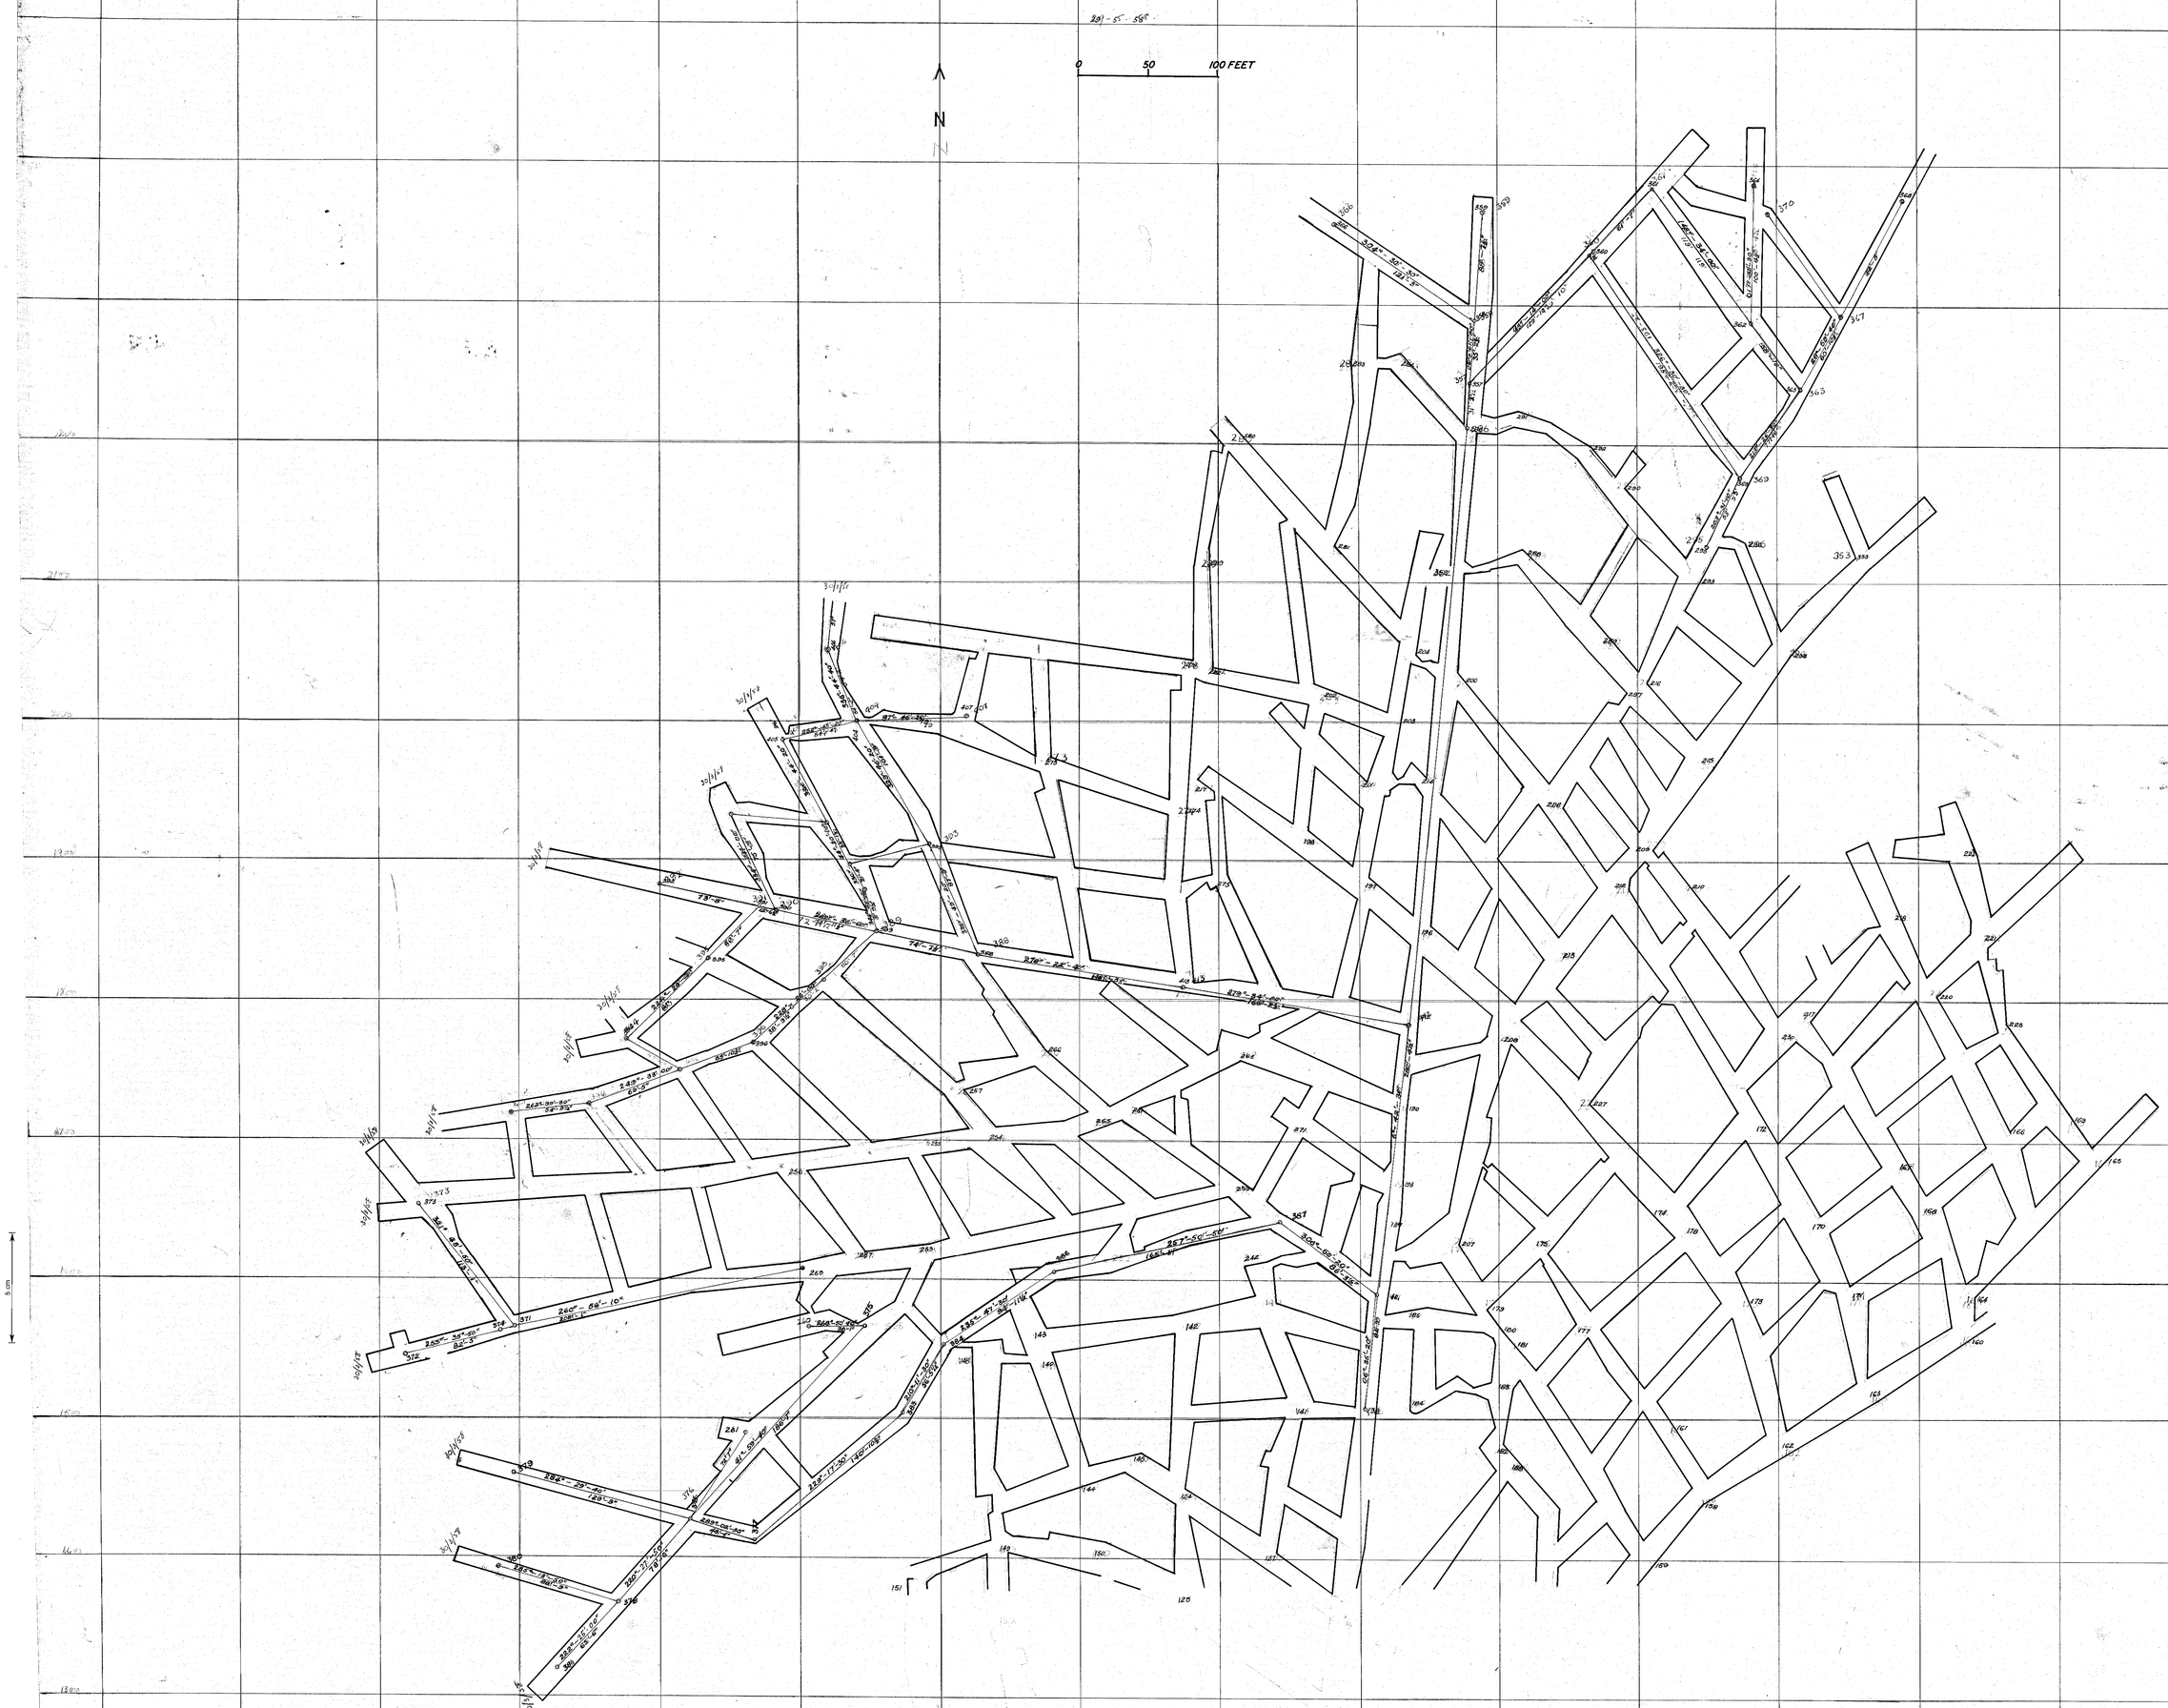

48-05