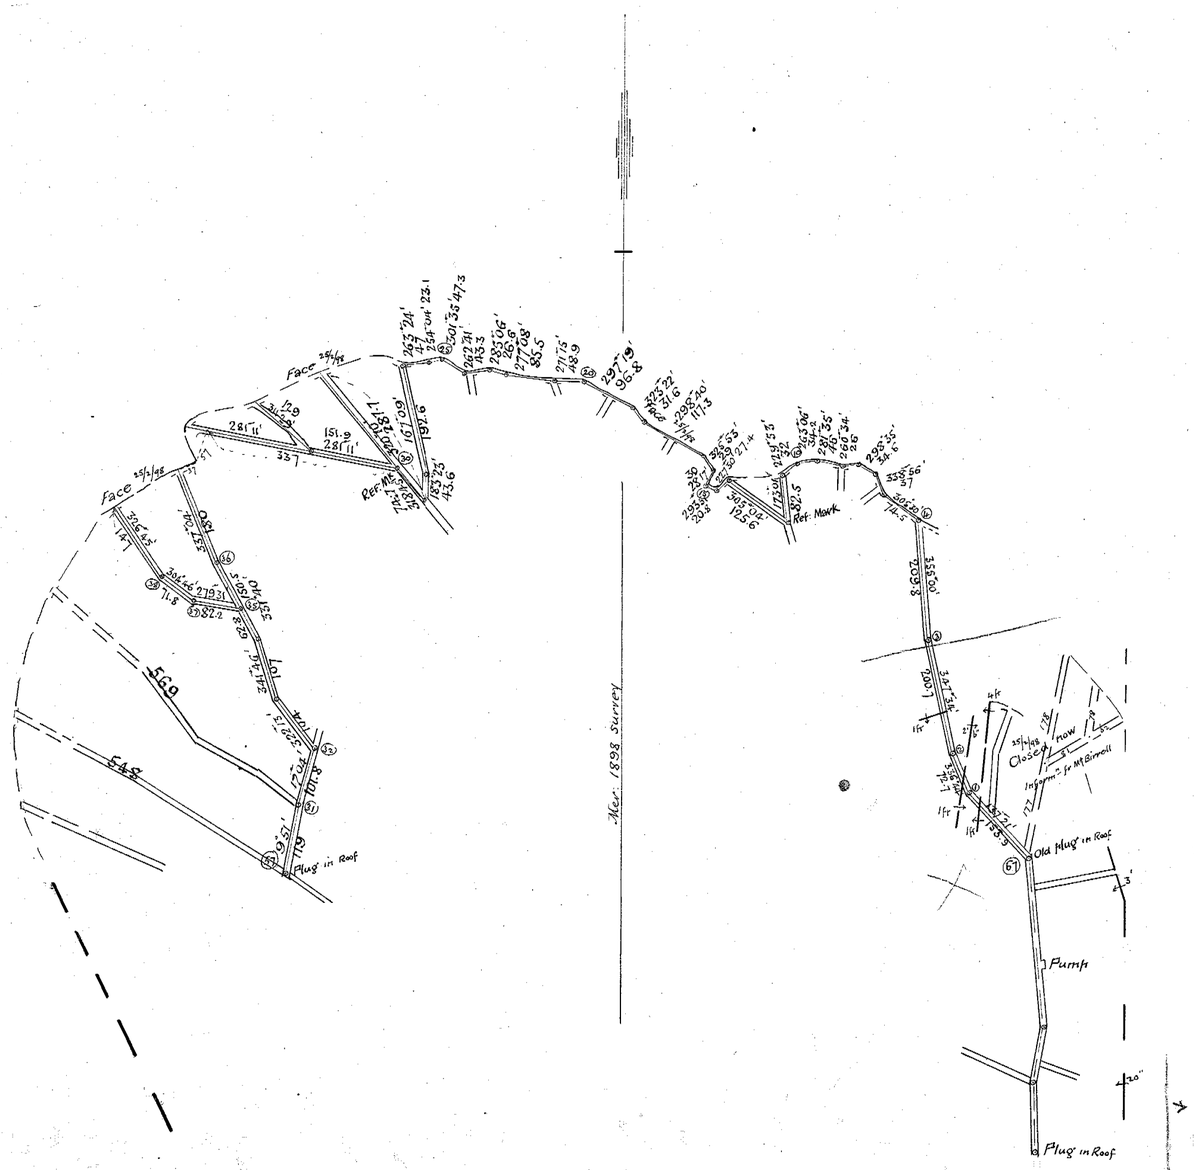

Mt NICHOLAS

COLLIERY

Scale 2 Chains to 1 inch

Survey in February 1898

Tracing for Chief Inspector of Mines

Note – An accurate close not being possible last year I have got one a little better this year. I have swung the whole of the Eastern side – a little from "Plug in Roof".

49-02

16 MAR 1898

Geo. Eddie
Mining Surveyor
16/3/98

Mount Nicholas Colliery 1898