


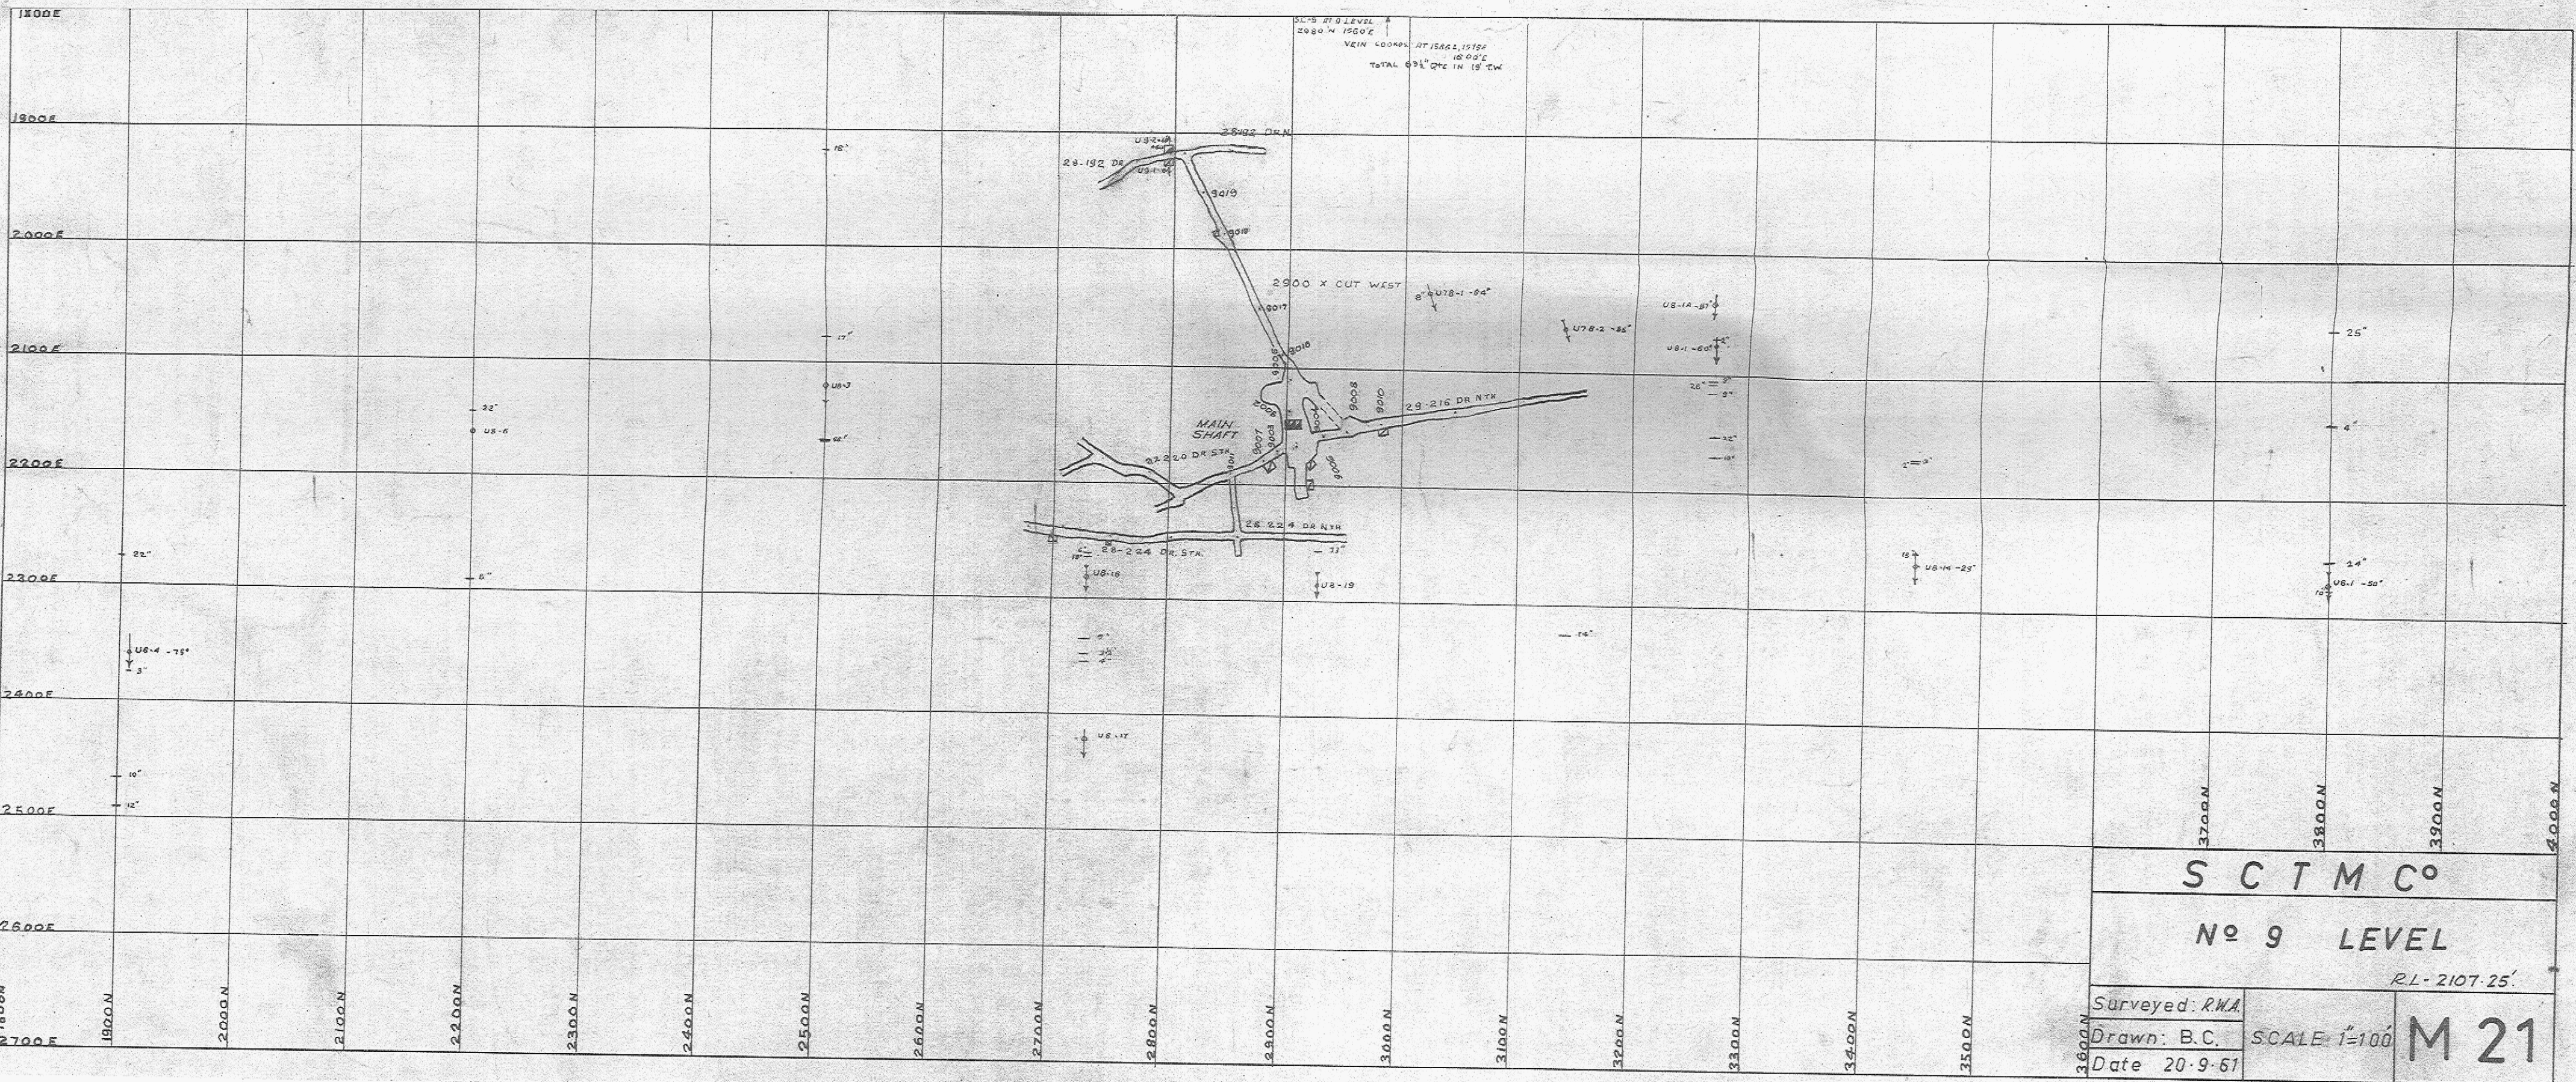

S C T M C^o

No 9 LEVEL

RL-2107-25'

Surveyed: RWA
Drawn: B.C.
Date 20-9-61

SCALE 1"=100'

M 21