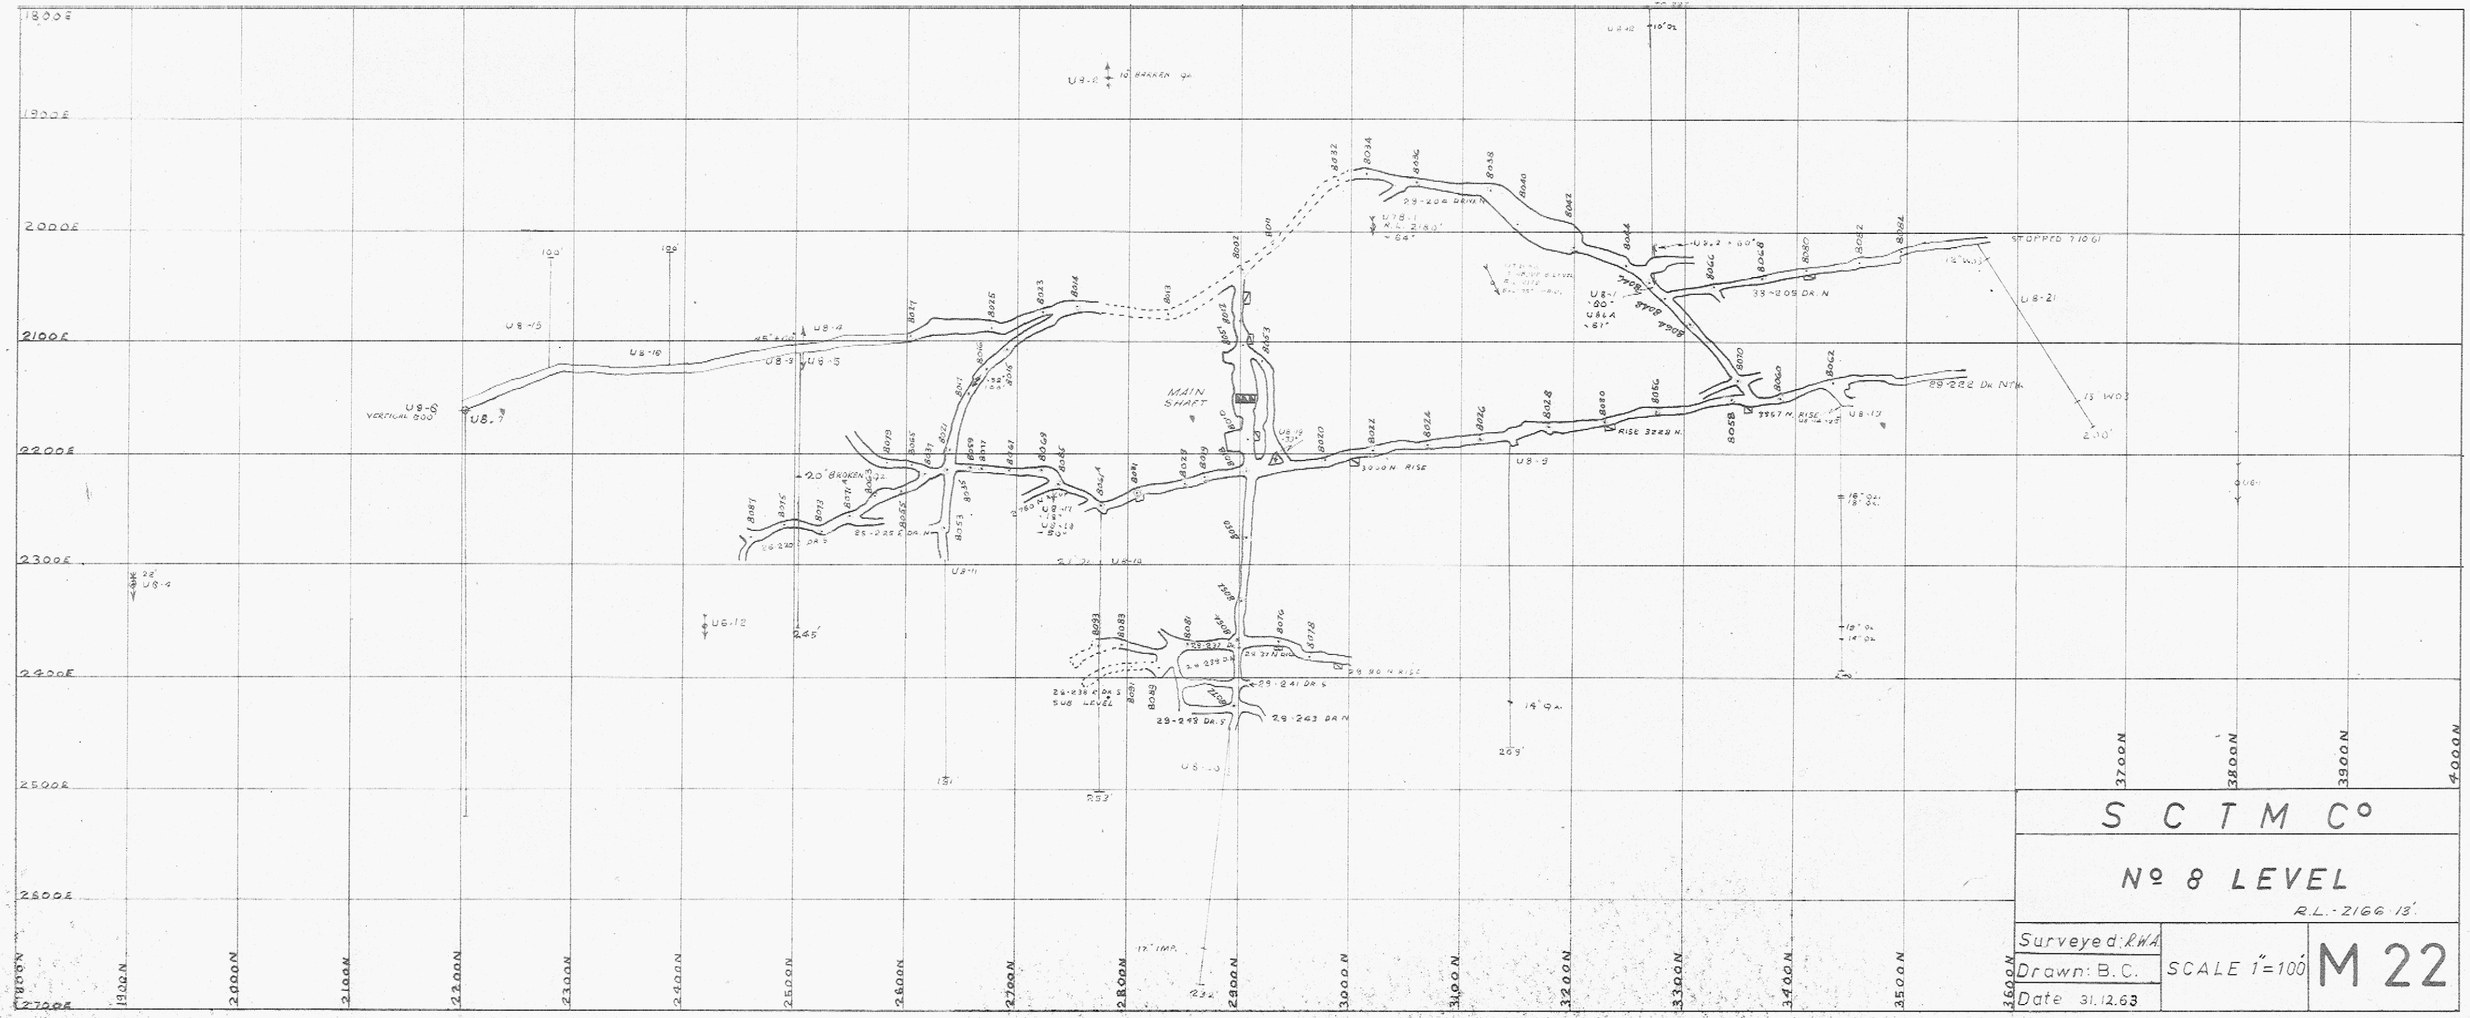
1800E
1900E
2000E
2100E
2200E
2300E
2400E
2500E
2600E
2700E
1900N
2000N
2100N
2200N
2300N
2400N
2500N
2600N
2700N
2800N
2900N
3000N
3100N
3200N
3300N
3400N
3500N
3600N
3700N
3800N
3900N
4000N
MAIN SHAFT
VERTICAL 600'
2.0' BROKEN
STOPPED 7106
29-205 DR N
29-202 DR N
29-222 DR N
RISE 3228 N
3000 N RISE
29-241 DR S
29-243 DR S
29-263 DR N
17' IMP.
S C T M C°
Nº 8 LEVEL
R.L.-2166.13'
Surveyed: R.W.A.
Drawn: B.C.
Date 31.12.63
SCALE 1"=100'
M 22