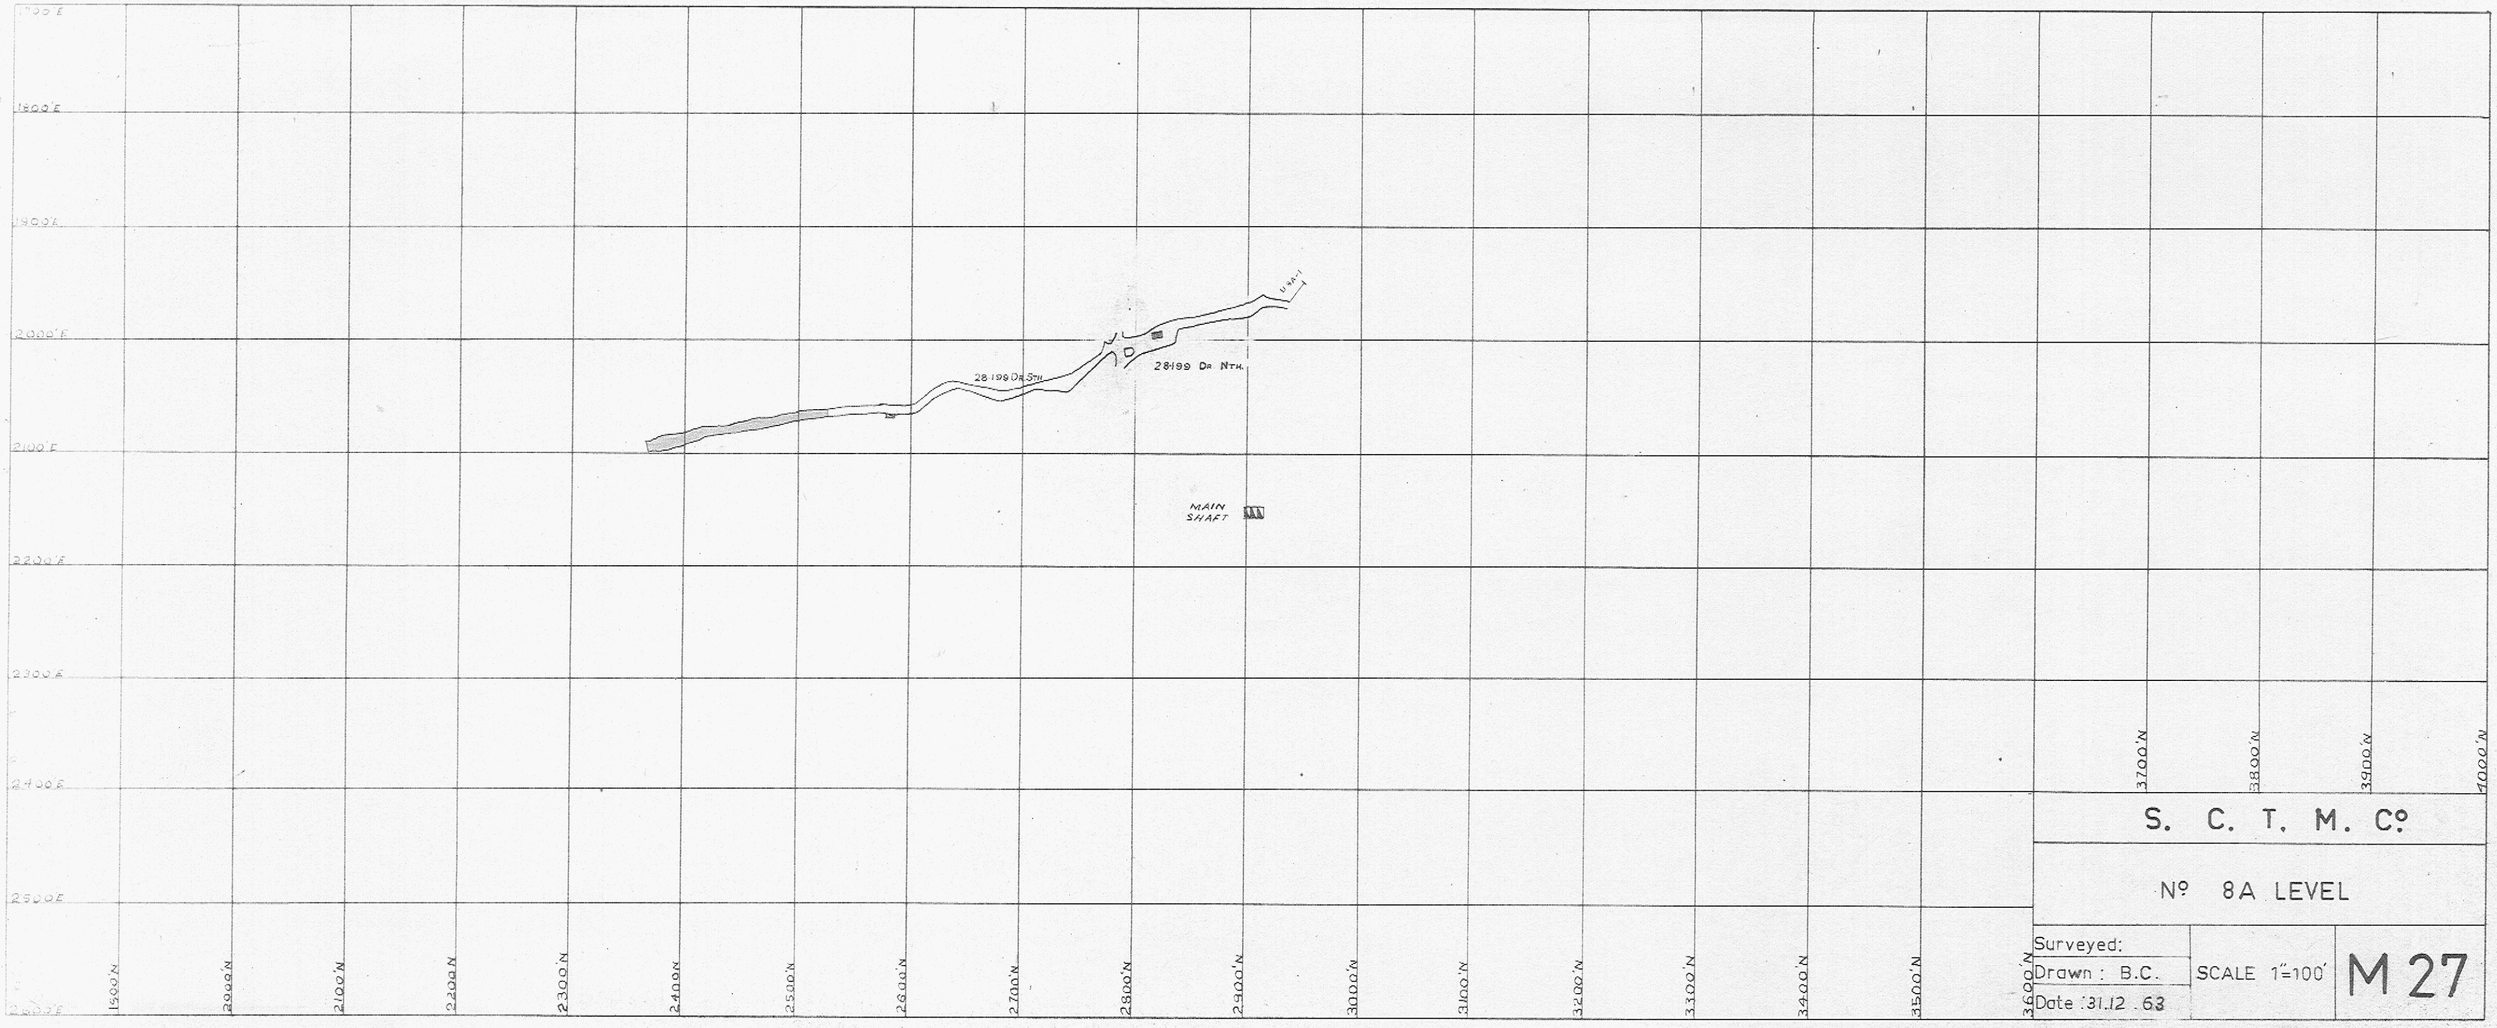
1700'E
1800'E
1900'E
2000'E
2100'E
2200'E
2300'E
2400'E
2500'E
2600'E
28198 Dr. Sth
28199 Dr Nth.
MAIN SHAFT
1500'N
2000'N
2100'N
2200'N
2300'N
2400'N
2500'N
2600'N
2700'N
2800'N
2900'N
3000'N
3100'N
3200'N
3300'N
3400'N
3500'N
3600'N
3700'N
3800'N
3900'N
4000'N
S. C. T. M. Co
Nº 8A LEVEL
Surveyed:
Drawn : B.C.
Date : 31.12 . 63
SCALE 1"=100'
M 27