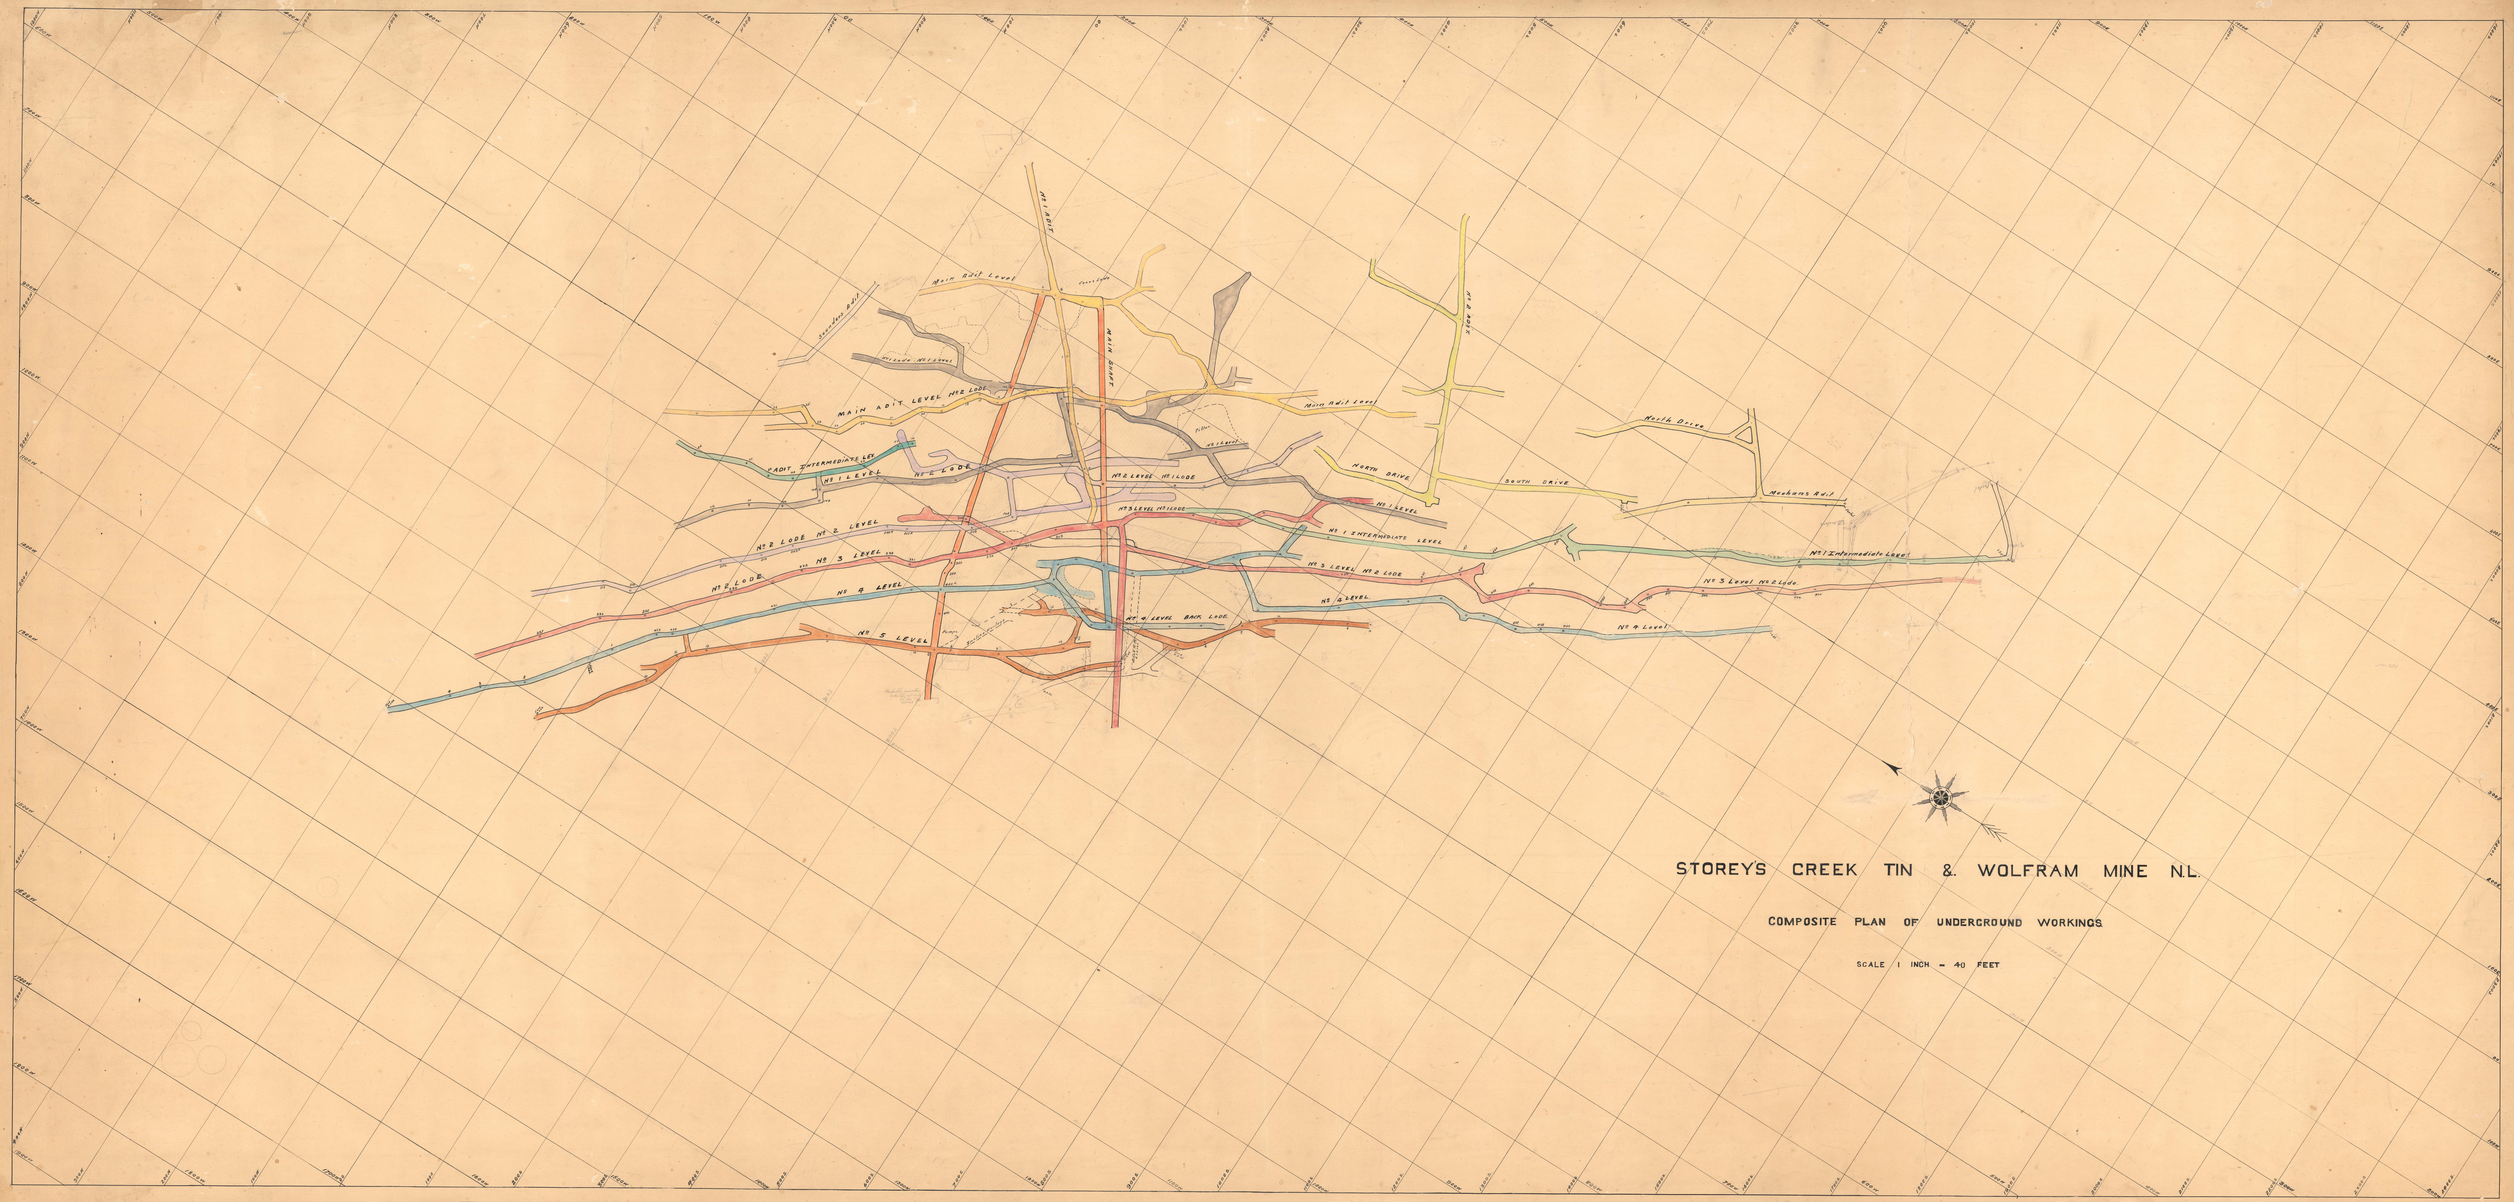
STOREYS CREEK TIN & WOLFRAM MINE N.L.
COMPOSITE PLAN OF UNDERGROUND WORKINGS
SCALE 1 INCH = 40 FEET
No 1 ADIT
MAIN SHAFT
Main Adit Level
Stevens Adit
No 1 Adit No 1 Level
MAIN ADIT LEVEL No 2 LODE
ADIT INTERMEDIATE LEV
No 1 LEVEL
No 2 LODE
No 2 LEVEL No 1 LODE
No 3 LEVEL No 1 LODE
No 2 LODE No 2 LEVEL
No 3 LEVEL
No 1 LODE
No 4 LEVEL
No 5 LEVEL
No 4 LEVEL BACK LODE
No 1 LEVEL
No 1 INTERMEDIATE LEVEL
No 3 LEVEL No 2 LODE
No 4 LEVEL
No 2 ADIT
Main Adit Level
NORTH DRIVE
SOUTH DRIVE
North Drive
Meakins Adit
No 1 Intermediate Level
No 3 Level No 2 Lode
No 4 Level