

PLAN OF UNDERGROUND WORKINGS

MT. BISCHOFF AND MT. BISCHOFF EXTENDED MINE


SCALE

100 50 0 100 200 300 400 500 FEET

LOCALITY MAP

SCALE

10 5 0 10 20 30 40 50 60 70 80 CHAINS

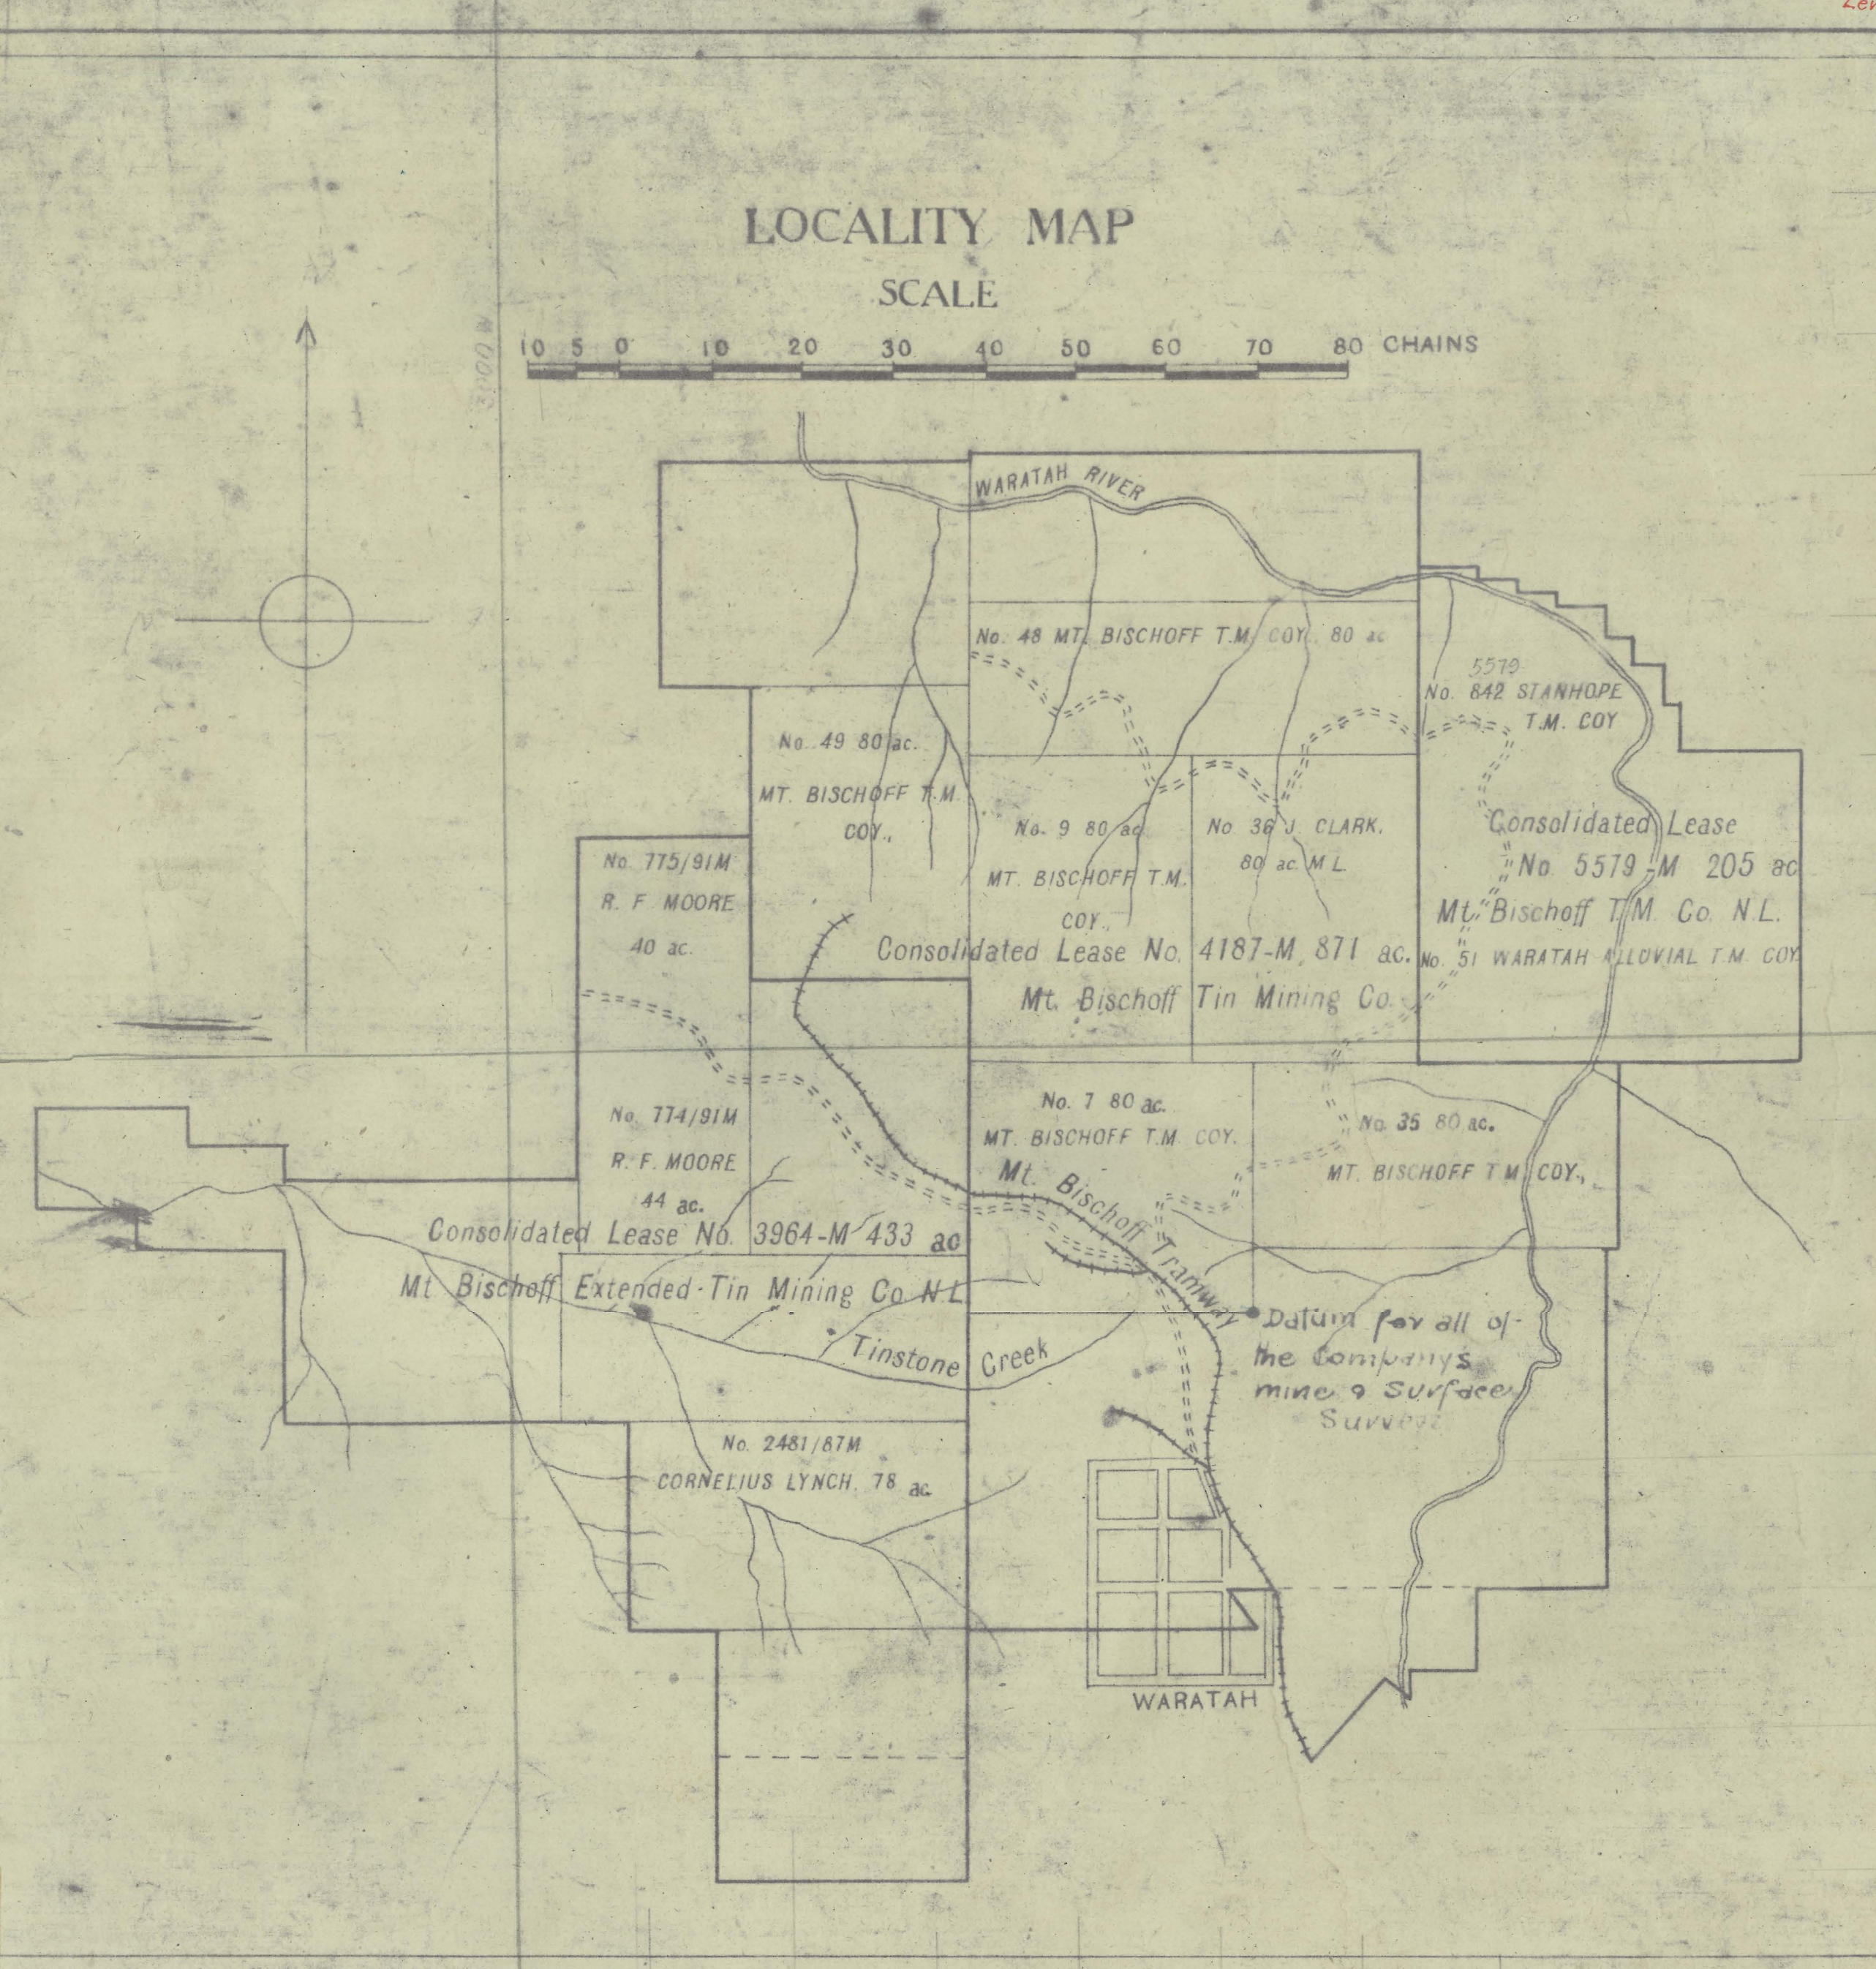

CONSOLIDATED LEASE No. 4187M 871 ac.
MT. BISCHOFF TIN MINING COMPANY

