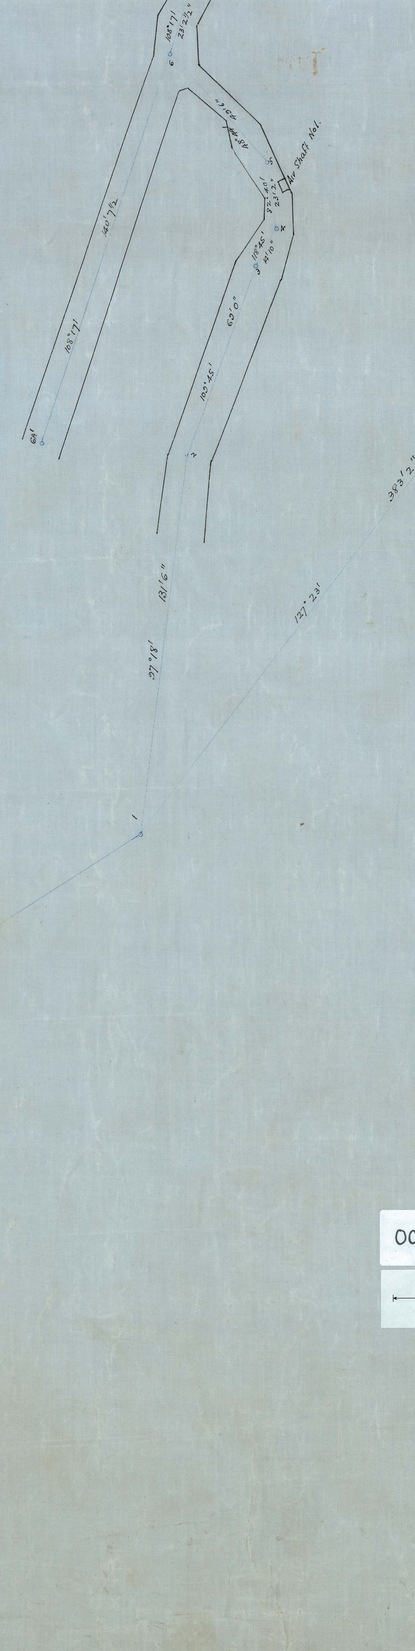

TASMANIAN CEMENT PTY, LTD.,
PLAN SHEWING LAY-OUT OF SHALE MINE LATROBE.

Scale 20 feet to an inch.

Engineer & Surveyor. Prior. to 1928 D. D. Smith

1928 Survey. being extention of work by Mr. D. D. Smith

By

Lauriel Downie
Authy Surveyor
18th March 1928.

0054_001

5 cm