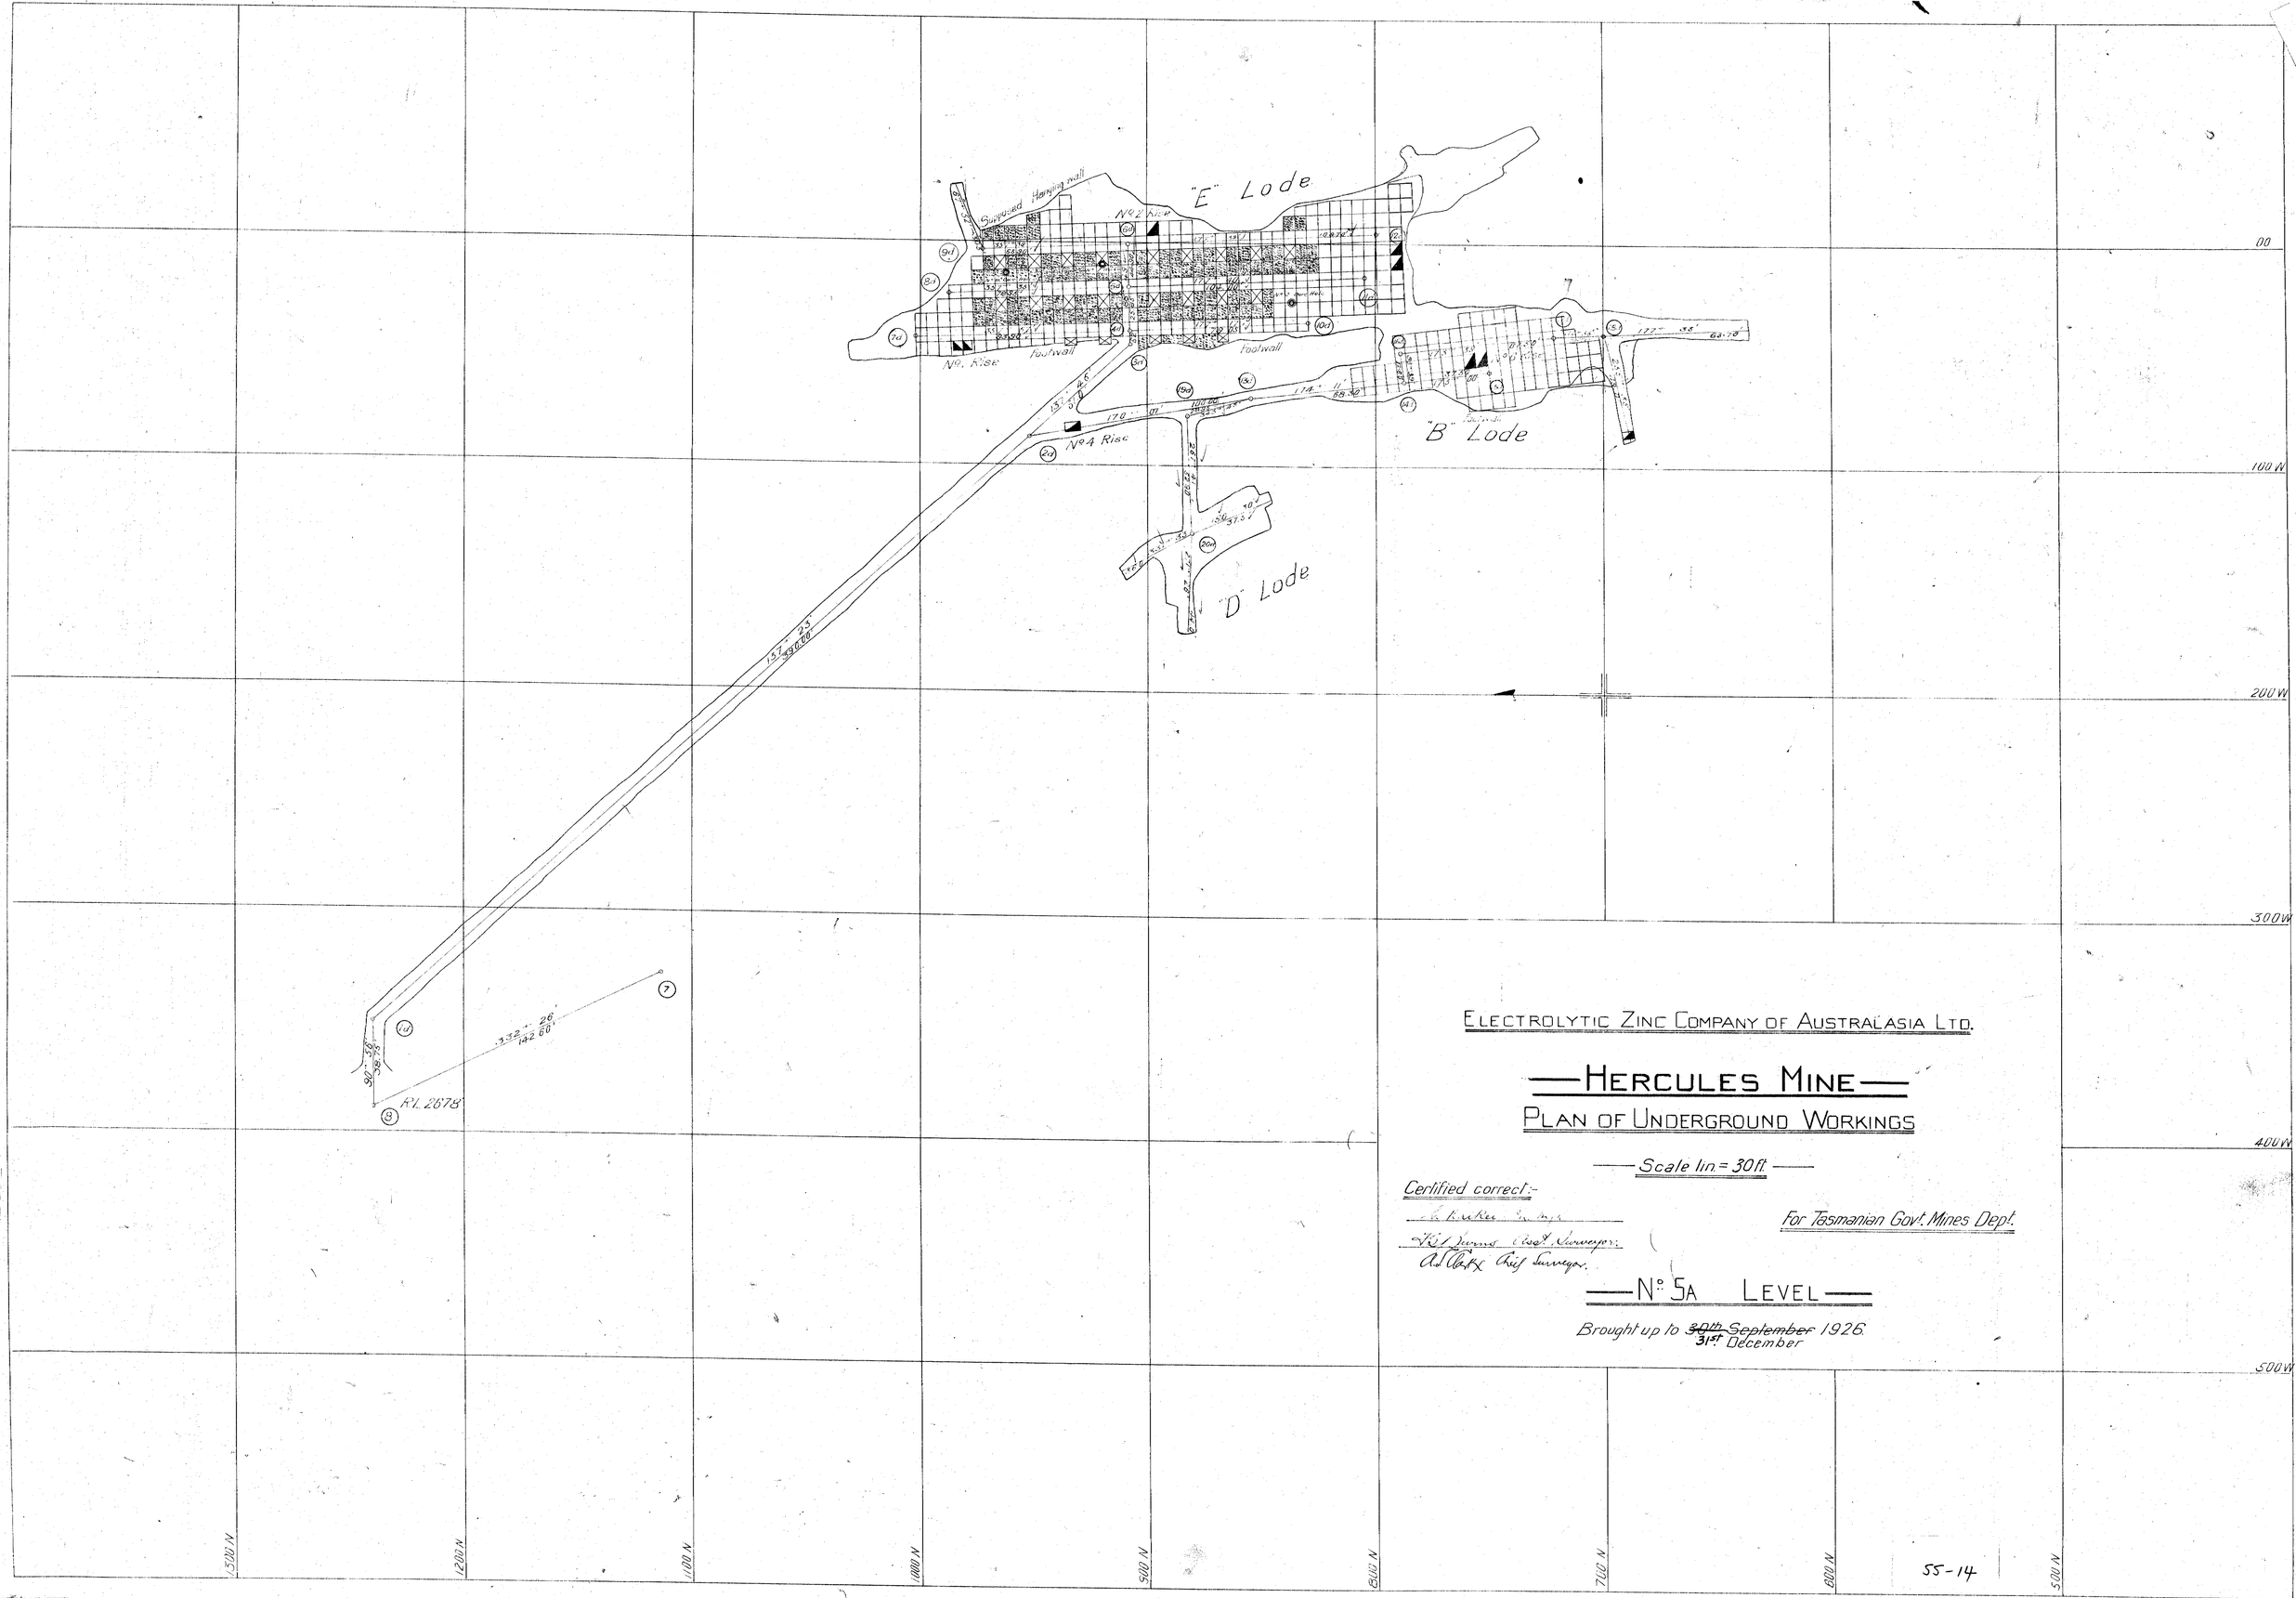

ELECTROLYTIC ZINC COMPANY OF AUSTRALASIA LTD.

HERCULES MINE

PLAN OF UNDERGROUND WORKINGS

Scale 1in = 30ft

Certified correct:-

E. L. Lukes Ass't Mgr.

W. J. Burns Ass't Surveyor.

A. S. Clark Chief Surveyor.

For Tasmanian Govt. Mines Dept.

Nº 5A LEVEL

Brought up to ~~30th September~~ 31st December 1926.

55-14

41-55