55-26

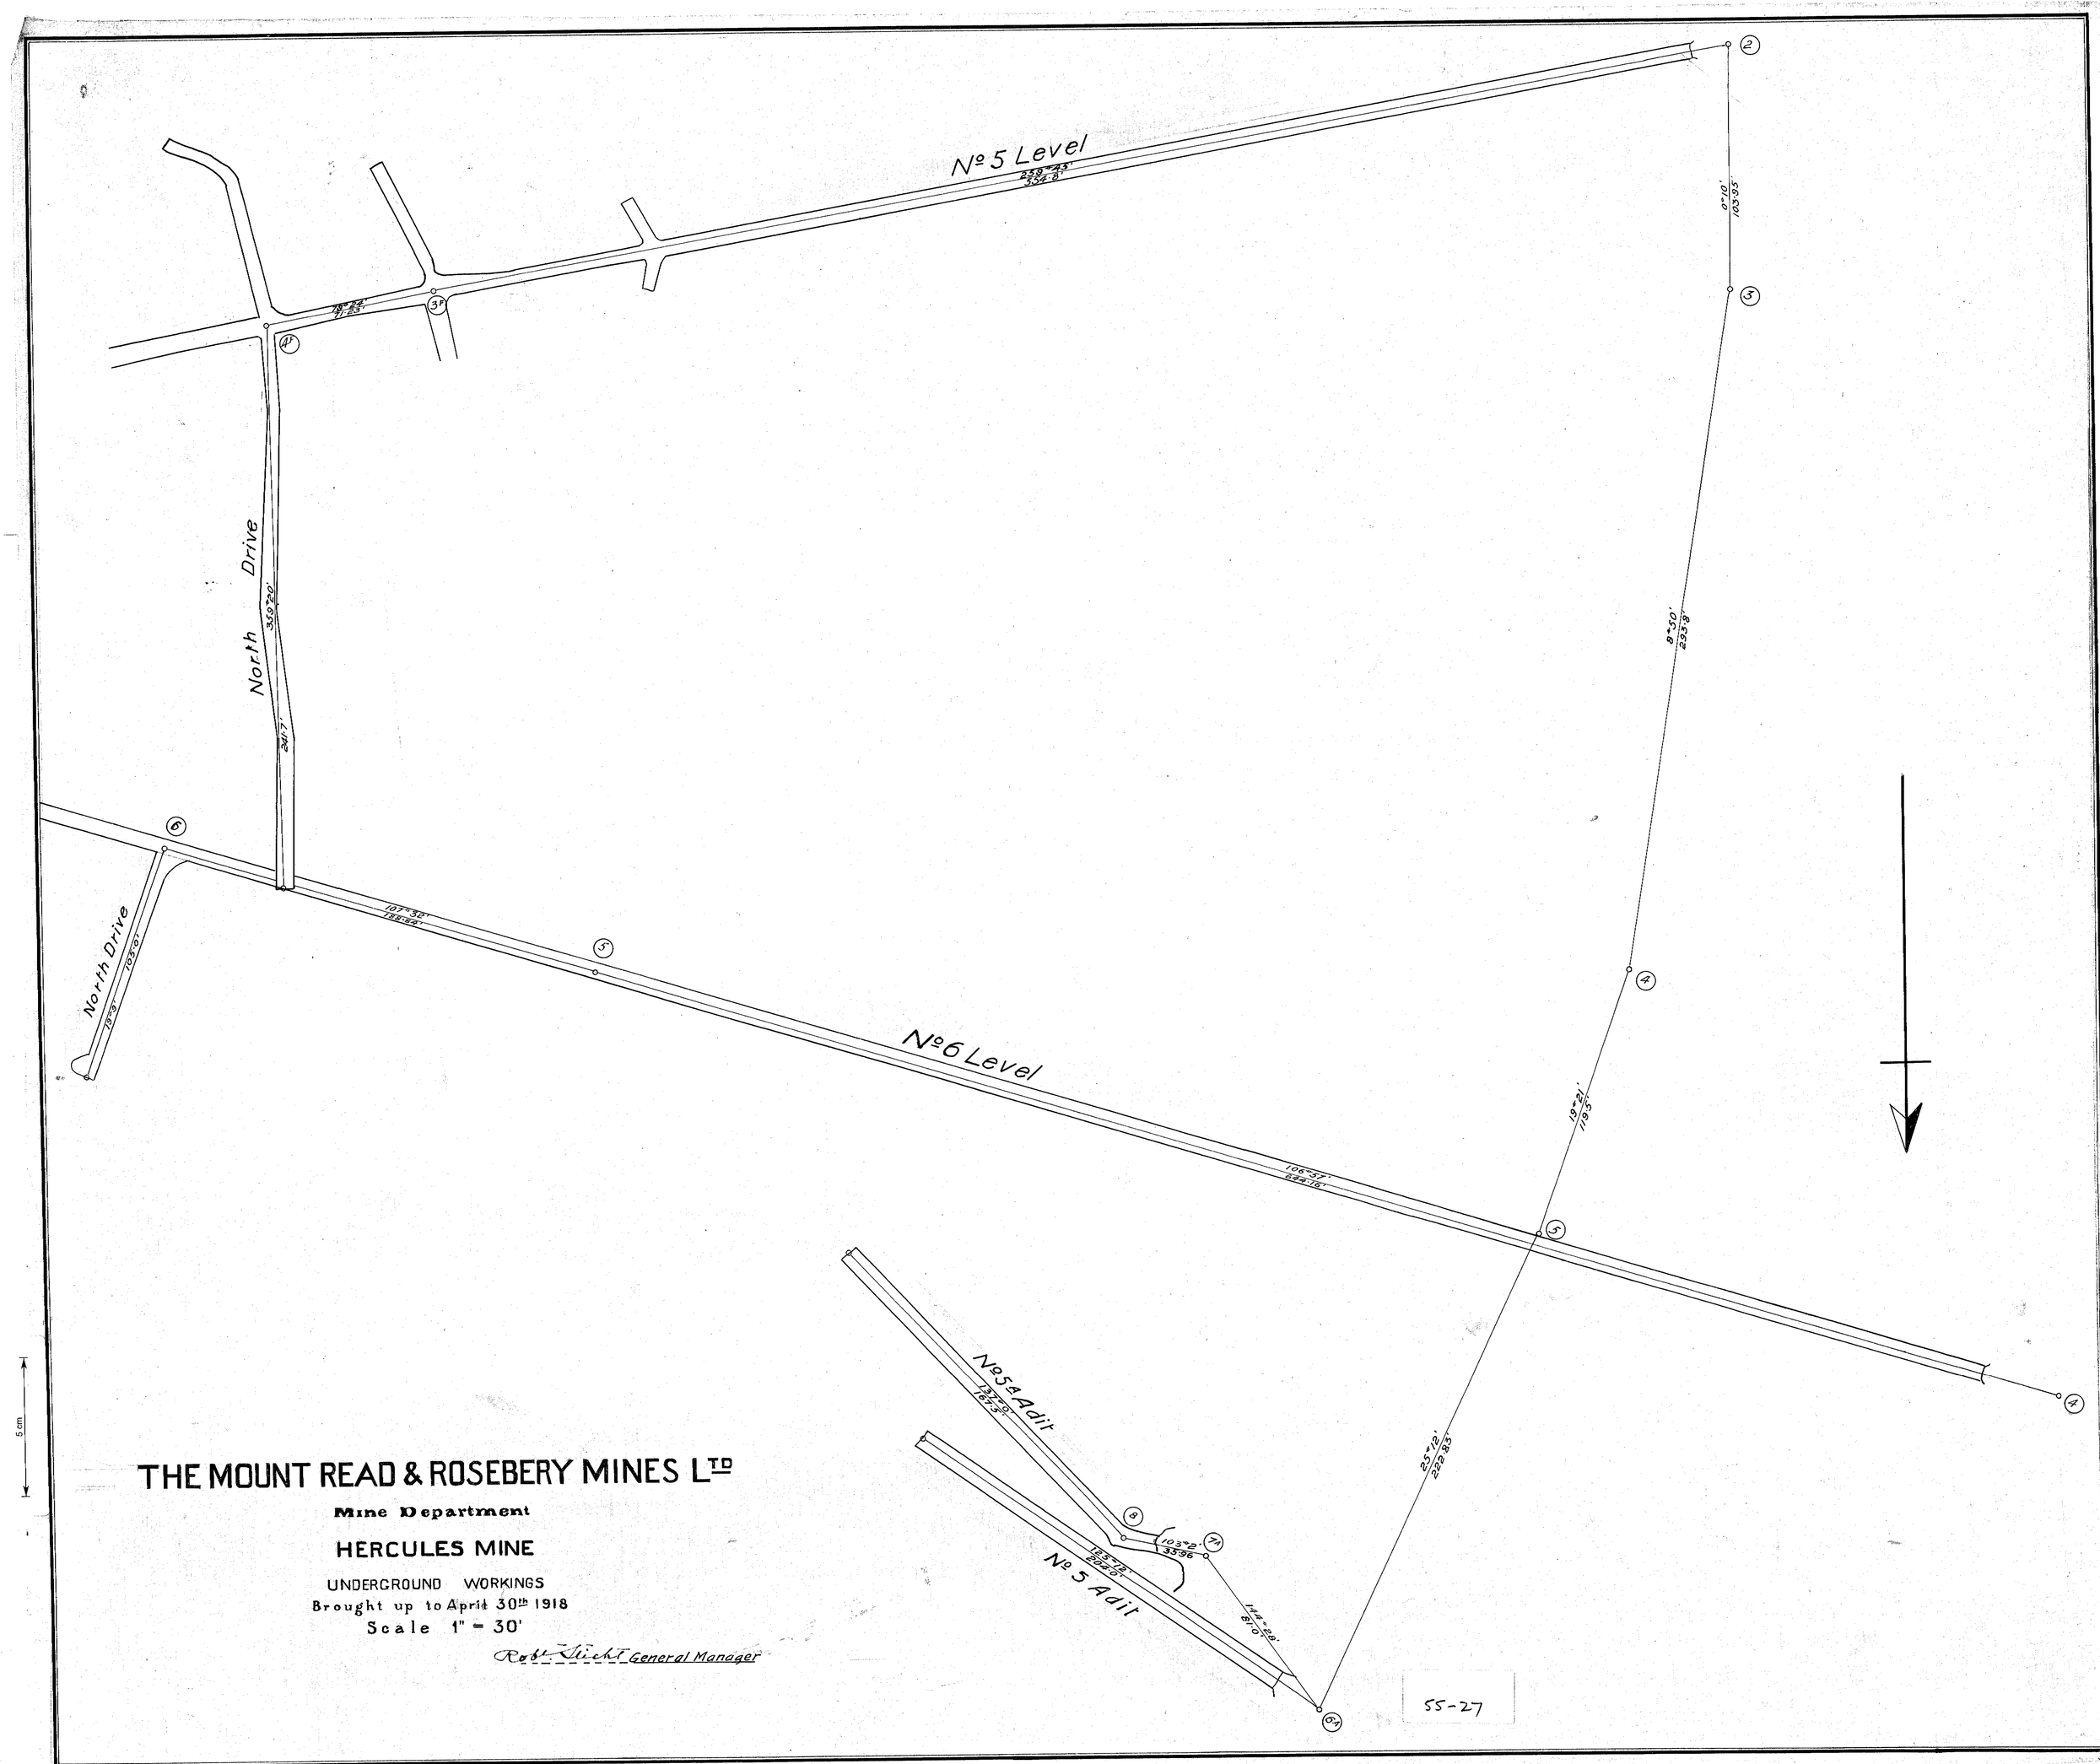
No 5 Level
259·43'
354·8'
0°10'
103·3'
8°50'
235·8'
19°21'
119·3'
25°12'
222·93'
North Drive
339°20'
241·7'
North Drive
107°32'
198·99'
19·3'
105·0'
No 6 Level
106°37'
629·16'
No 5A Adit
137·0'
167·5'
No 5 Adit
123°12'
204·0'
103°2'
35·96'
144°29'
87·0'
5 cm
THE MOUNT READ & ROSEBERY MINES LTD
Mine Department
HERCULES MINE
UNDERGROUND WORKINGS
Brought up to April 30th 1918
Scale 1" = 30'
Robt Hicht General Manager
55-27