

ELECTROLYTIC ZINC COMPANY LIMITED.


HERCULES MINE

No. 5'A and 4 LEVELS

Scale 30' to 1"

J.B.

Showing Work in Red for the year ending 3/1/22

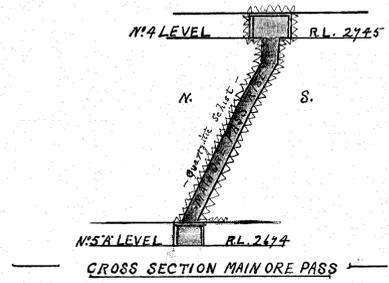

5 cm

Connections referred to C.I.M. 107-5-23