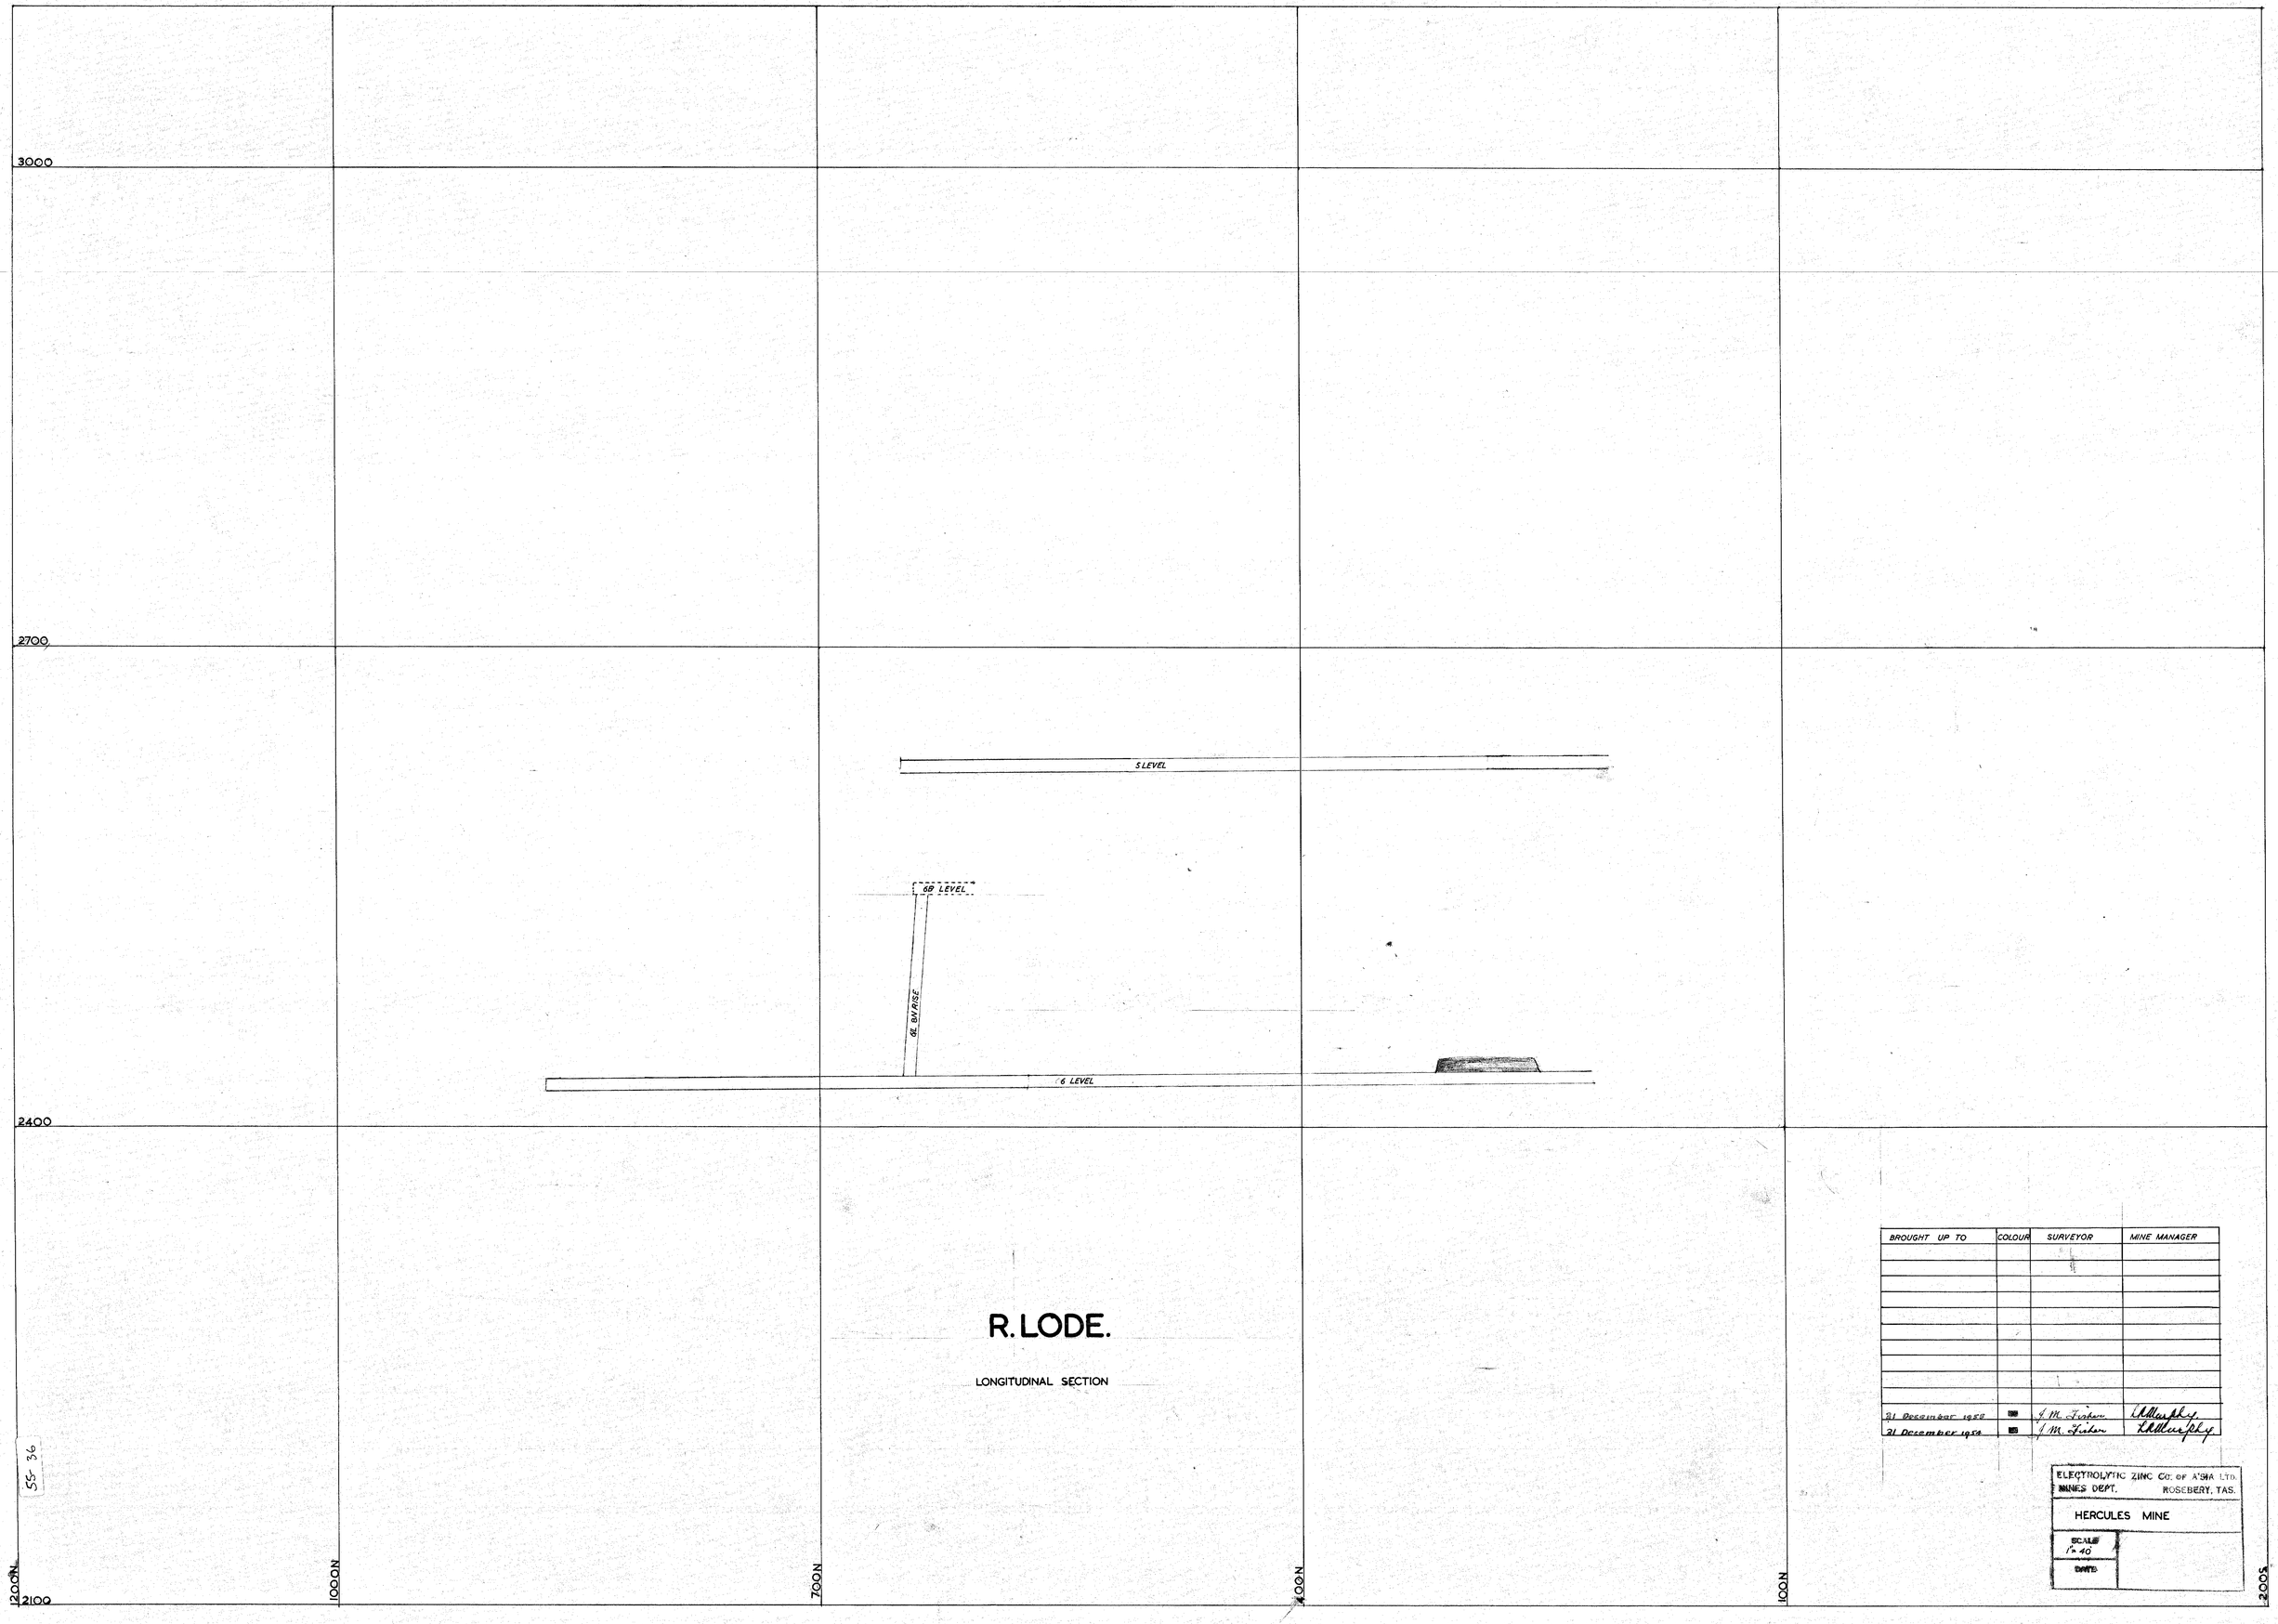
3000
2700
2400
2100
5 LEVEL
6B LEVEL
6E BY RISE
6 LEVEL
1200N
1000N
700N
400N
100N
200S
5 cm
SS 36
R. LODE.
LONGITUDINAL SECTION
BROUGHT UP TO
COLOUR
SURVEYOR
MINE MANAGER
31 December 1958
J. M. Liston
L. A. Murphy
31 December 1959
J. M. Liston
L. A. Murphy
ELECTROLYTIC ZINC Co. OF A'SIA LTD.
MINES DEPT.
ROSEBERY, TAS.
HERCULES MINE
SCALE
1" = 40'
DATE