


55-43

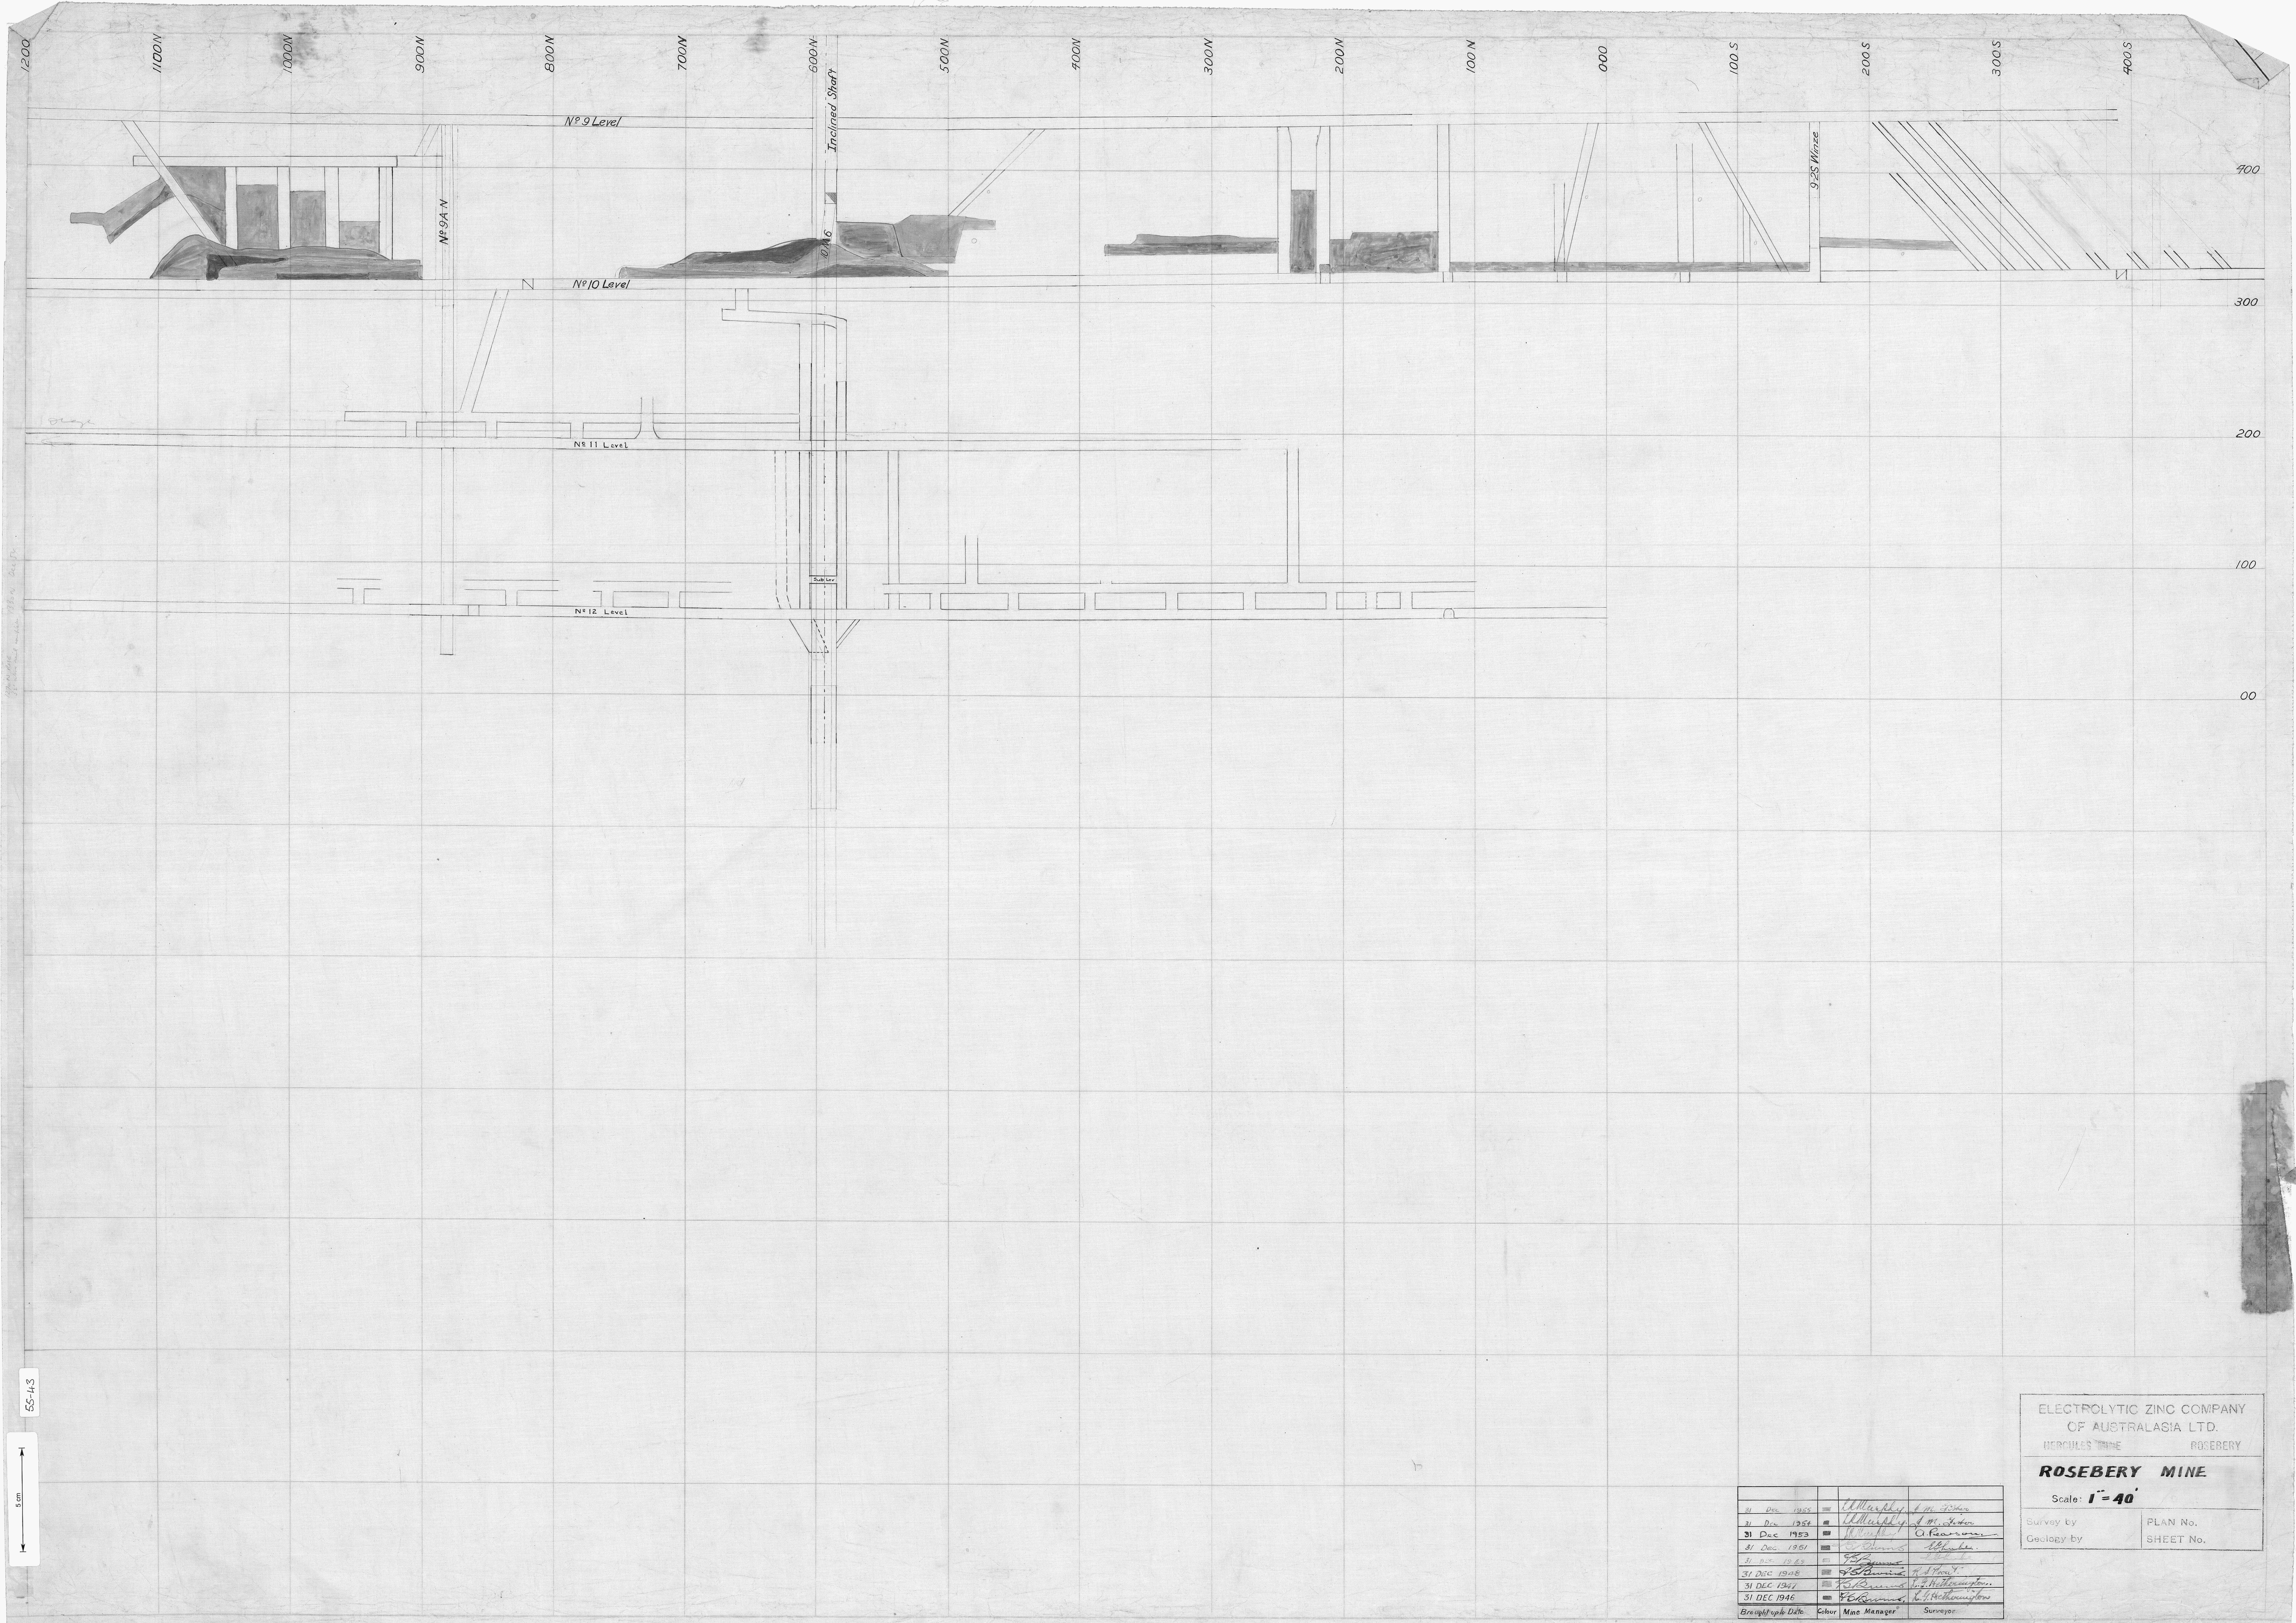

55-43

5 cm

31 Dec 1955	■	W. Murphy	L. M. Jones
31 Dec 1954	■	W. Murphy	L. M. Jones
31 Dec 1953	■	W. Murphy	A. Pearson

Brought up by Date Colour Mine Manager Surveyor

ELECTROLYTIC ZINC COMPANY
OF AUSTRALASIA LTD.
ROSEBERY MINE
Scale: 1" = 40'
Survey by PLAN No.
Geology by SHEET No.