


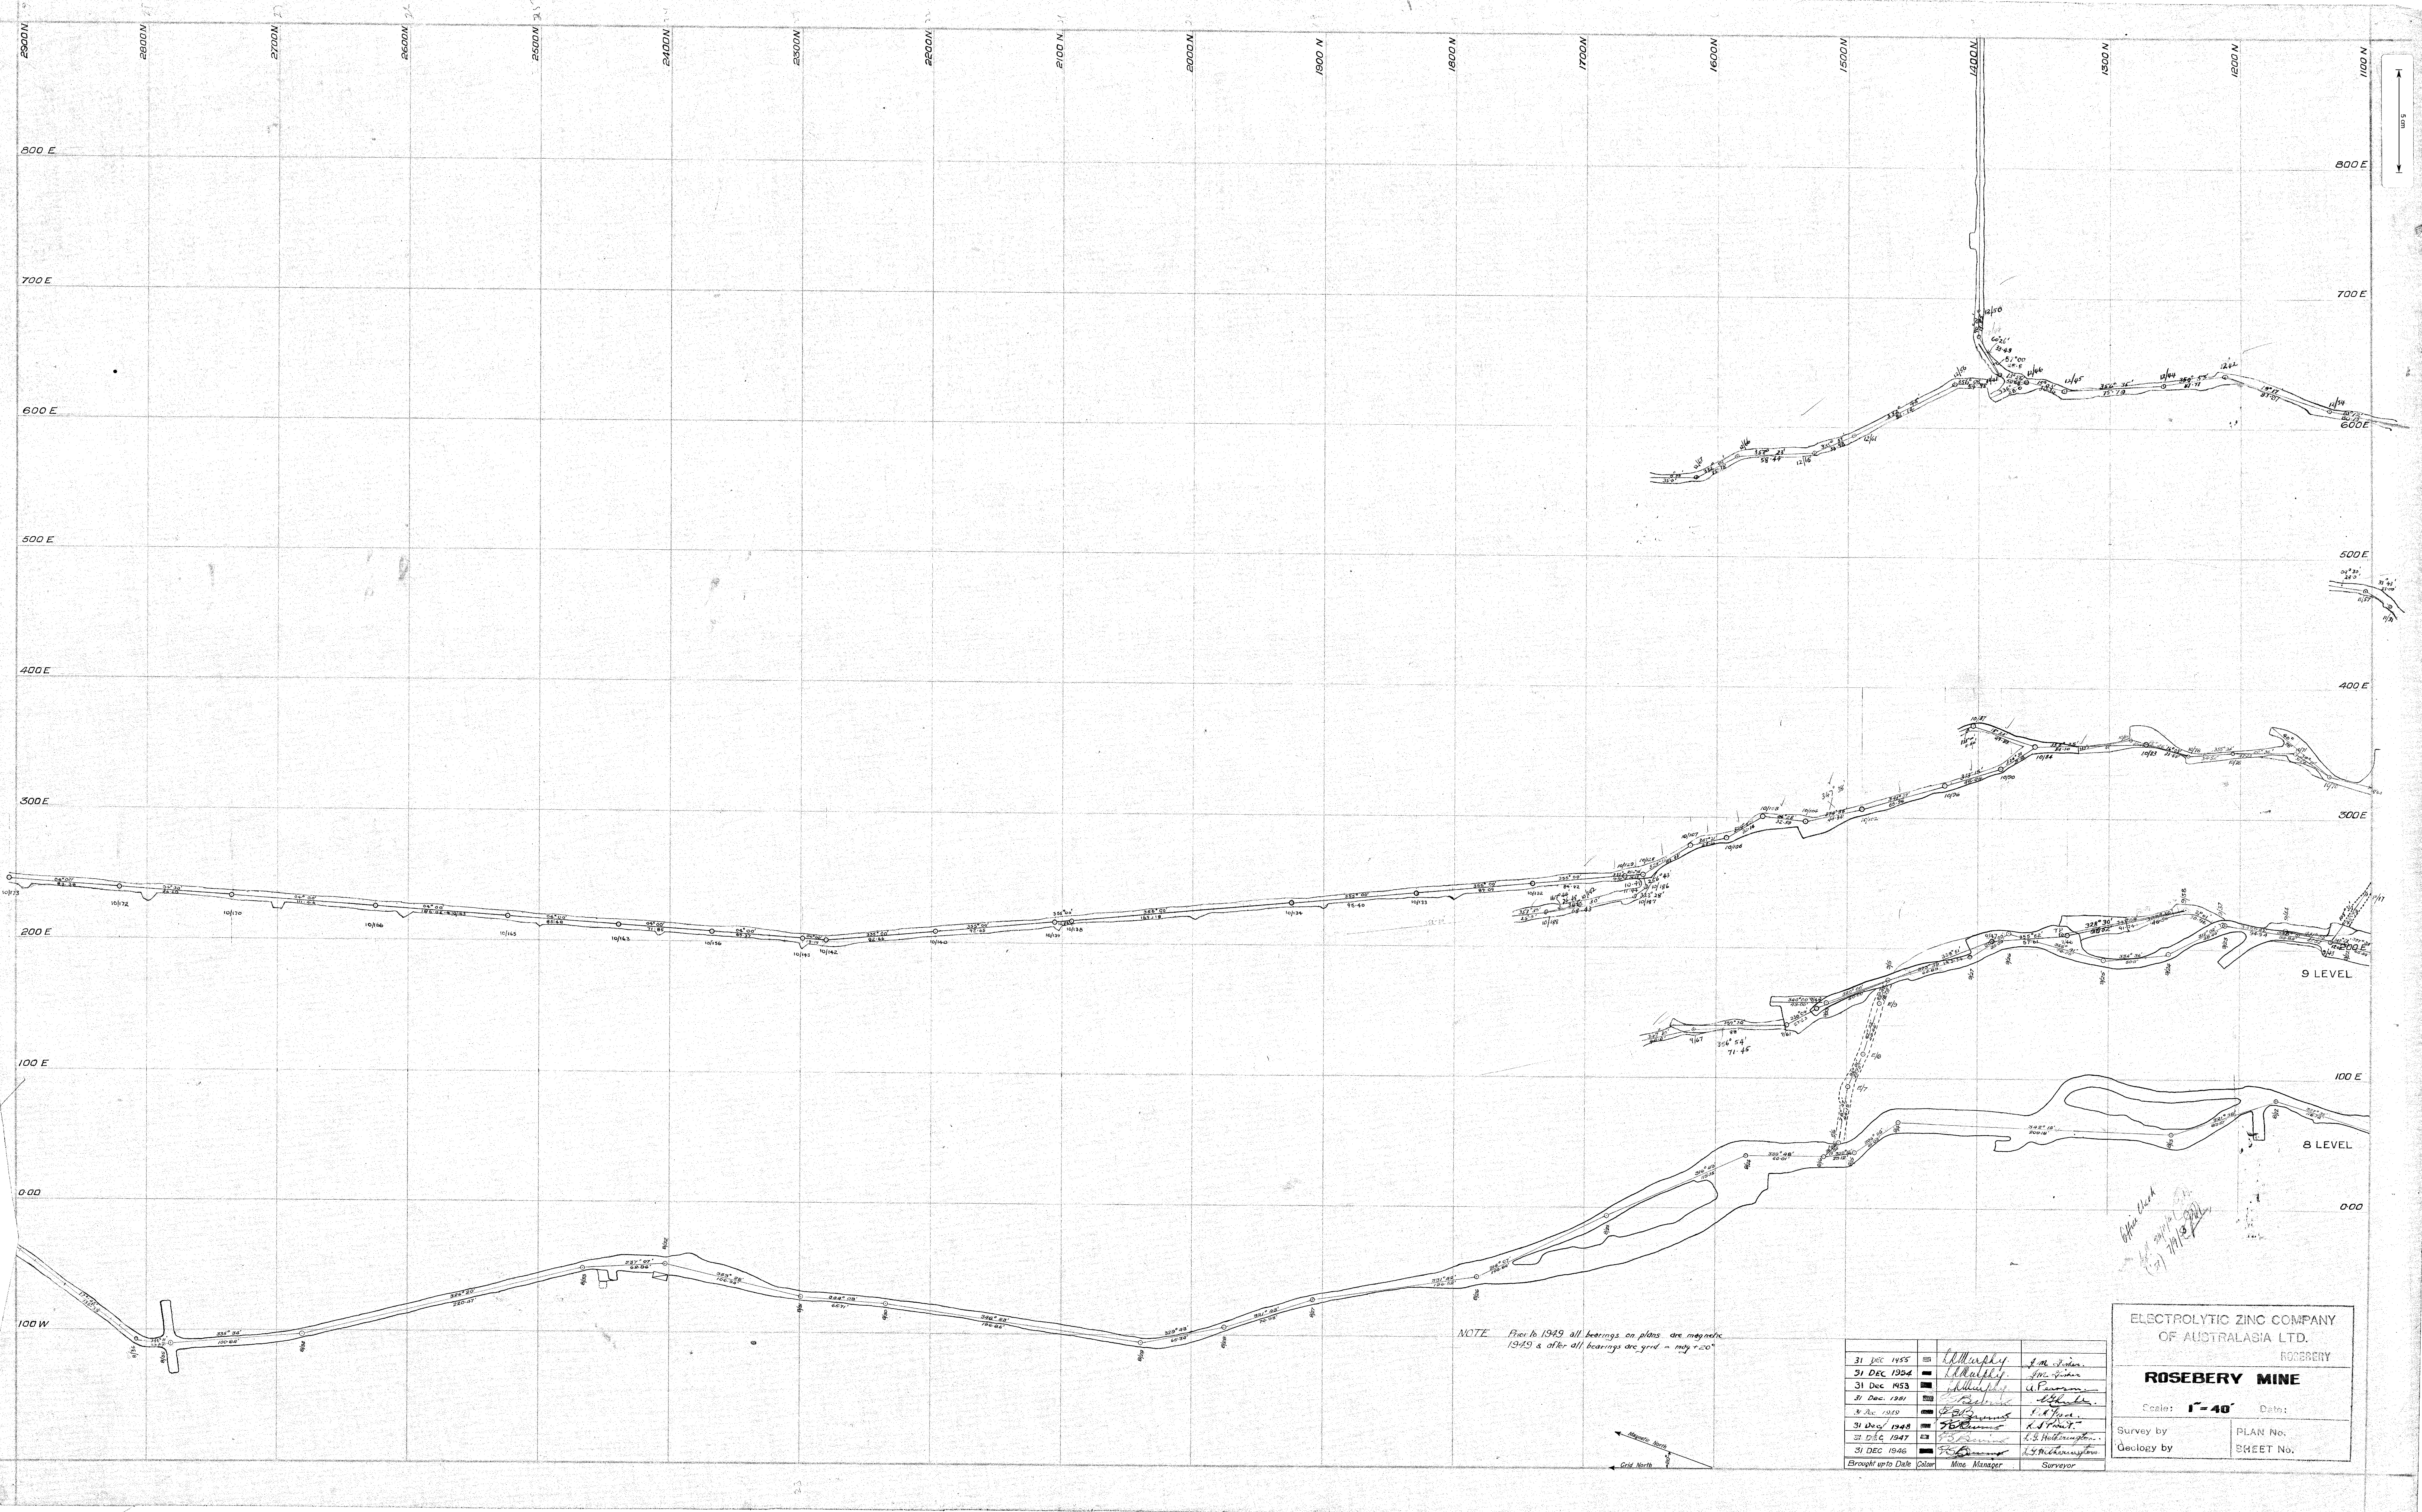

NOTE Prior to 1949 all bearings on plans are magnetic  
1949 & after all bearings are grid - a mag.  $\approx 20^\circ$

|                    |     |           |             |
|--------------------|-----|-----------|-------------|

ELECTROLYTIC ZINC COMPANY  
OF AUSTRALASIA LTD.  
ROSEBERY

ROSEBERY MINE

Scale: 1" = 40' Date:

Survey by PLAN No.

Geology by SHEET No.