ELECTROLYTIC ZINC COMPANY OF AUSTRALASIA LTD.

ROSEBERY MINE

LONGITUDINAL SECTION

SCALE 40 FT. TO 1 IN.

Note - Datum = Sea level

Work done from ▬ to ▬ shown in red

Drawing and tracing by F.S.Evans 1938-47

J.A.Hetherington 1946 — J.M.Fisher 1954

R.Grant 1948 — J.M.Fisher 1965

Chief Surveyor

Mine Manager

SHEET No 1
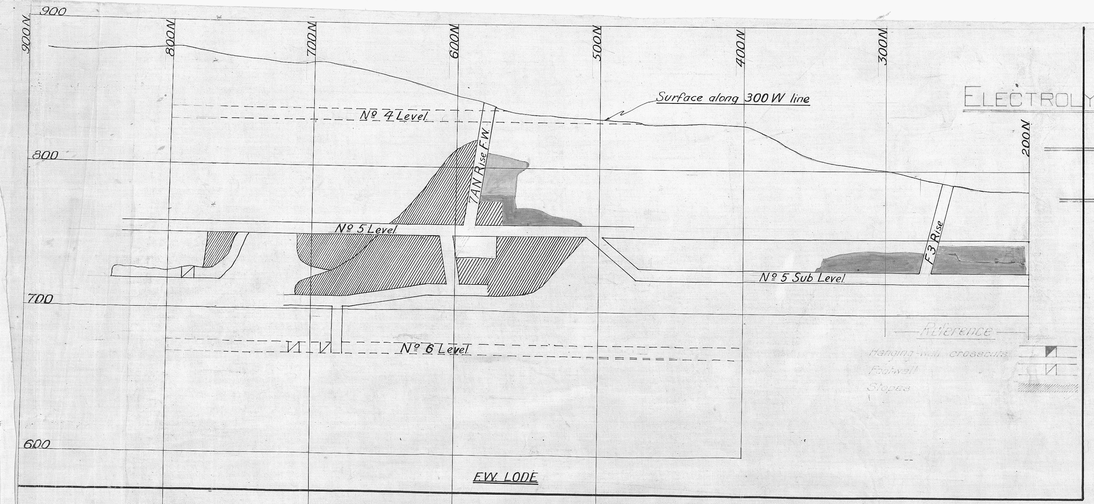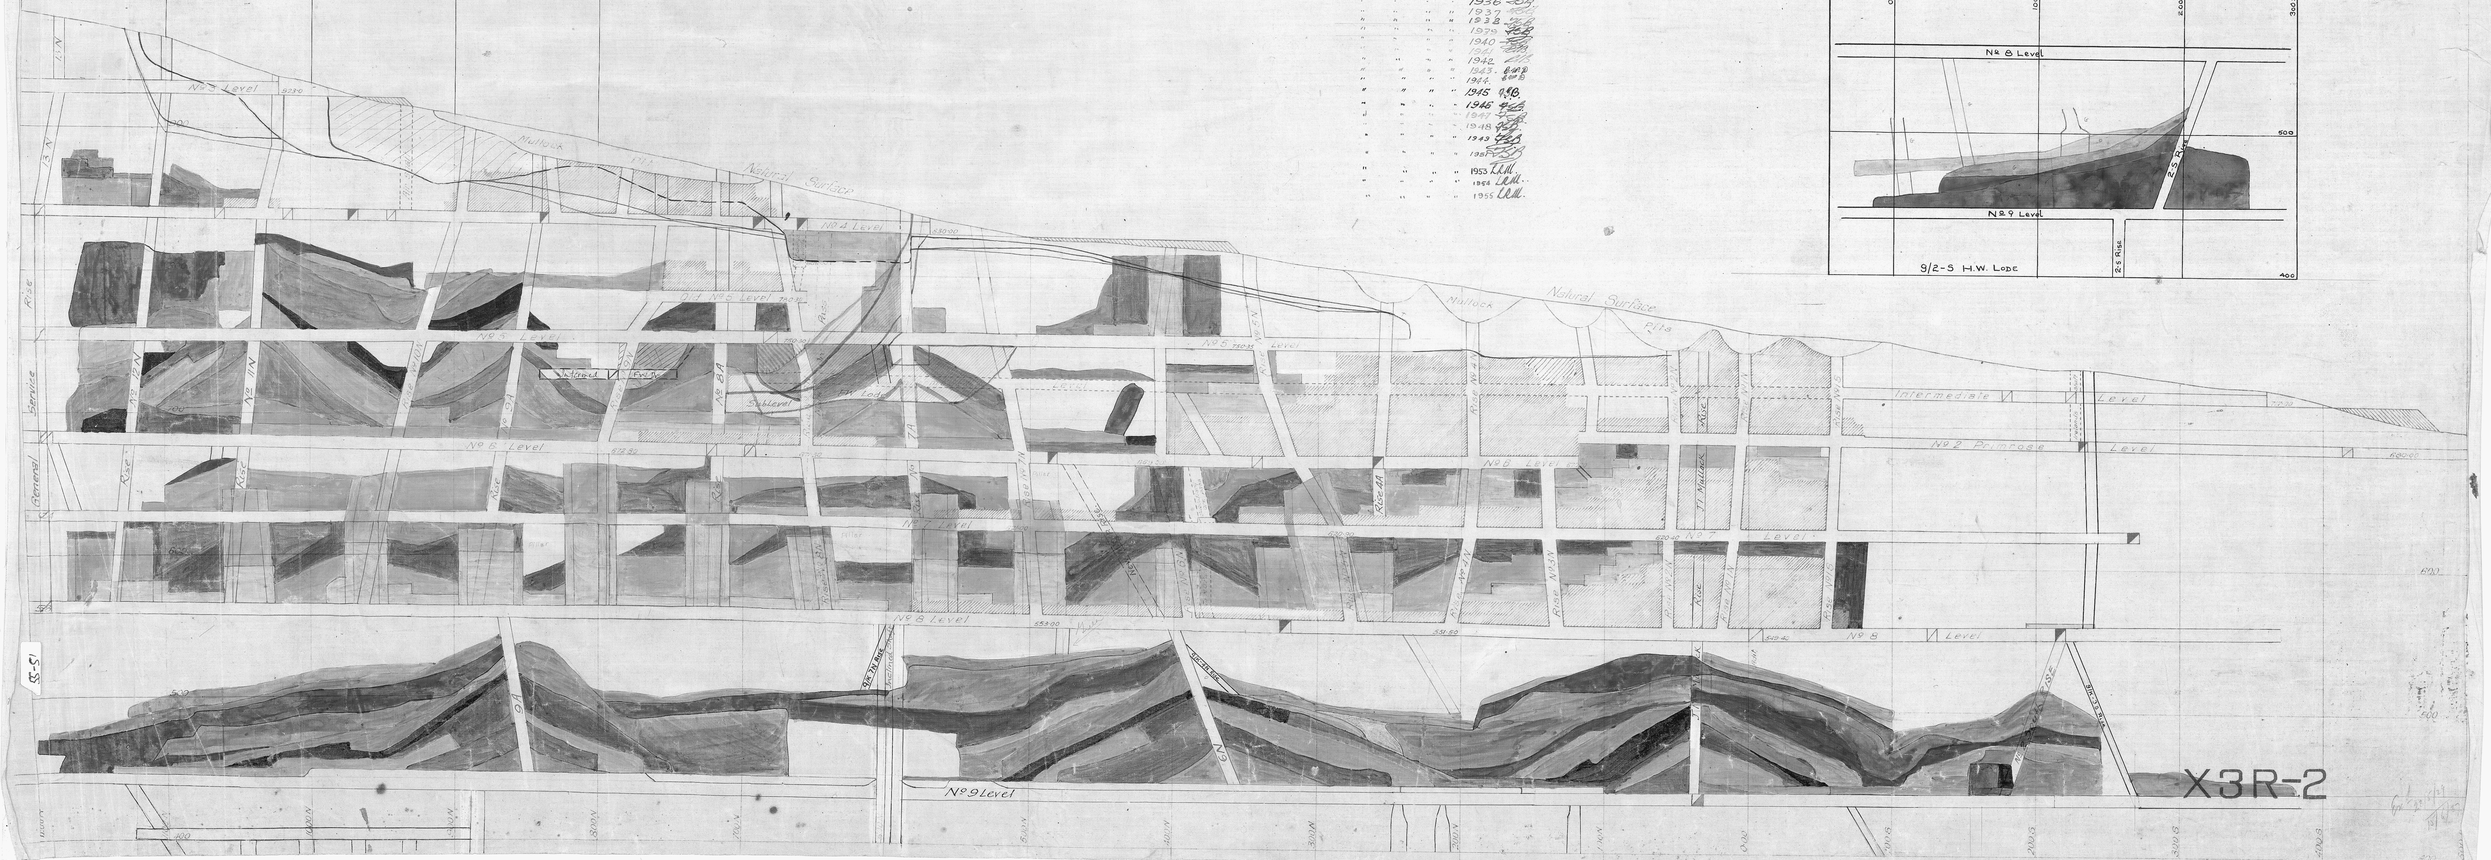
Brought up to 31st Dec 1928	
Brought up to 31st Dec. 1929	L.B.
" " " "	1930 AB
" " " "	1936
" " " "	1937
" " " "	1938
" " " "	1939
" " " "	1940
" " " "	1942
" " " "	1943
" " " "	1944
" " " "	1945
" " " "	1946
" " " "	1947
" " " "	1948
" " " "	1949
" " " "	1950
" " " "	1953 LLM.
" " " "	1954 LLM.
" " " "	1955 LLM.