55-52

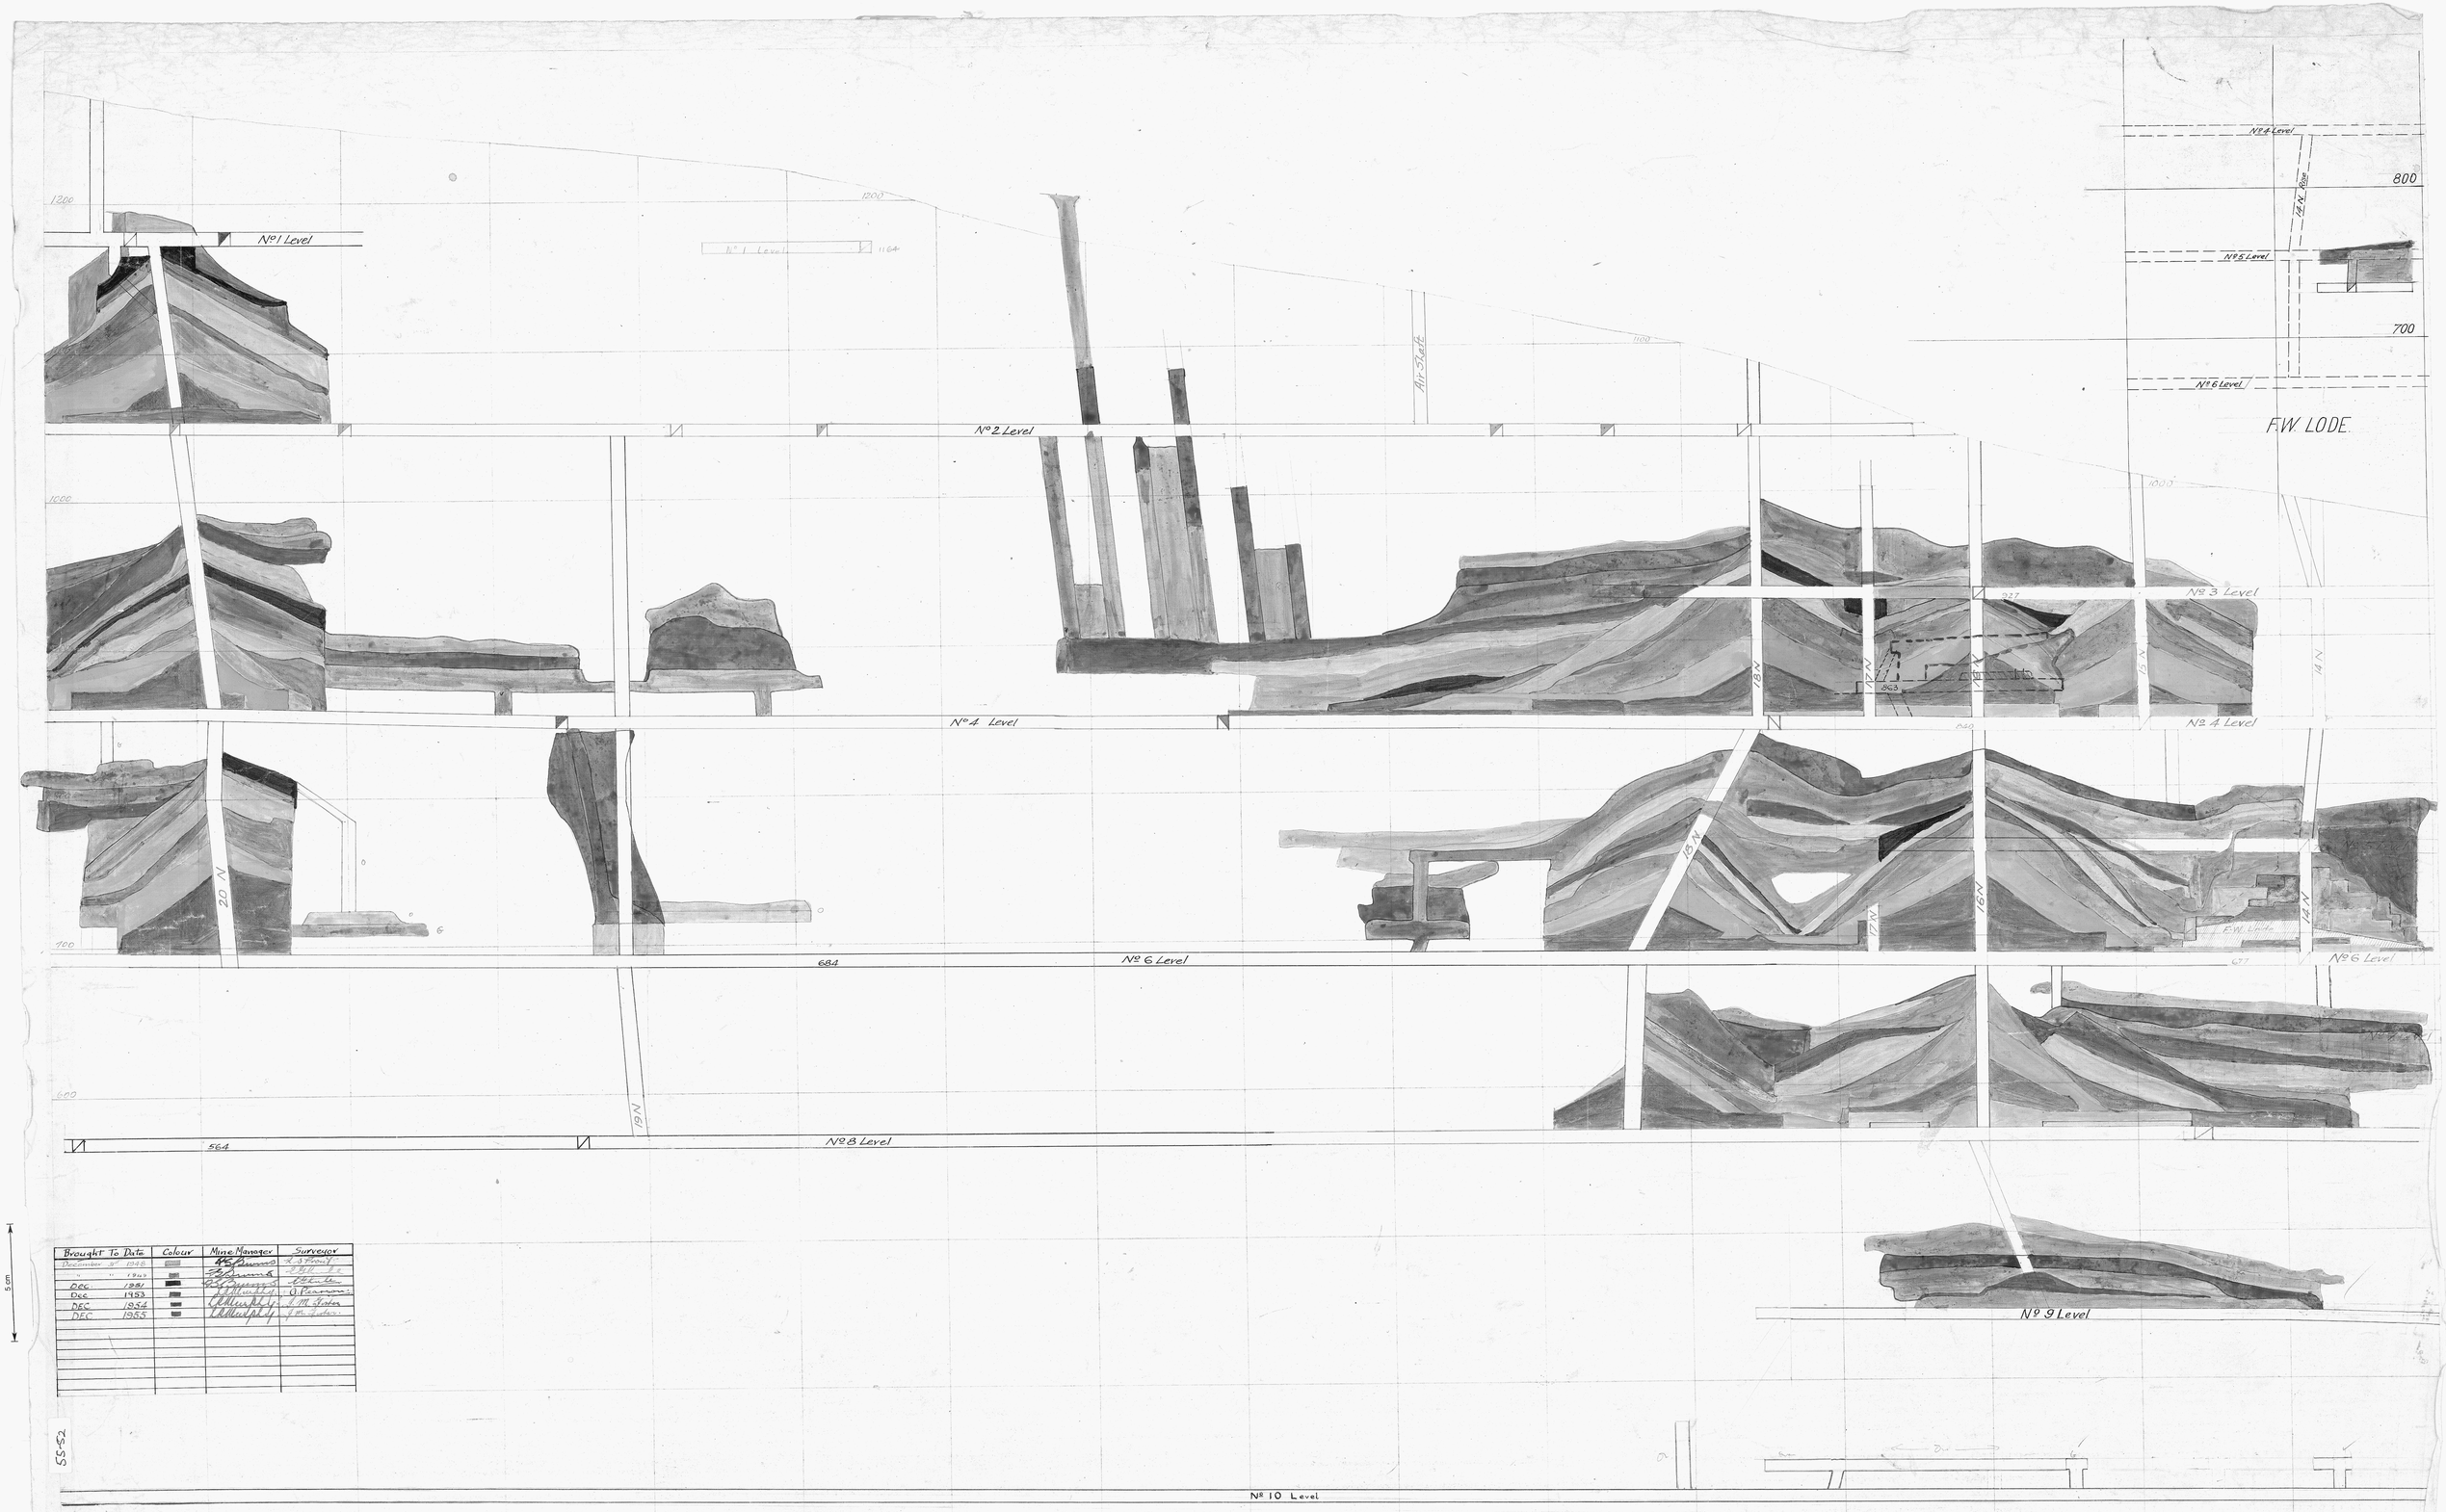

Brought To Date	Colour	Mine Manager	Surveyor
December 31st 1948		[illegible]	[illegible]
" " 1949		[illegible]	[illegible]
DEC 1951		[illegible]	[illegible]
DEC 1953		[illegible]	[illegible]
DEC 1954		[illegible]	[illegible]
DEC 1955		[illegible]	[illegible]

5 cm

55-52



SHEET No 2

Surveyor

WEST COAST WORKS
LONGITUDINAL SECTION
ROSEBERY MINE

ELECTROLYTIC ZINC CO OF AUSTRALASIA LTD
ROSEBERY

SCALE 1 inch = 40 feet

X3R-4