


0555 -
055A

LONGITUDINAL
SECTION

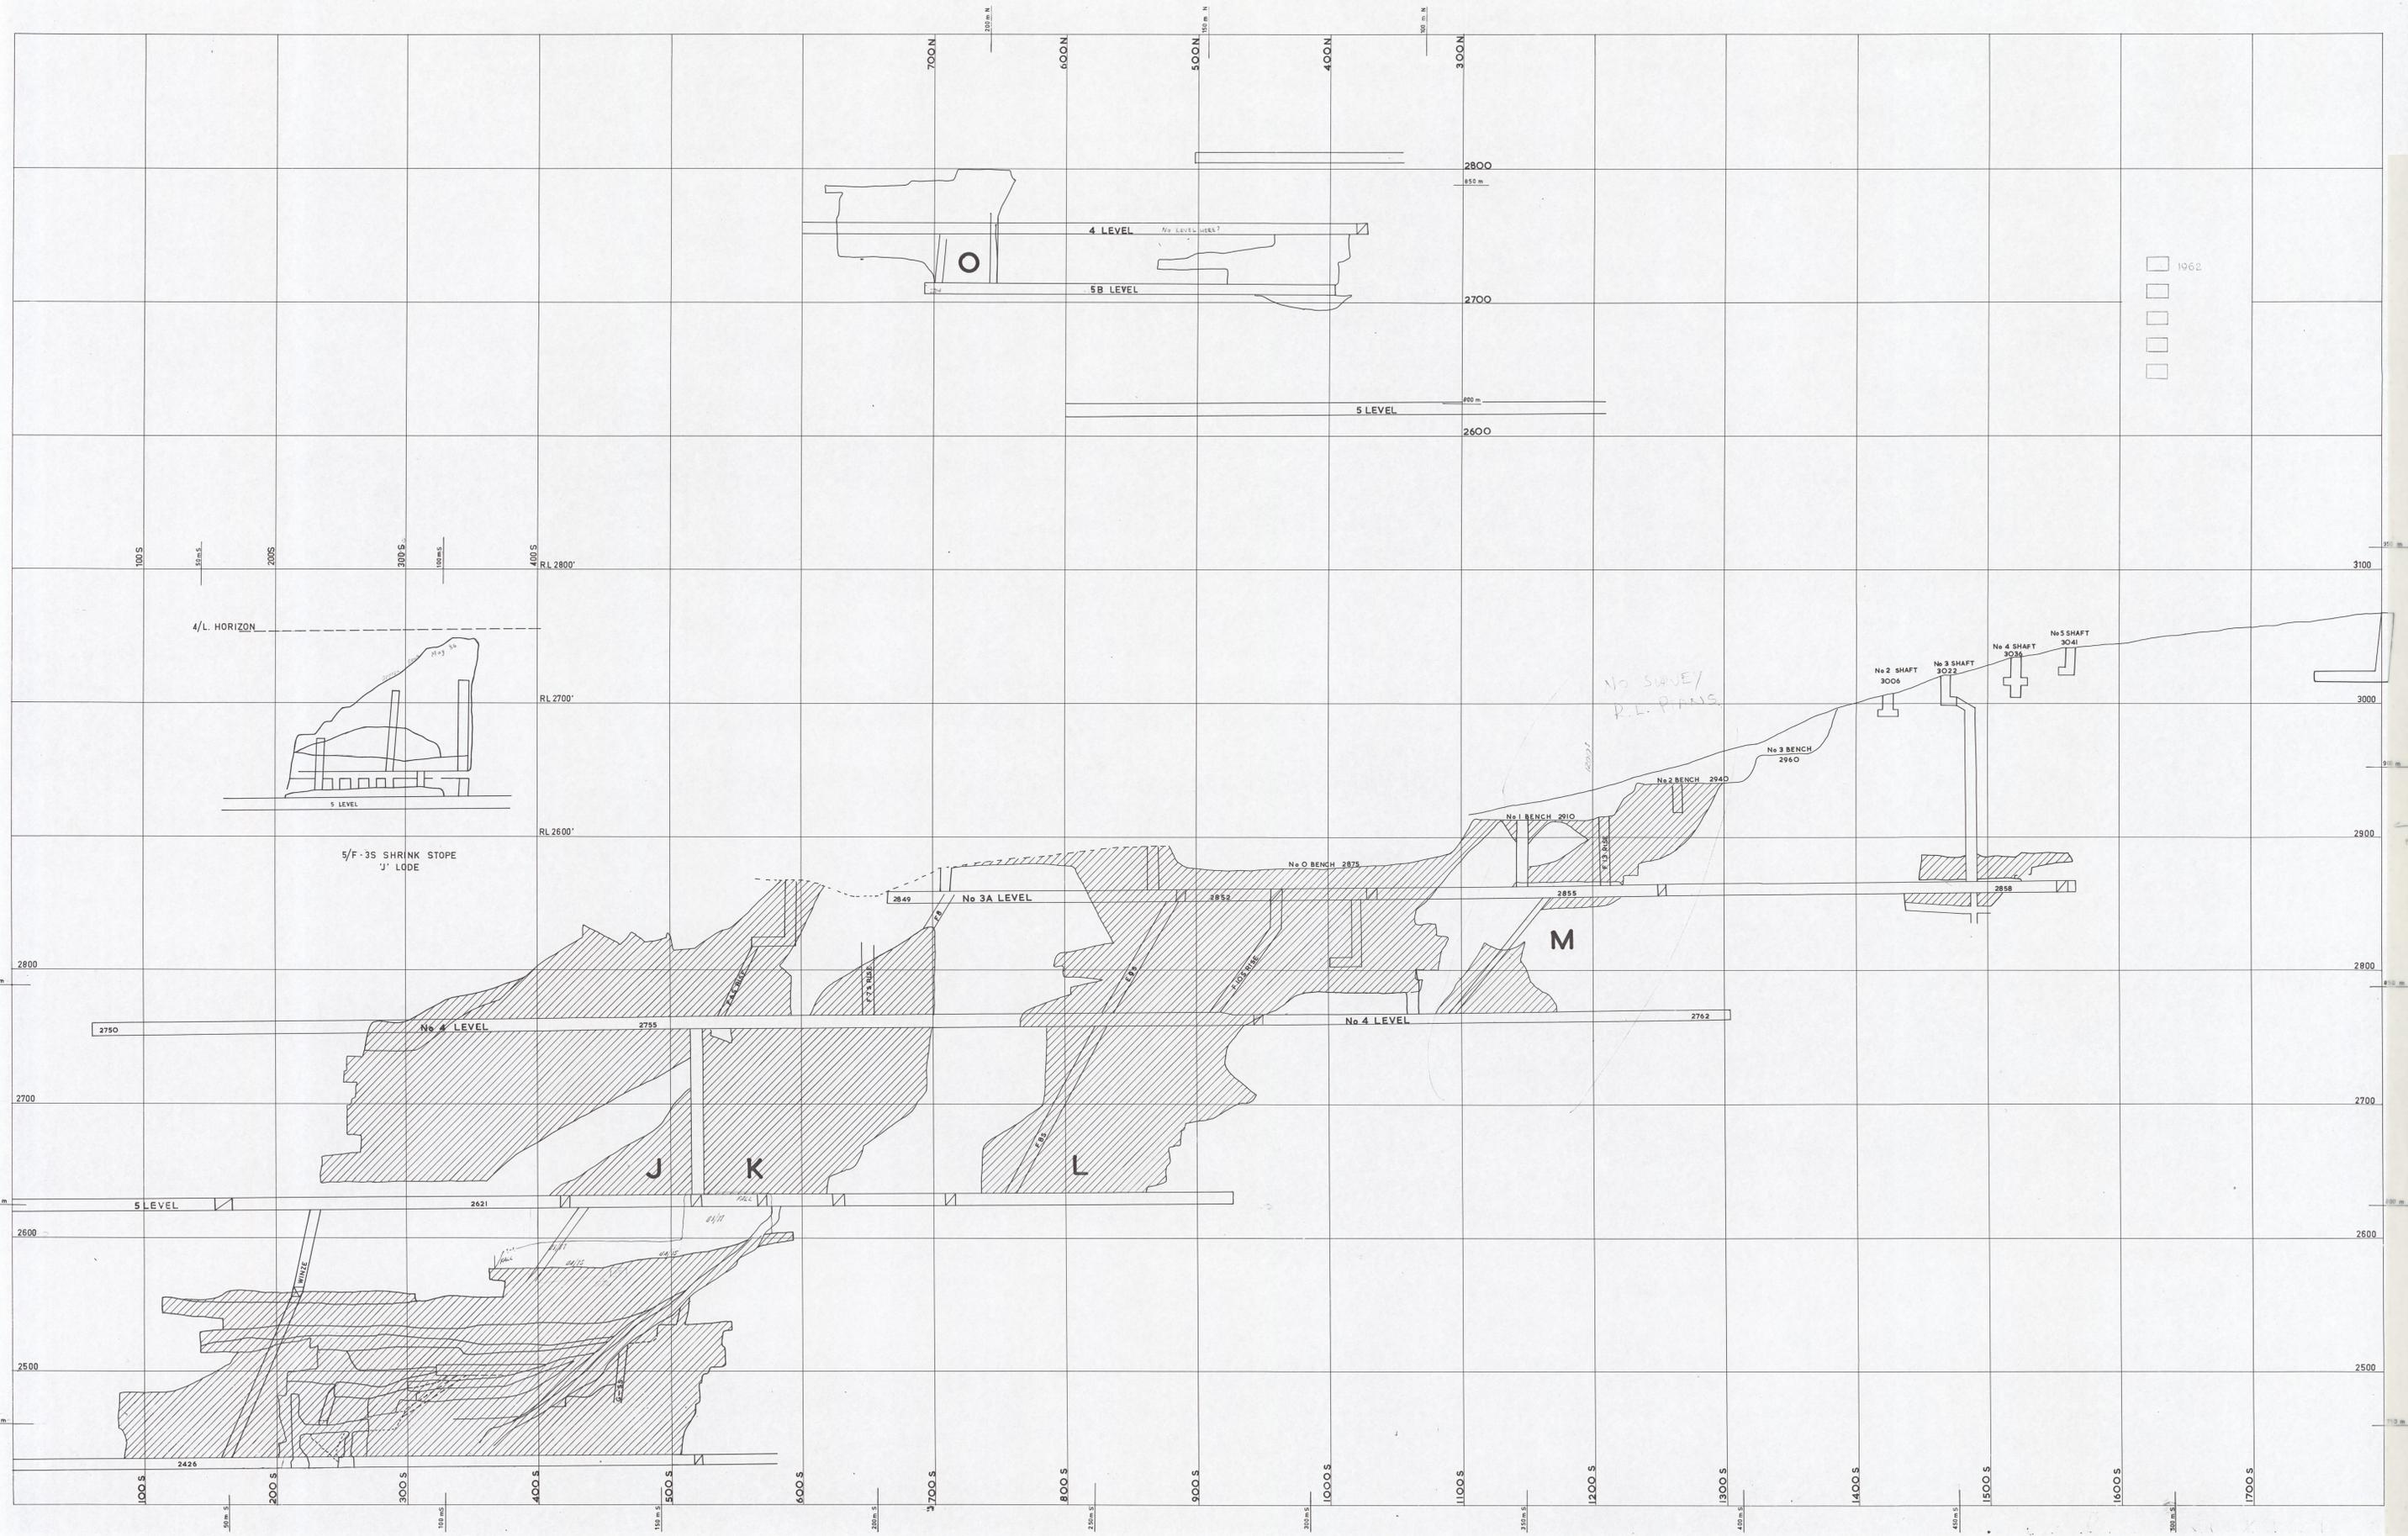

1962

5 cm