55-73

5 cm

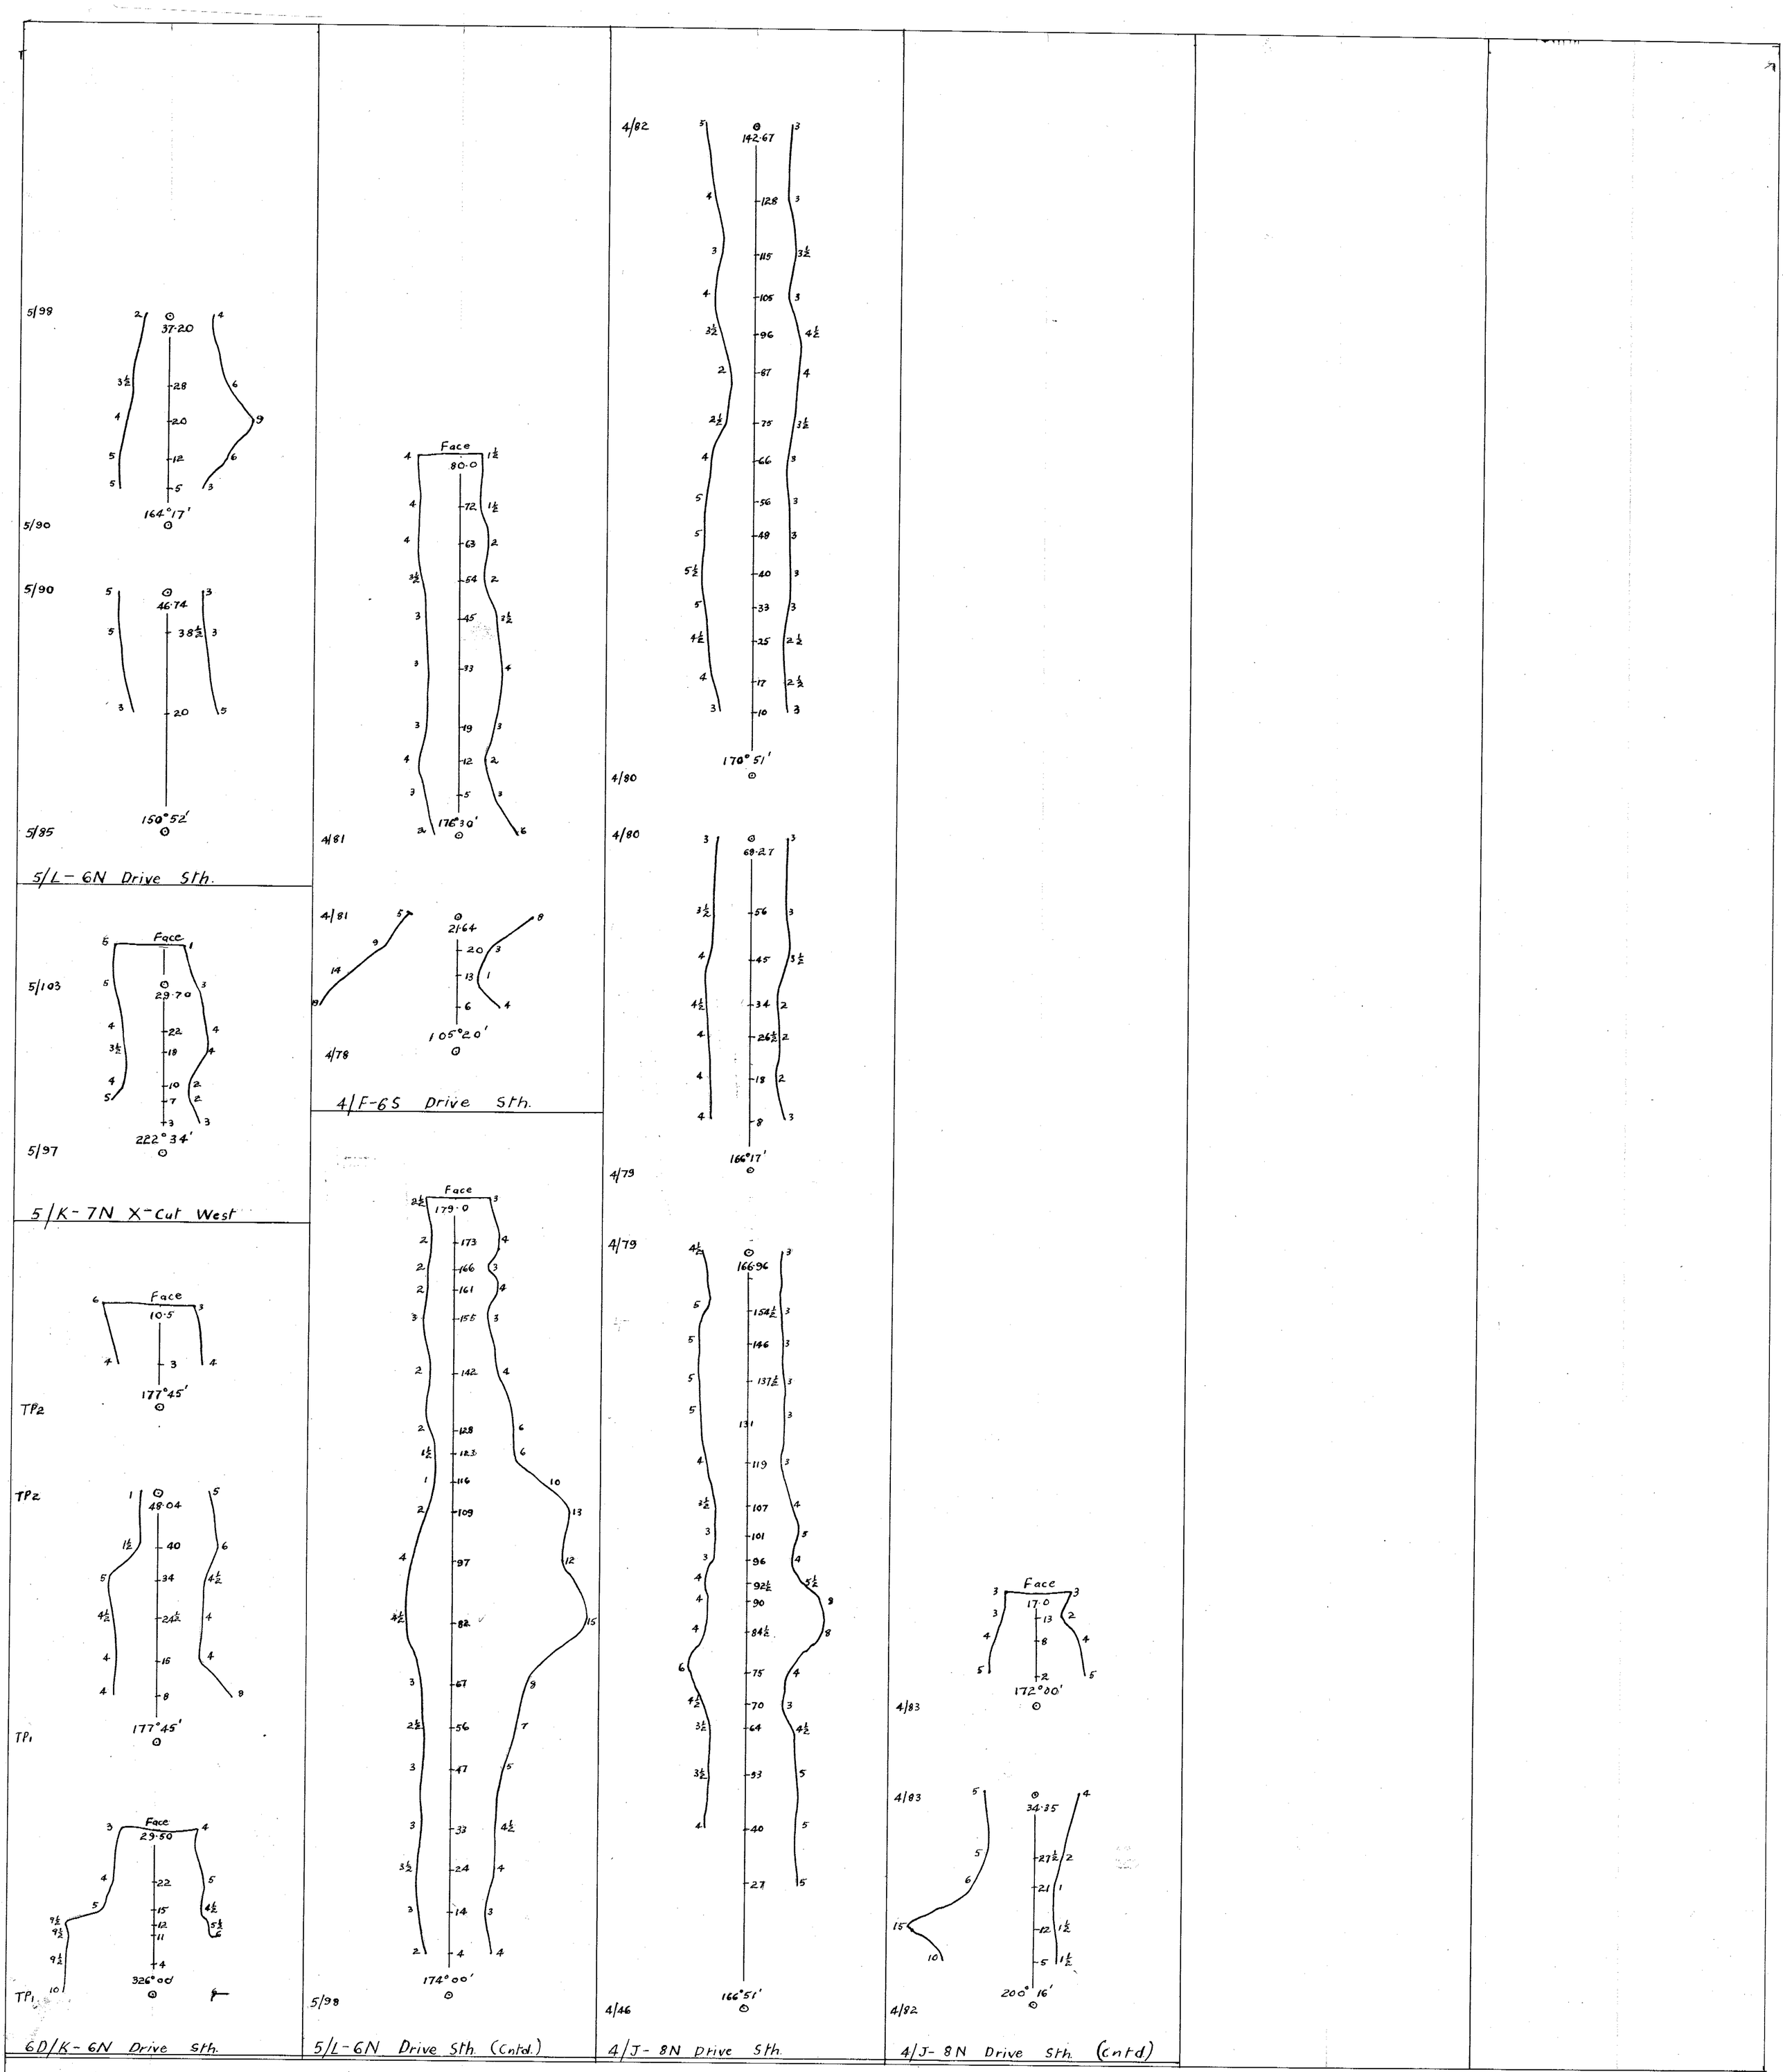

ELECTROLYTIC ZINC COMPANY OF A'SIA. L.T.D.

ROSEBERY & HERCULES MINES.

FIELD NOTES.

MINE MANAGER C.H. Murphy
MINE SURVEYOR J.M. Fisher

BROUGHT UP TO 31 DEC. 1954
WATTS MICROPTIC THEODOLITE B50

SHEET. Nº3.