55-75

5 cm

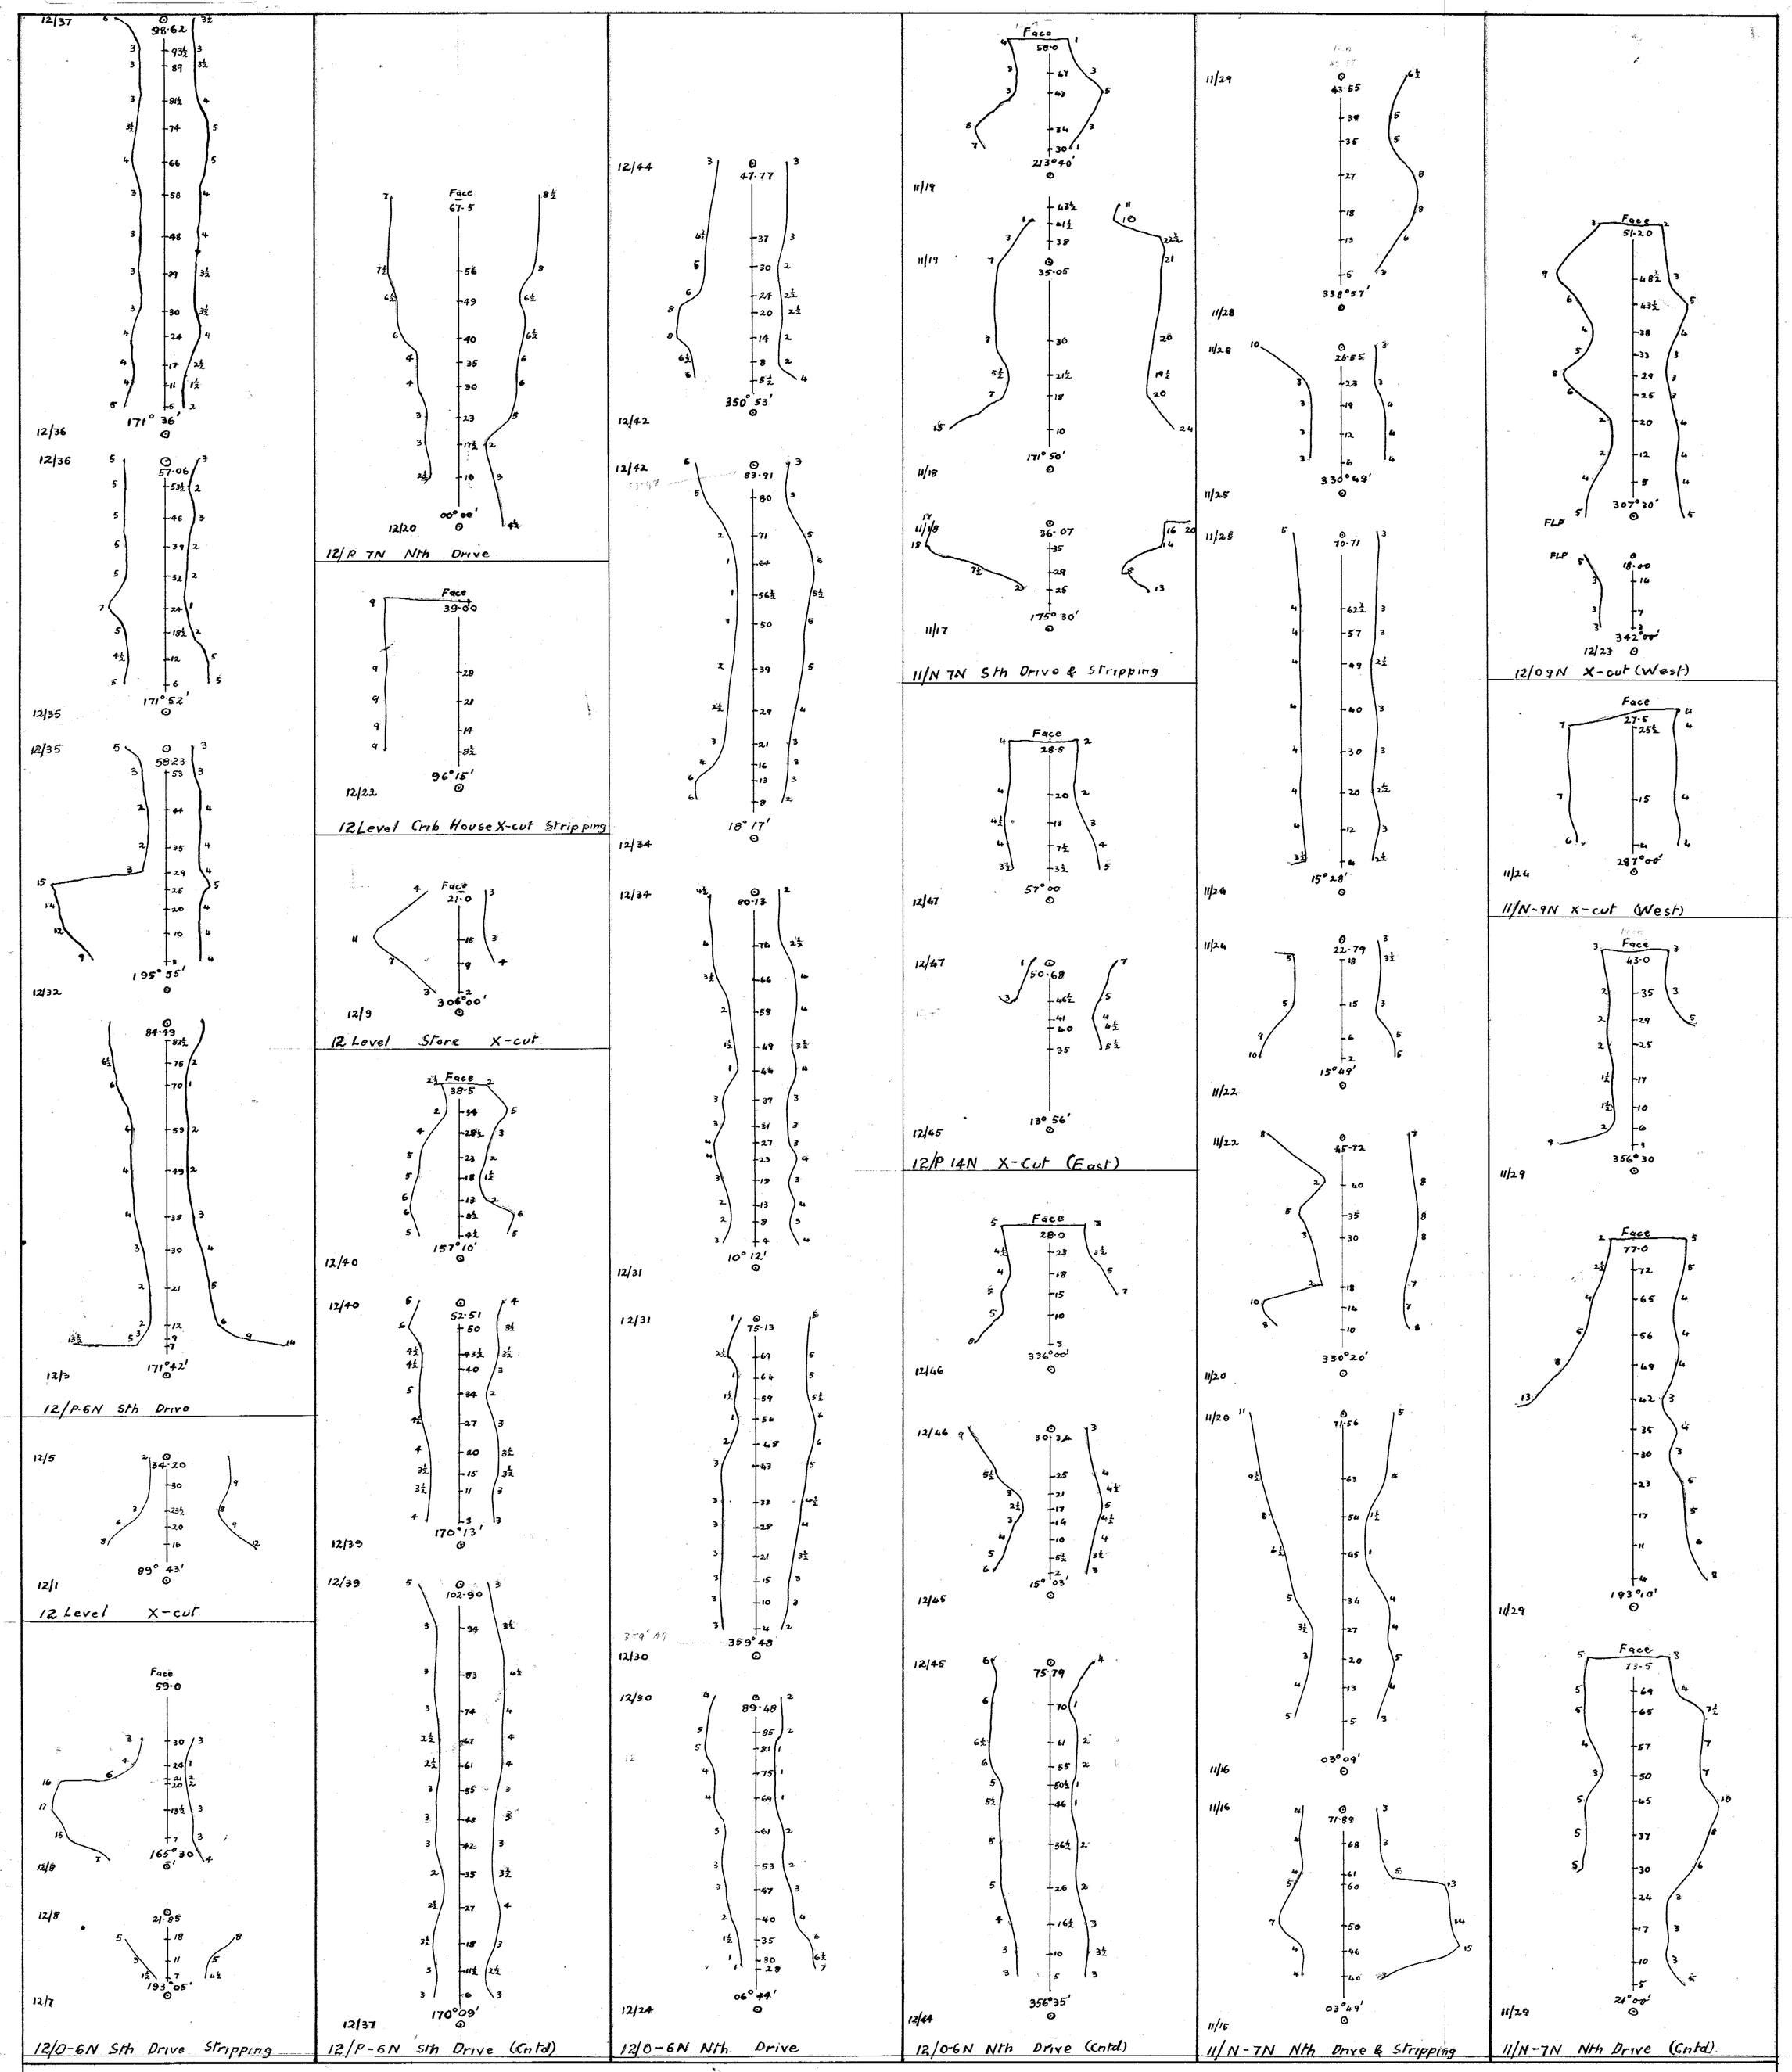


ROSEBERY & HERCULES MINES

FIELD NOTES

MINE MANAGER E.L. Murphy

MINE SURVEYOR J.M. Fisher.

BROUGHT UP TO 31st DEC 1954

WATTS MICROPTIC THEODOLITE B50

SHEET No 1