


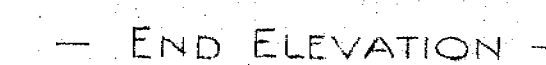

① R.E.D. 27.3.39 ATTACHMENTS ADDED FOR TIMBER TRUCK



$1\frac{1}{2}'' = 1 \text{ FOOT}$

4-3-38
 ROSEBERY MINES
 INCLINED SHAFT
 ARRG. OF 22 TON ORE SKIP
 CONTROLLED BY THE CO.
 OF AUSTRALASIA LTD.
 10-3-38