0055 - 100

ELECTROLYTIC ZINC COMPANY OF AUSTRALASIA LIMITED

WEST COAST MINES A.C.N. 004 074 962 DEPT.

	By	Date
Drawn	G.M. Bennett	20·06·84
Traced		
Checked		
Approved		

ROSEBERY MINE

19 N°. 2 SUB LEVEL

5 cm

SCALE:
DESIGN:
SURVEY:
FILE:
DRAWING No. 1

Revisions

No.	By	Date	Details	App.	No.	By	Date	Details	App.	References	No.

DEPARTMENT OF MINES
BROUGHT TO DATE : 31 DEC 92
MINE MANAGER :
MINE SURVEYOR :

1 2

EZ/MR 8

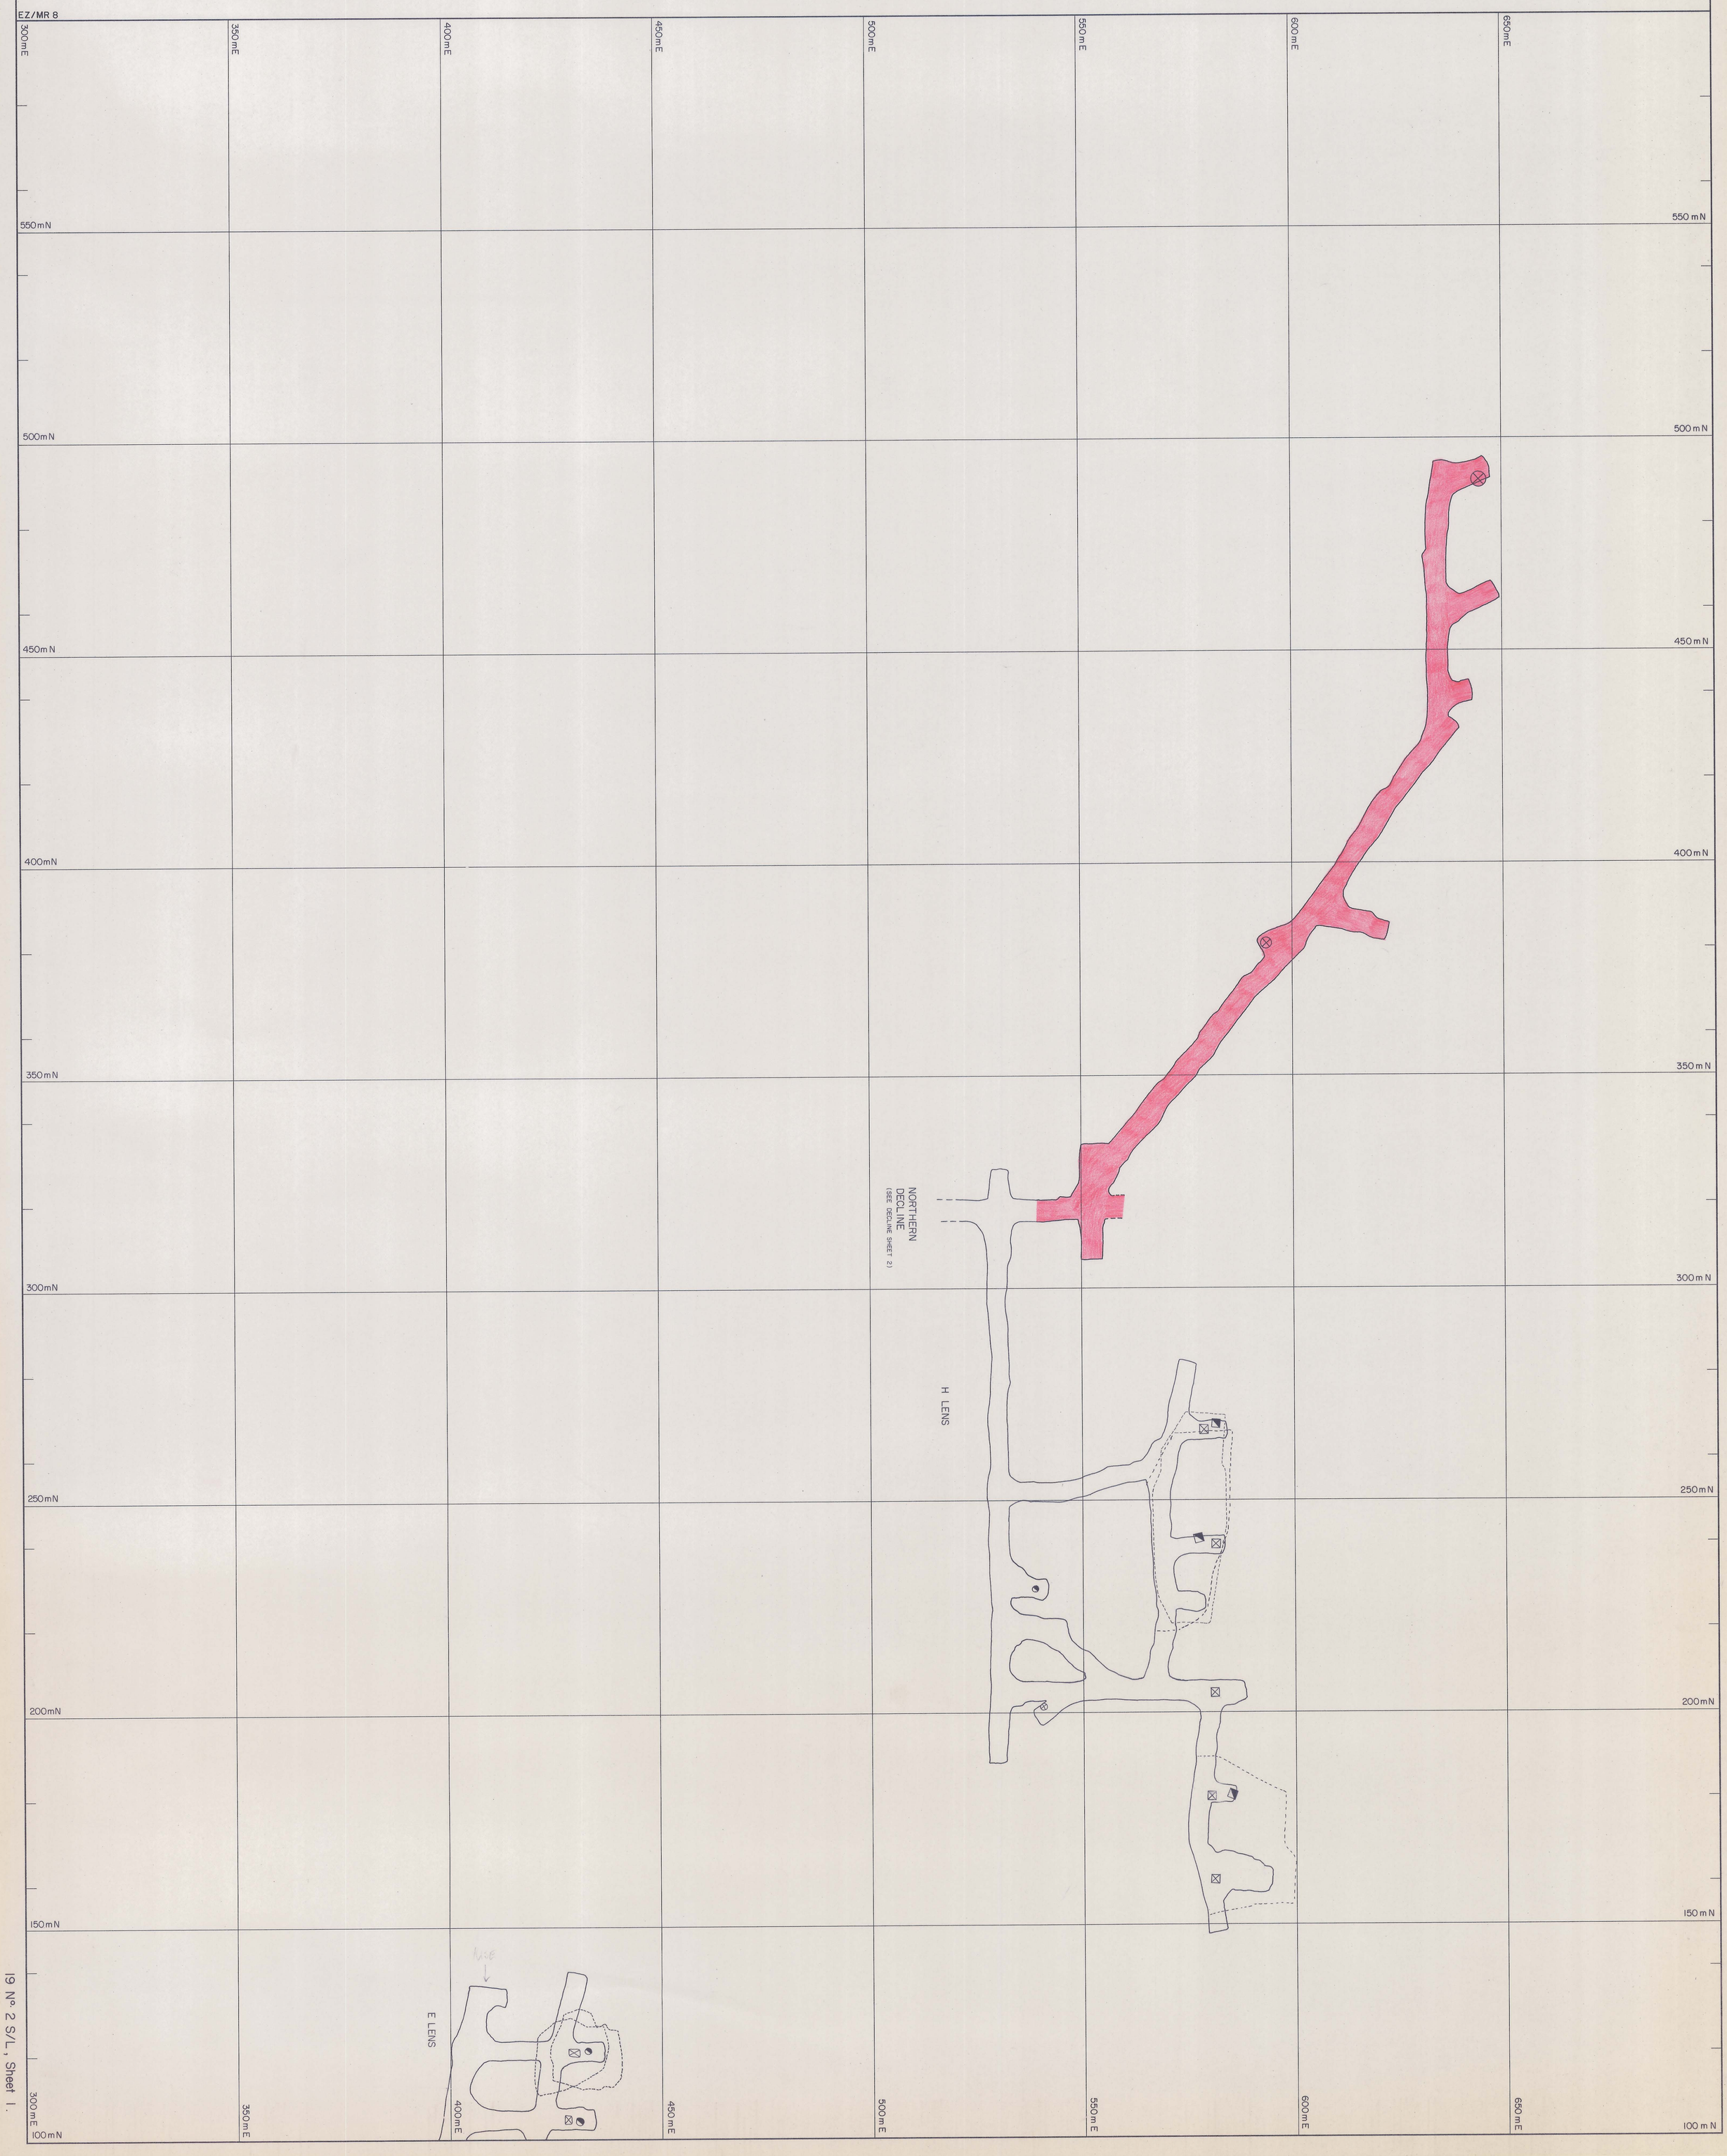

19 N° 2 S/L, Sheet 1.