0055-114

ELECTROLYTIC ZINC COMPANY OF AUSTRALASIA LIMITED

WEST COAST MINES — A.C.N. 004 074 962 — DEPT.

	By	Date
Drawn	P. J. S.	29·05·84
Traced		
Checked		
Approved		

ROSEBERY MINE
LONGITUDINAL PROJECTION
400mS to 100mN – BELOW 17 LEVEL

5 cm

SCALE: 1:500
DESIGN:
SURVEY:
FILE:
DRAWING No.

Revisions

No.	By	Date	Details	App.	No.	By	Date	Details	App.	References	No.

DEPARTMENT OF MINES
BROUGHT TO DATE : 31 DEC 92
MINE MANAGER :
MINE SURVEYOR :
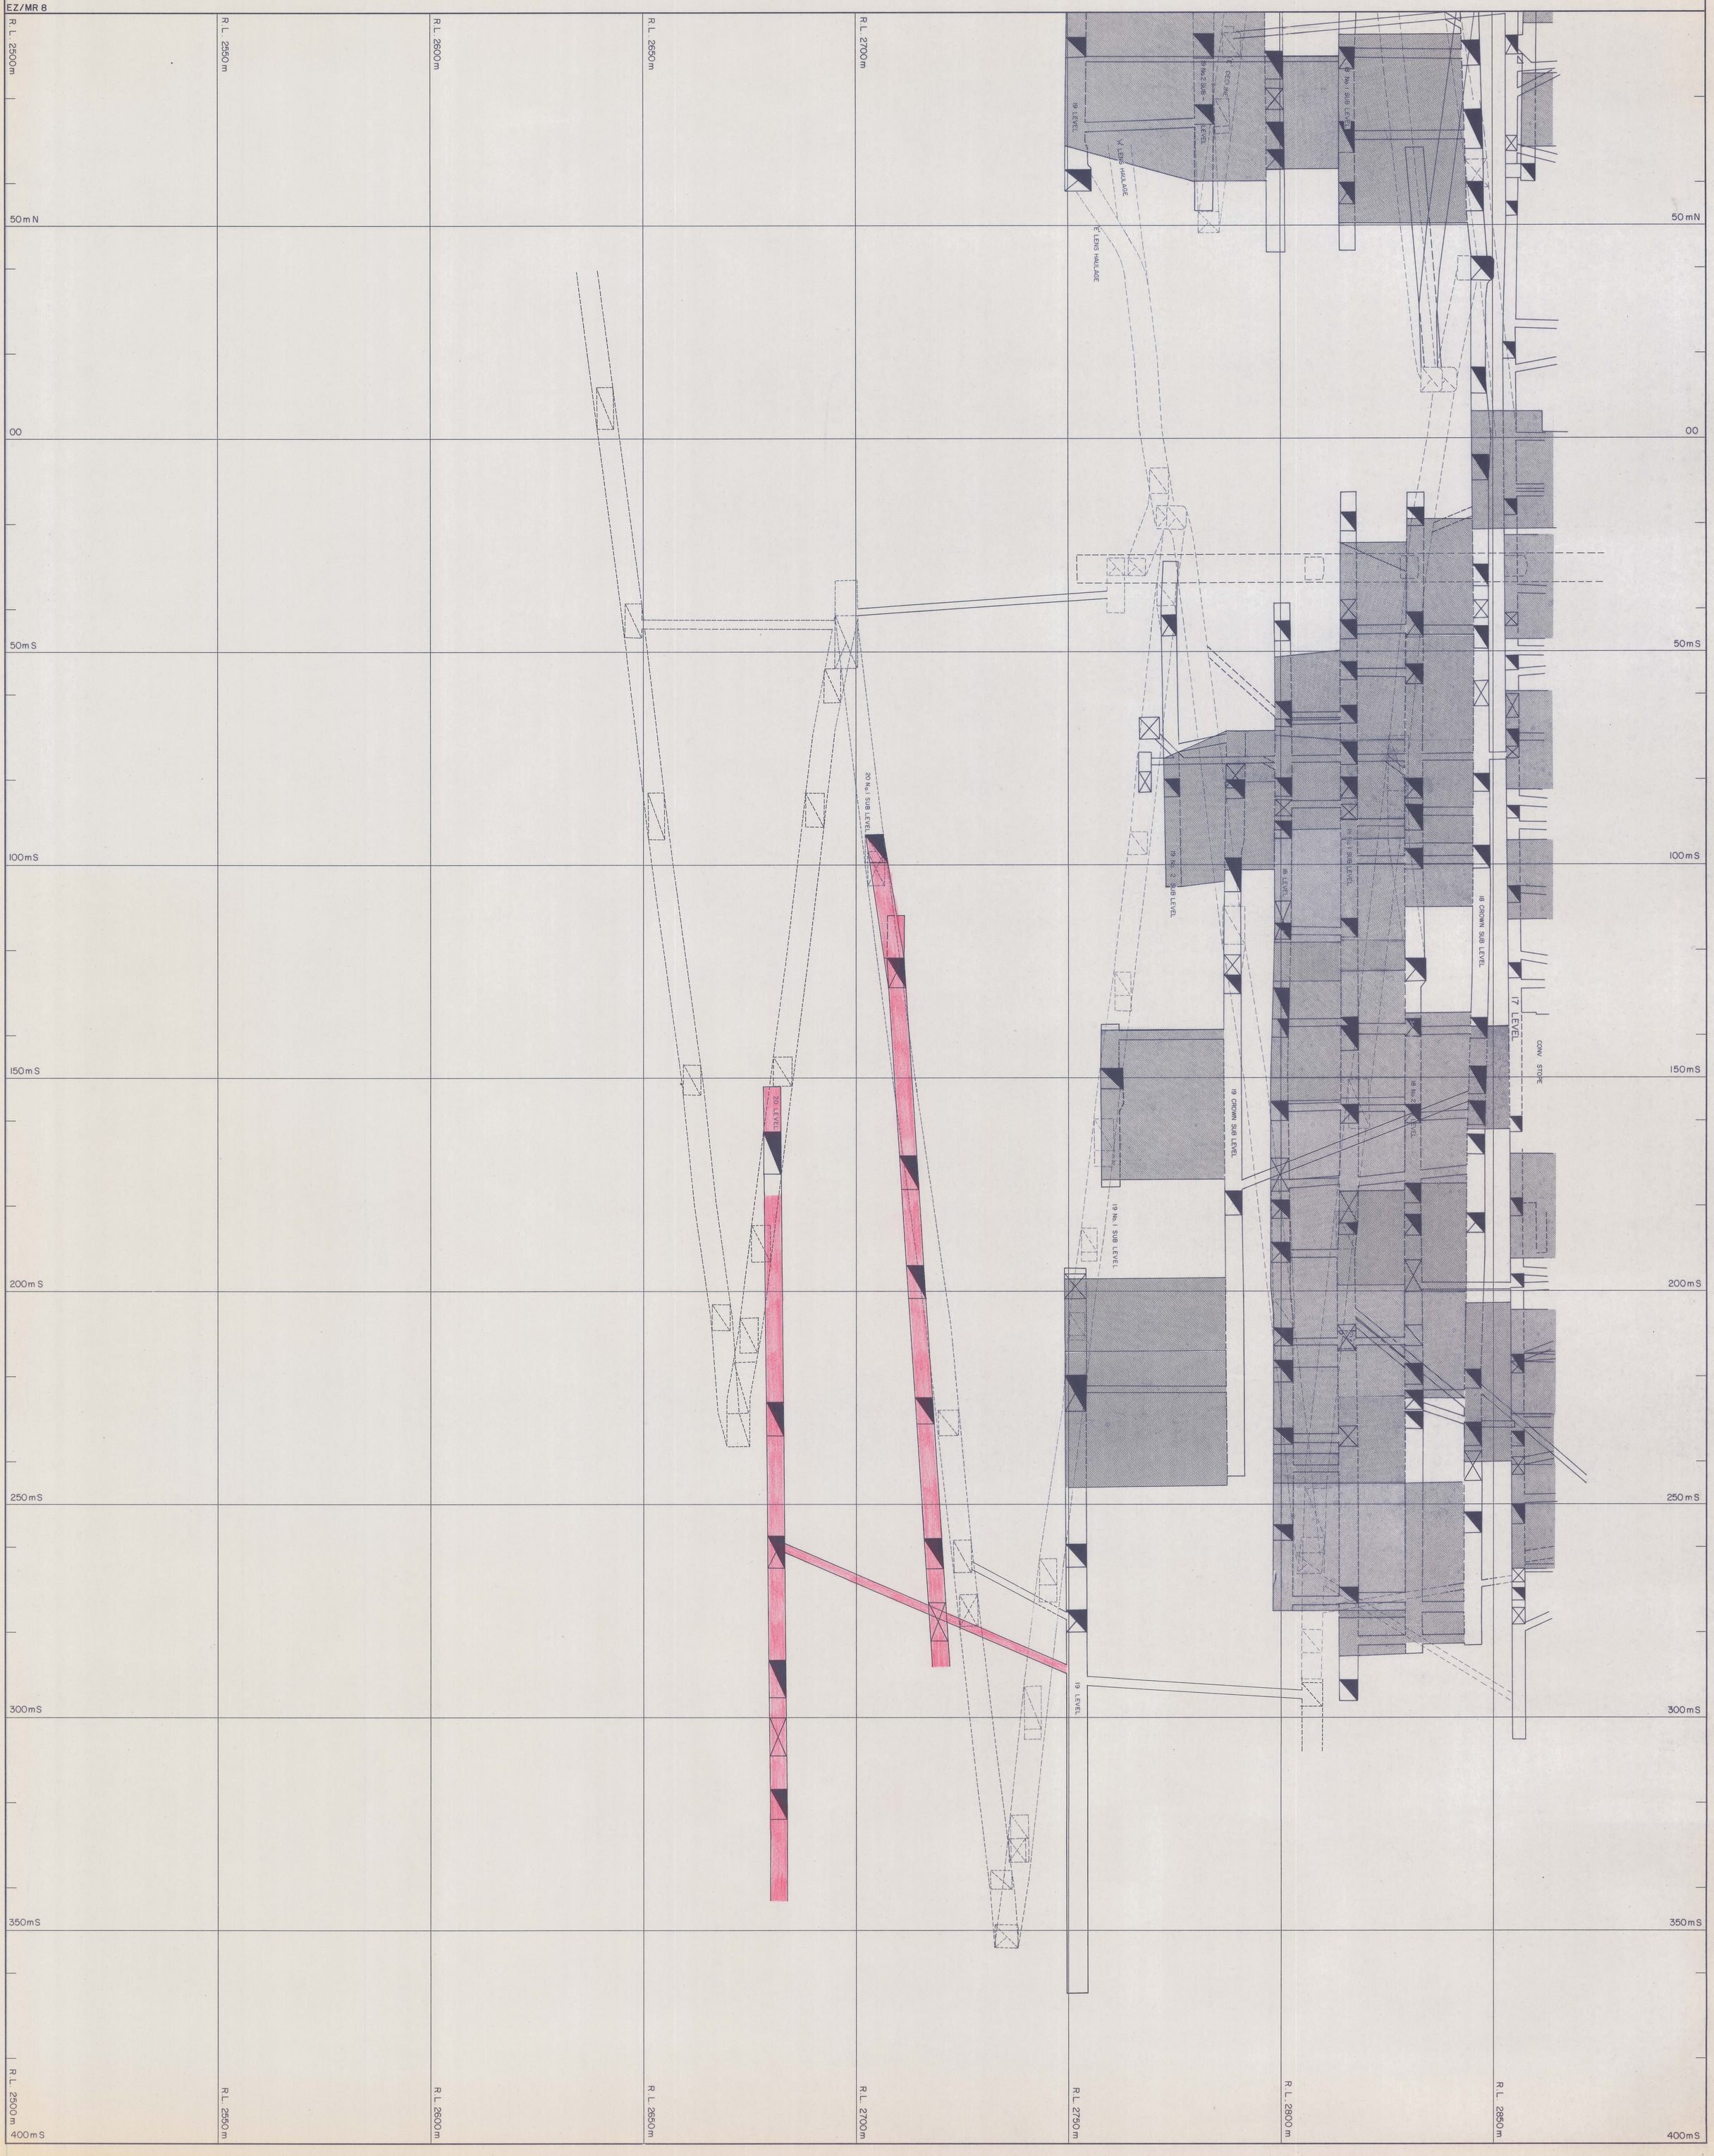
EZ/MR 8