


0055-117

DEPARTMENT OF MINES TASMANIA
 PLANS RECEIVED UNDER SECTION 131 MINES INSPECTION ACT
 A/CARD No. 65012
 ELECTROLYTIC ZINC CO. OF AUSTRALASIA LTD.
 HERCULES - LONGITUDINAL PROJECTION
 CO. Ref. WORKING AT 12/84

BROUGHT TO DATE 31 DEC 1984
 MINE MANAGER *Blair*
 MINE SURVEYOR *W.H.*

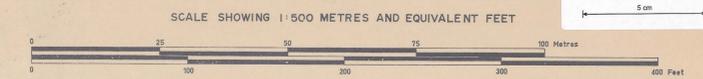

ELECTROLYTIC ZINC COMPANY OF AUSTRALASIA LIMITED
 WEST COAST MINES, T.A.S.

SURVEY BY	SCALE	1 : 500
DRAWN BY	DATE	1973
TRACED BY P.J. Lowe	REFERENCE	

HERCULES MINE
 LONGITUDINAL PROJECTION

DRAWING No.:
 DEPARTMENT OF MINES