



0055 - 12.6

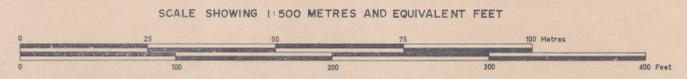

DEPARTMENT OF MINES TASMANIA
 PLANS RECEIVED UNDER SECTION 311 MINES INSPECTION ACT
 A/CARD NO. 35022
 ELECTROLYTIC ZINC CO. OF AUSTRALIA, LTD.
 ROSEBERY No. 16 LEVEL - 1
 Co. Ref. WORKINGS AT 12/84

DEPARTMENT OF MINES
 BROUGHT TO DATE 31 DEC 1984
 MINE MANAGER *[Signature]*
 MINE SURVEYOR *[Signature]*

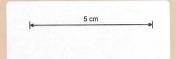

ELECTROLYTIC ZINC COMPANY OF AUSTRALASIA LIMITED
 WEST COAST MINES, T.A.S.

SURVEY BY	SCALE	1:500
DRAWN BY	DATE	1978
TRACED BY A.G.M.	REFERENCE	

ROSEBERY MINE
 No. 16 LEVEL ①

