0055 - 130

ELECTROLYTIC ZINC COMPANY OF AUSTRALASIA LIMITED

WEST COAST MINES DEPT.

	By	Date
Drawn	G.M. Bennett	28·05·84
Traced		
Checked		
Approved		

ROSEBERY MINE

18 LEVEL

SCALE:
DESIGN:
SURVEY:
FILE:
DRAWING No. 1

Revisions

No.	By	Date	Details	App.	No.	By	Date	Details	App.	References	No.

DEPARTMENT OF MINES
BROUGHT TO DATE : 31 DEC 1984
MINE MANAGER :
MINE SURVEYOR :

2

EZ/MR 8

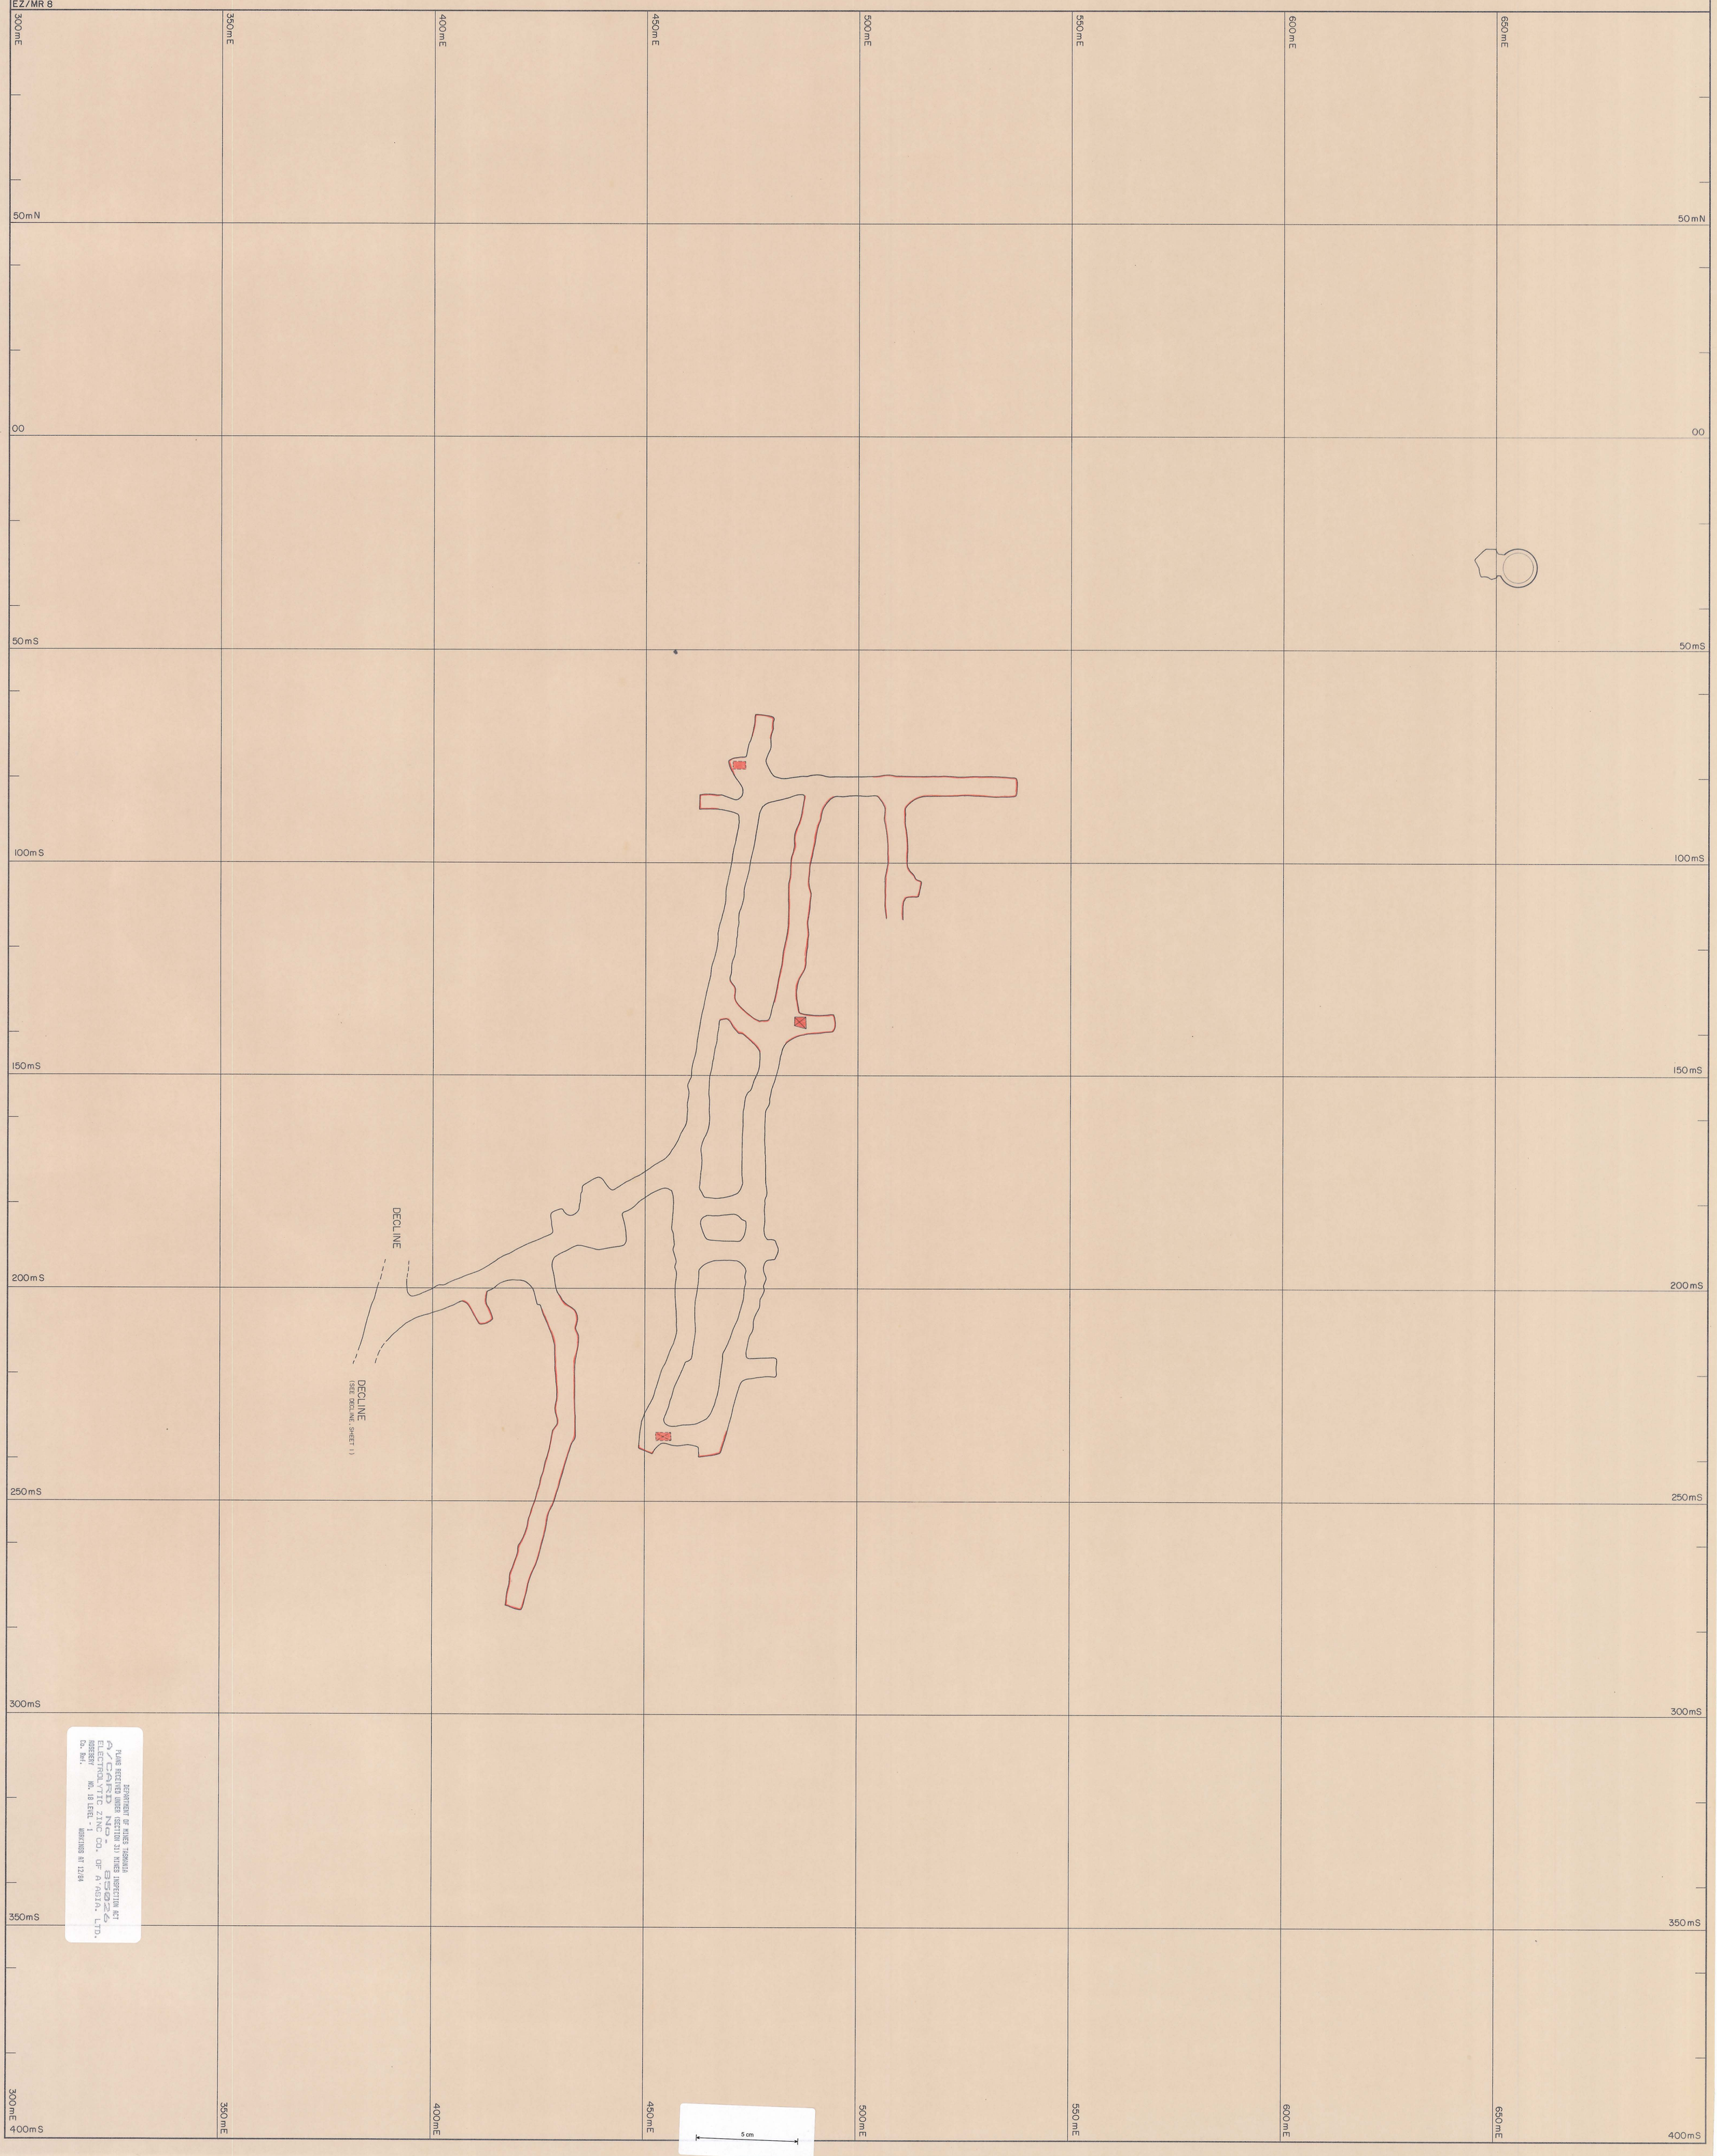

DEPARTMENT OF MINES TASMANIA
PLANS RECEIVED UNDER SECTION 31 MINES INSPECTION ACT
AYCARD NO. 85026
ELECTROLYTIC ZINC CO. OF A'ASIA. LTD.
ROSEBERY NO. 18 LEVEL 1 WORKINGS AT 12/84
Co. Ref.

18 1 FVF1 . Sheet 1