
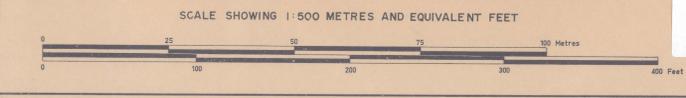


0055-144

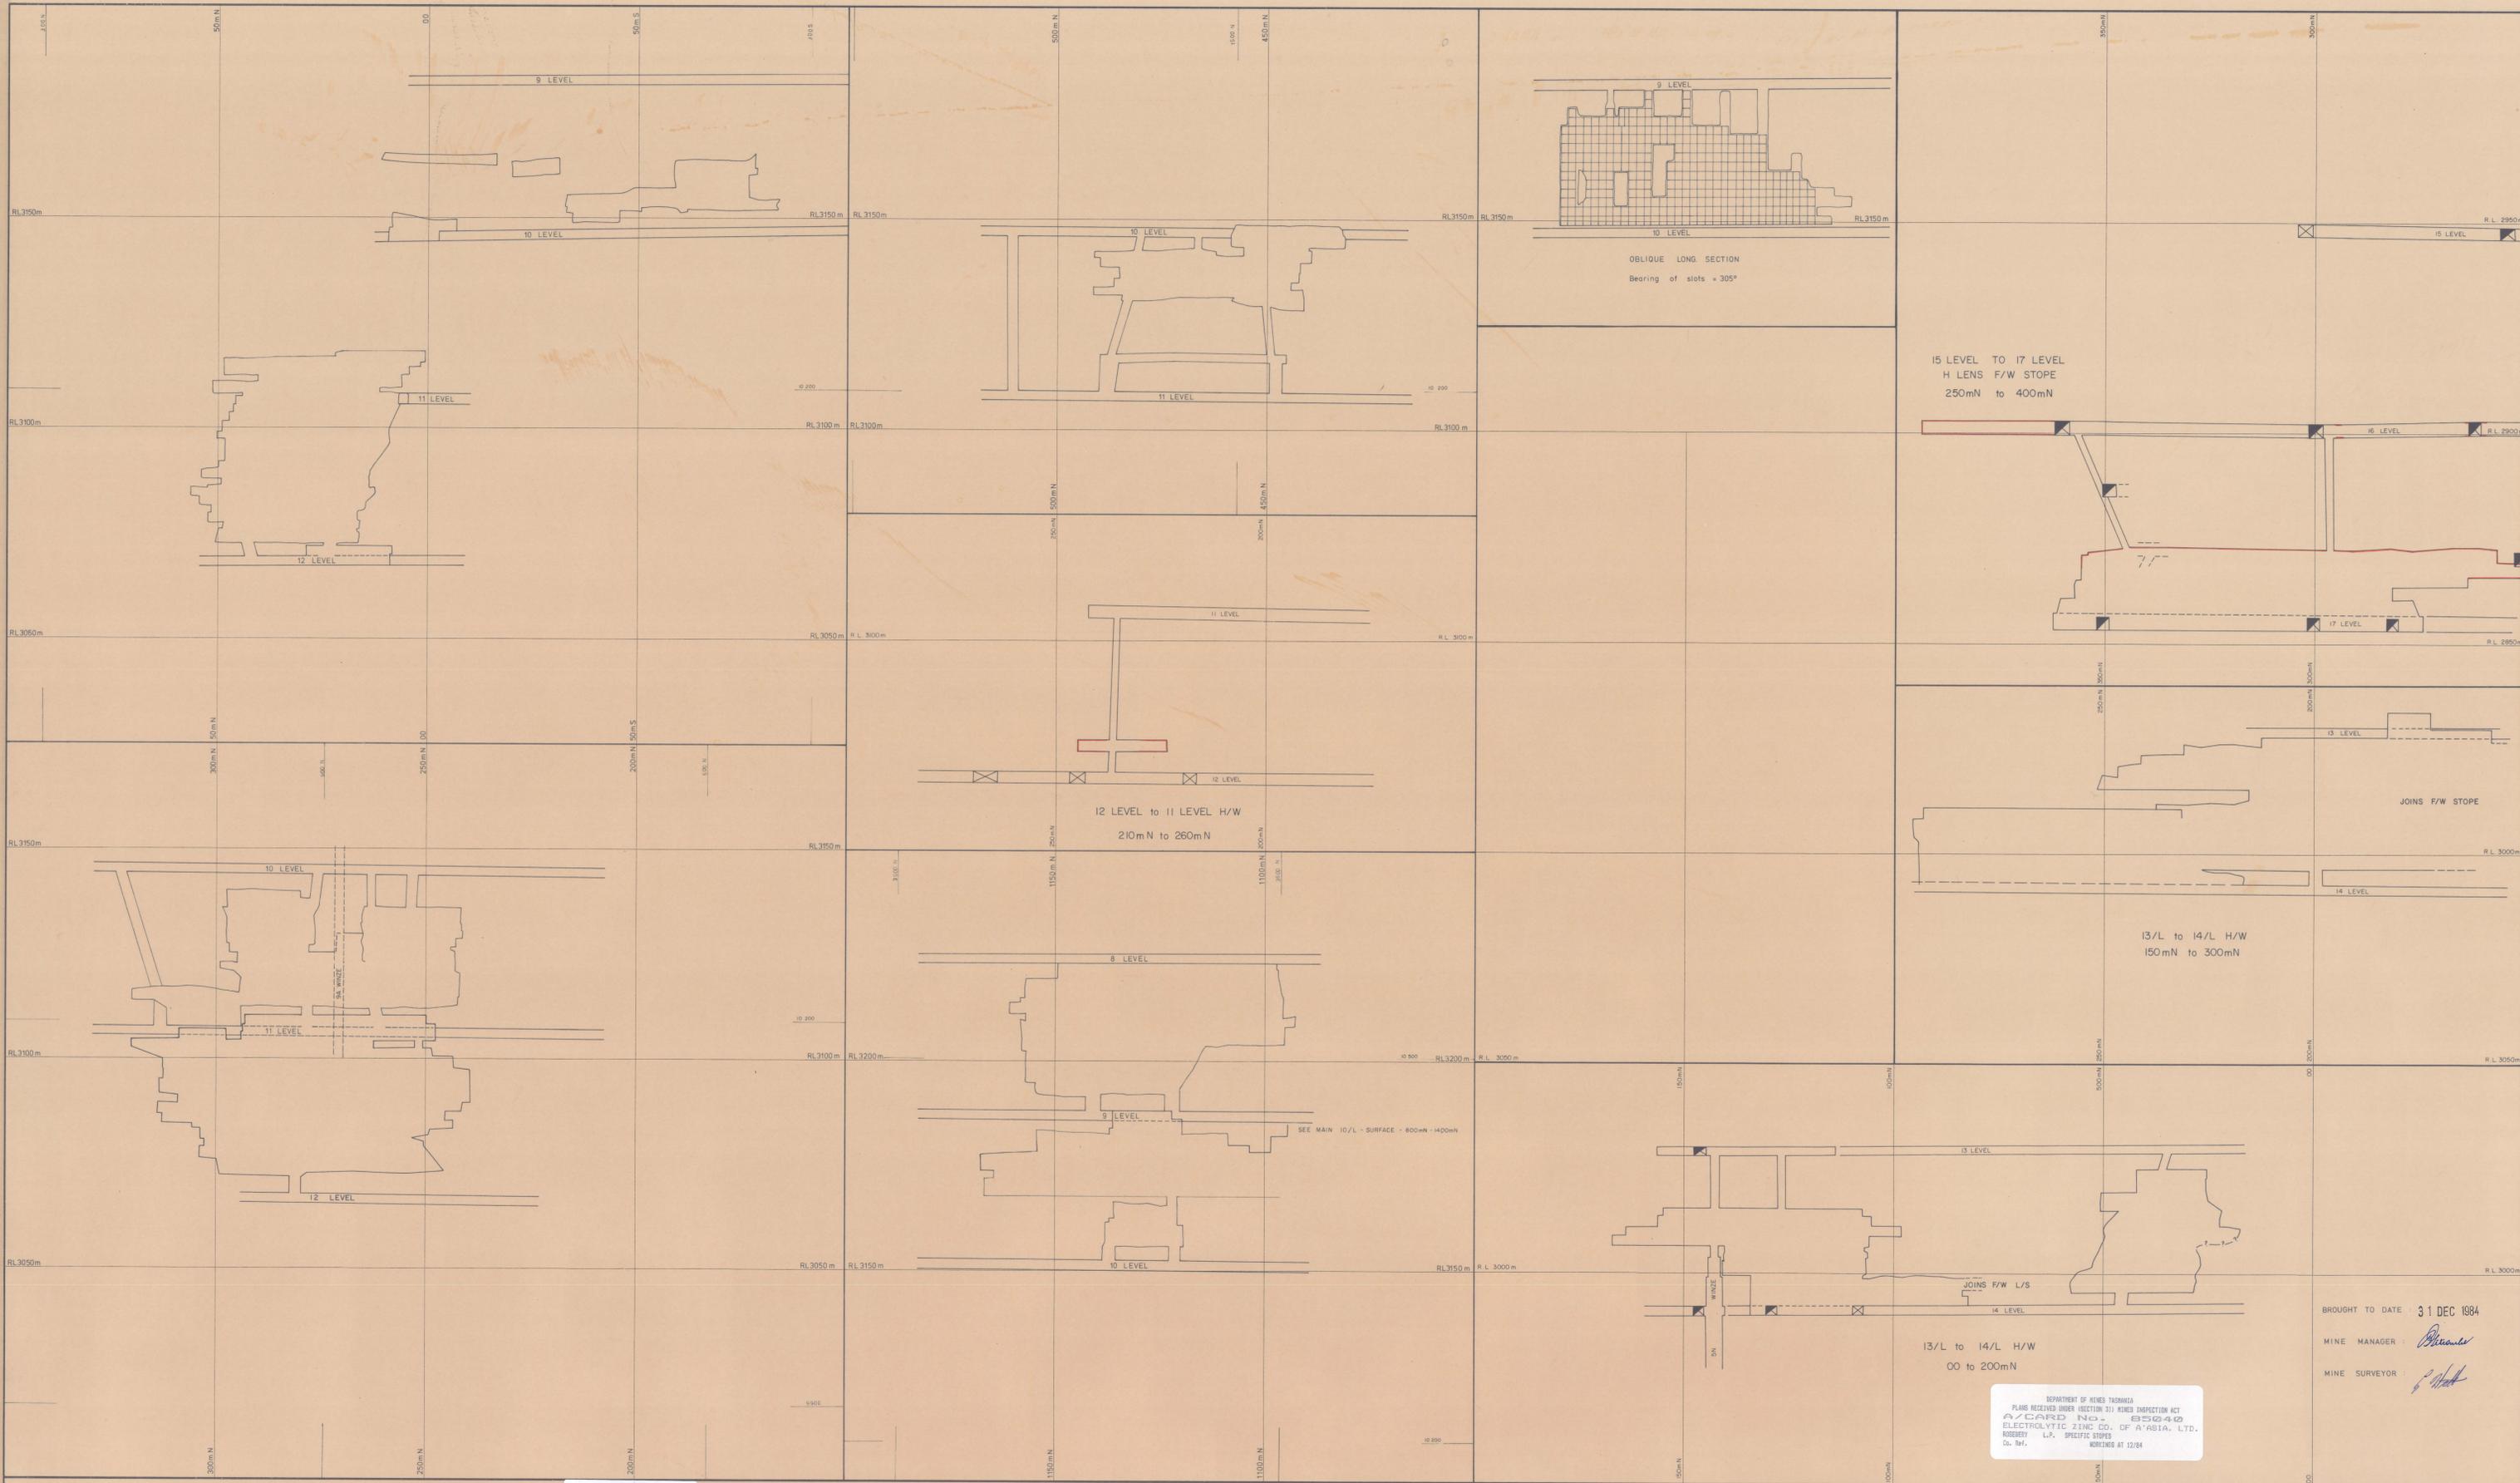

ELECTROLYTIC ZINC COMPANY OF AUSTRALASIA LIMITED
WEST COAST MINES, T.A.S.

| | | | |
|-----------|------------|-----------|---------|
| SURVEY BY | | SCALE | 1 : 500 |
| DRAWN BY | | DATE | 1973 |
| TRACED BY | P. J. Lowe | REFERENCE | |

ROSEBERY MINE
LONGITUDINAL PROJECTION
SPECIFIC STOPES

DRAWING N^o:
DEPARTMENT OF MINES

DEPARTMENT OF MINES TASMANIA
ELECTROLYTIC ZINC CO. OF AUSTRALASIA, LTD.
ROSEBERY L.P. SPECIFIC STOPES
WORKING AT 12/84

BROUGHT TO DATE 31 DEC 1984
MINE MANAGER: *[Signature]*
MINE SURVEYOR: *[Signature]*