


COSS-147

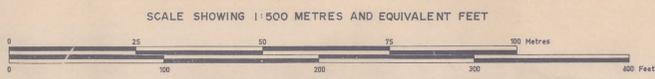

ELECTROLYTIC ZINC COMPANY OF AUSTRALASIA LIMITED
WEST COAST MINES, T.A.S.

SURVEY BY	SCALE	1:500 metres
DRAWN BY	DATE	1973
TRACED BY S.M. Burrows	REFERENCE	

ROSEBERY MINE
LONGITUDINAL PROJECTION
400m S-200m N — BELOW 10/L

DRAWING NO: _____
DEPARTMENT OF MINES

DEPARTMENT OF MINES TASMANIA
PLANS RECEIVED UNDER SECTION 311 MINES INSPECTION ACT
A/CARD NO. 6543
ELECTROLYTIC ZINC CO. OF AUSTRALASIA, LTD.
ROSEBERY L.P. 400m S-200m N BELOW 10 LEVEL
Co. Ref. WORKINGS AT 12/84

BROUGHT TO DATE 31 DEC 1984
MINE MANAGER: *Boon*
MINE SURVEYOR: *Wid*

BULK STOPES MINED

