


0095 - 169

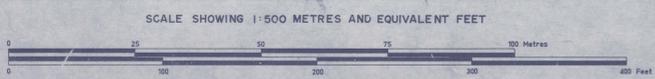

ELECTROLYTIC ZINC COMPANY OF AUSTRALASIA LIMITED
 WEST COAST MINES, T.A.S.
 A.C.N. 004 074 962

SURVEY BY	SCALE	1:500 metres
DRAWN BY	DATE	1973
TRACED BY	REFERENCE	S.M. Burrows

ROSEBERY MINE
 LONGITUDINAL PROJECTION
 400mS-200mN - BELOW 10/L

BROUGHT TO DATE: 31 DEC 1983
 MINE MANAGER: *Baring*
 MINE SURVEYOR: *[Signature]*

DRAWING N^o:
 DEPARTMENT OF MINES